C.S. 3911

SURVEY IN
GATHERCOALS 2nd ADDITION
Benton County, Oregon
Scale: 1"=40' April 23, 1964
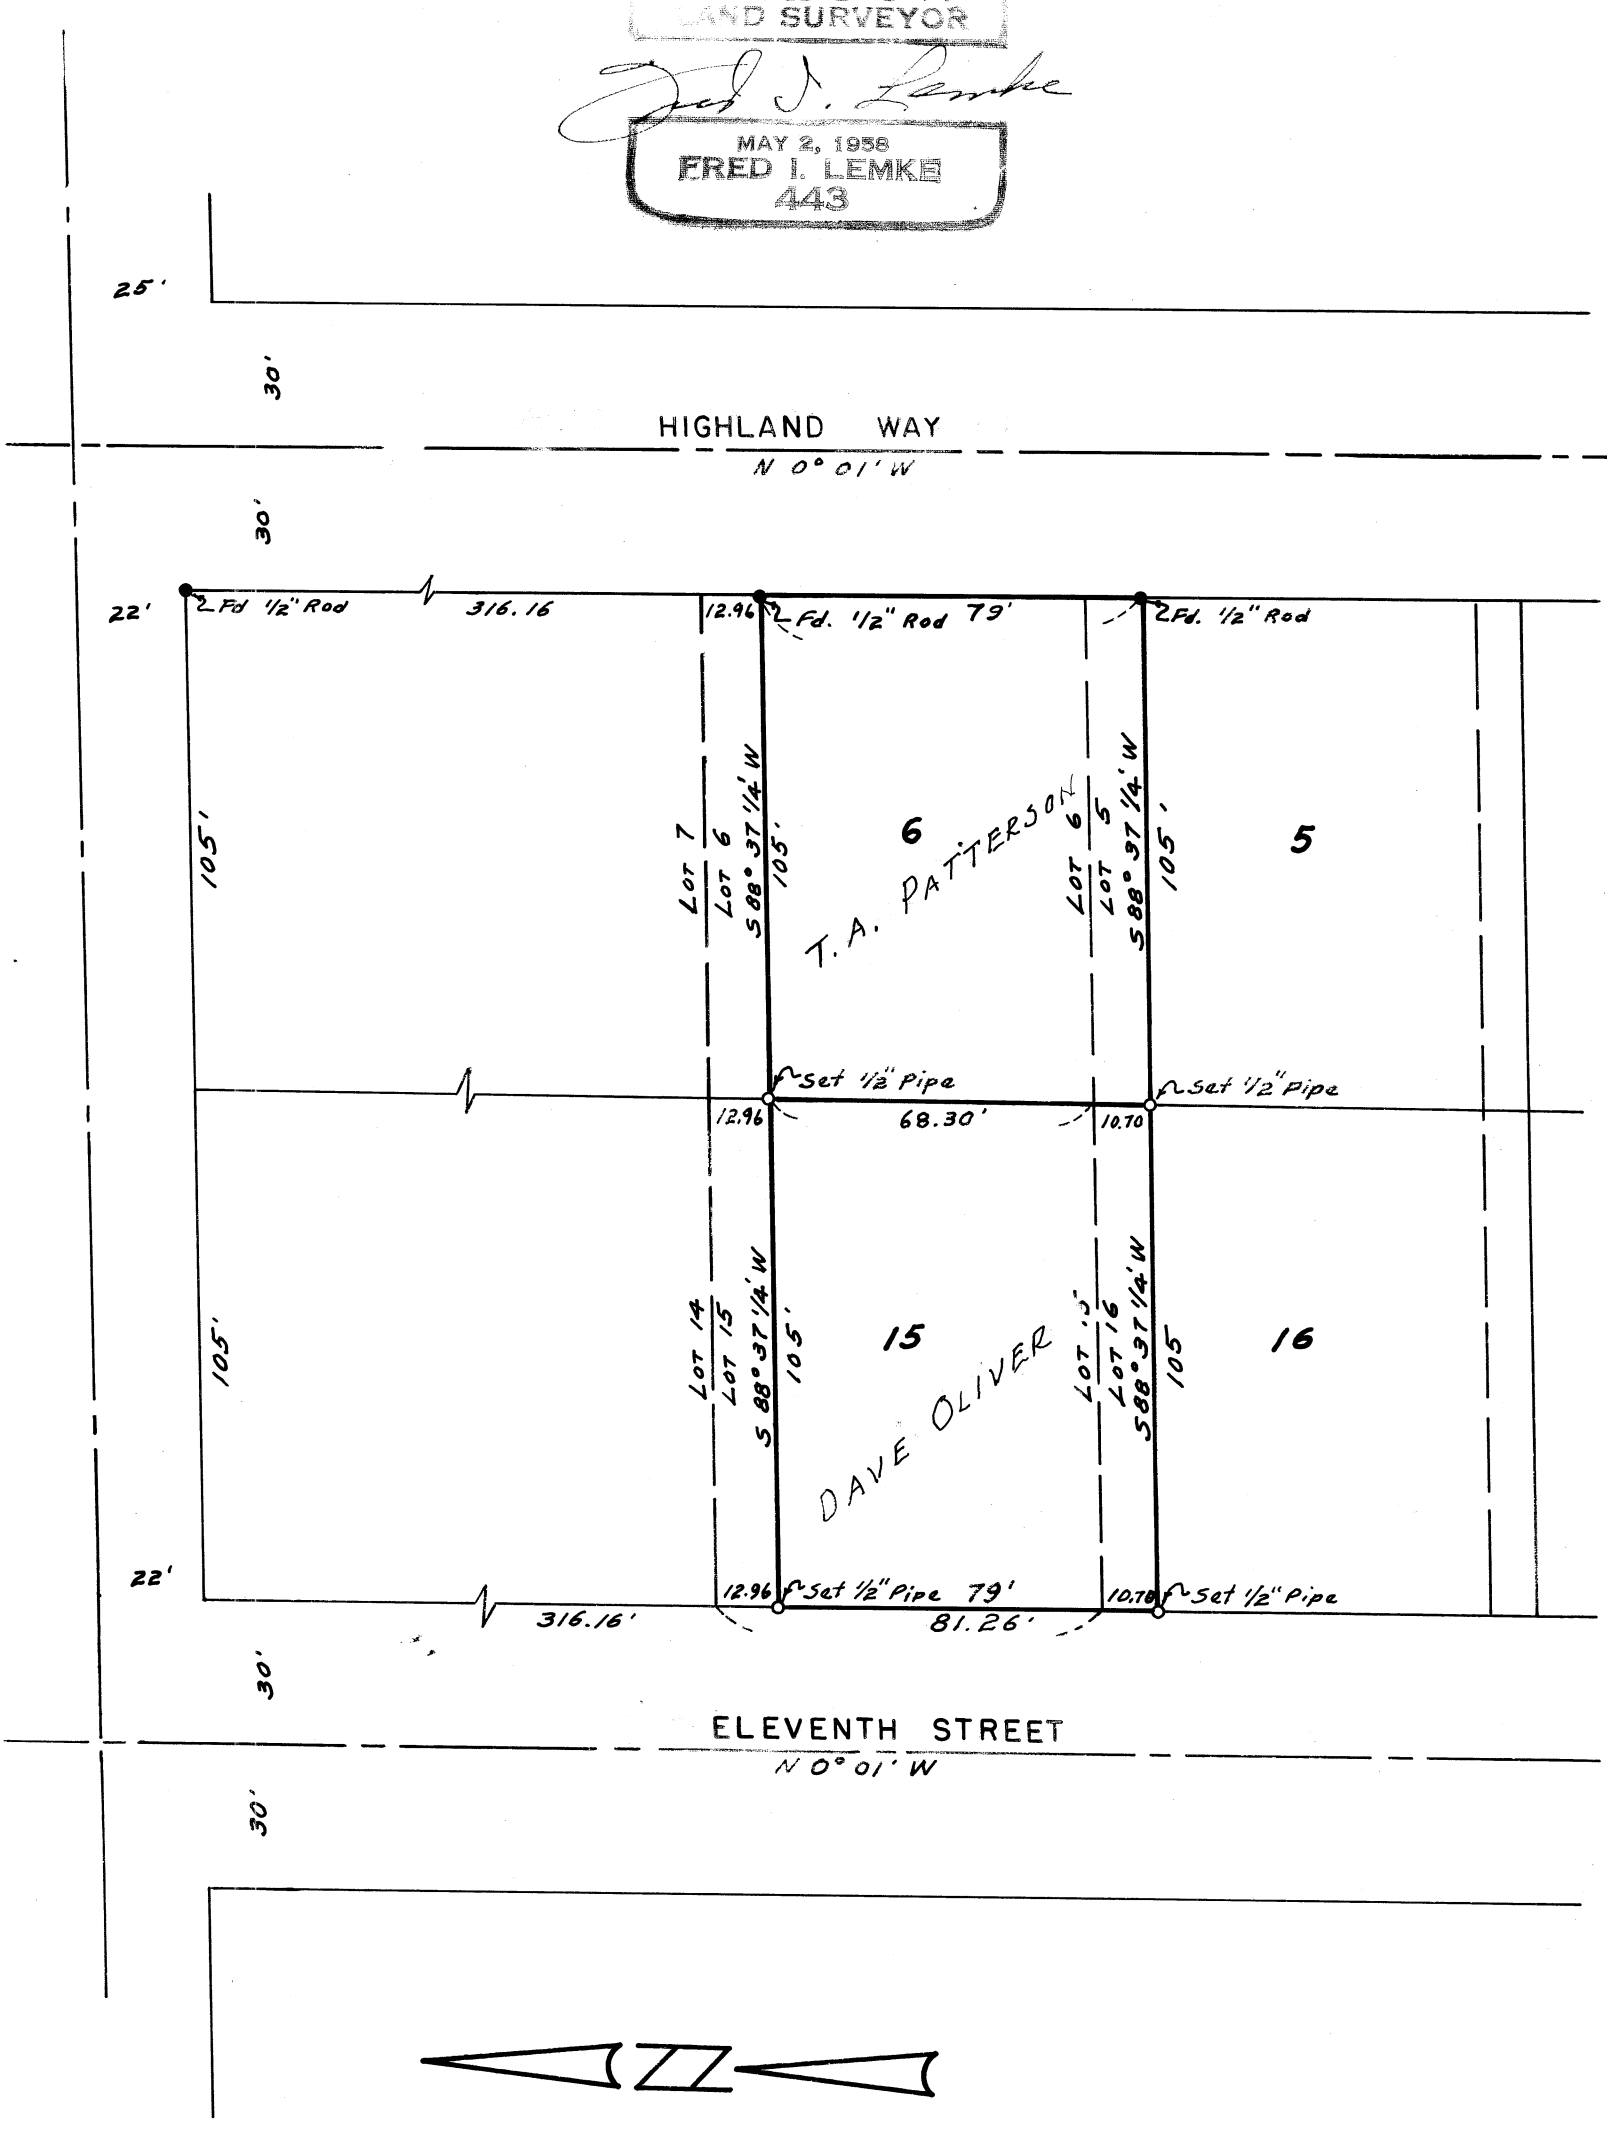
REGISTERED
OREGON
LAND SURVEYOR
Fred I. Lemke
MAY 2, 1958
FRED I. LEMKE
443