C S 4019

RECORD OF SURVEY

for

Robert Canfield

in the Price Fuller D.L.C. No. 37, T11S, R5W, W.M.

Benton County, Oregon

Scale 1"= 200' January 14, 1965

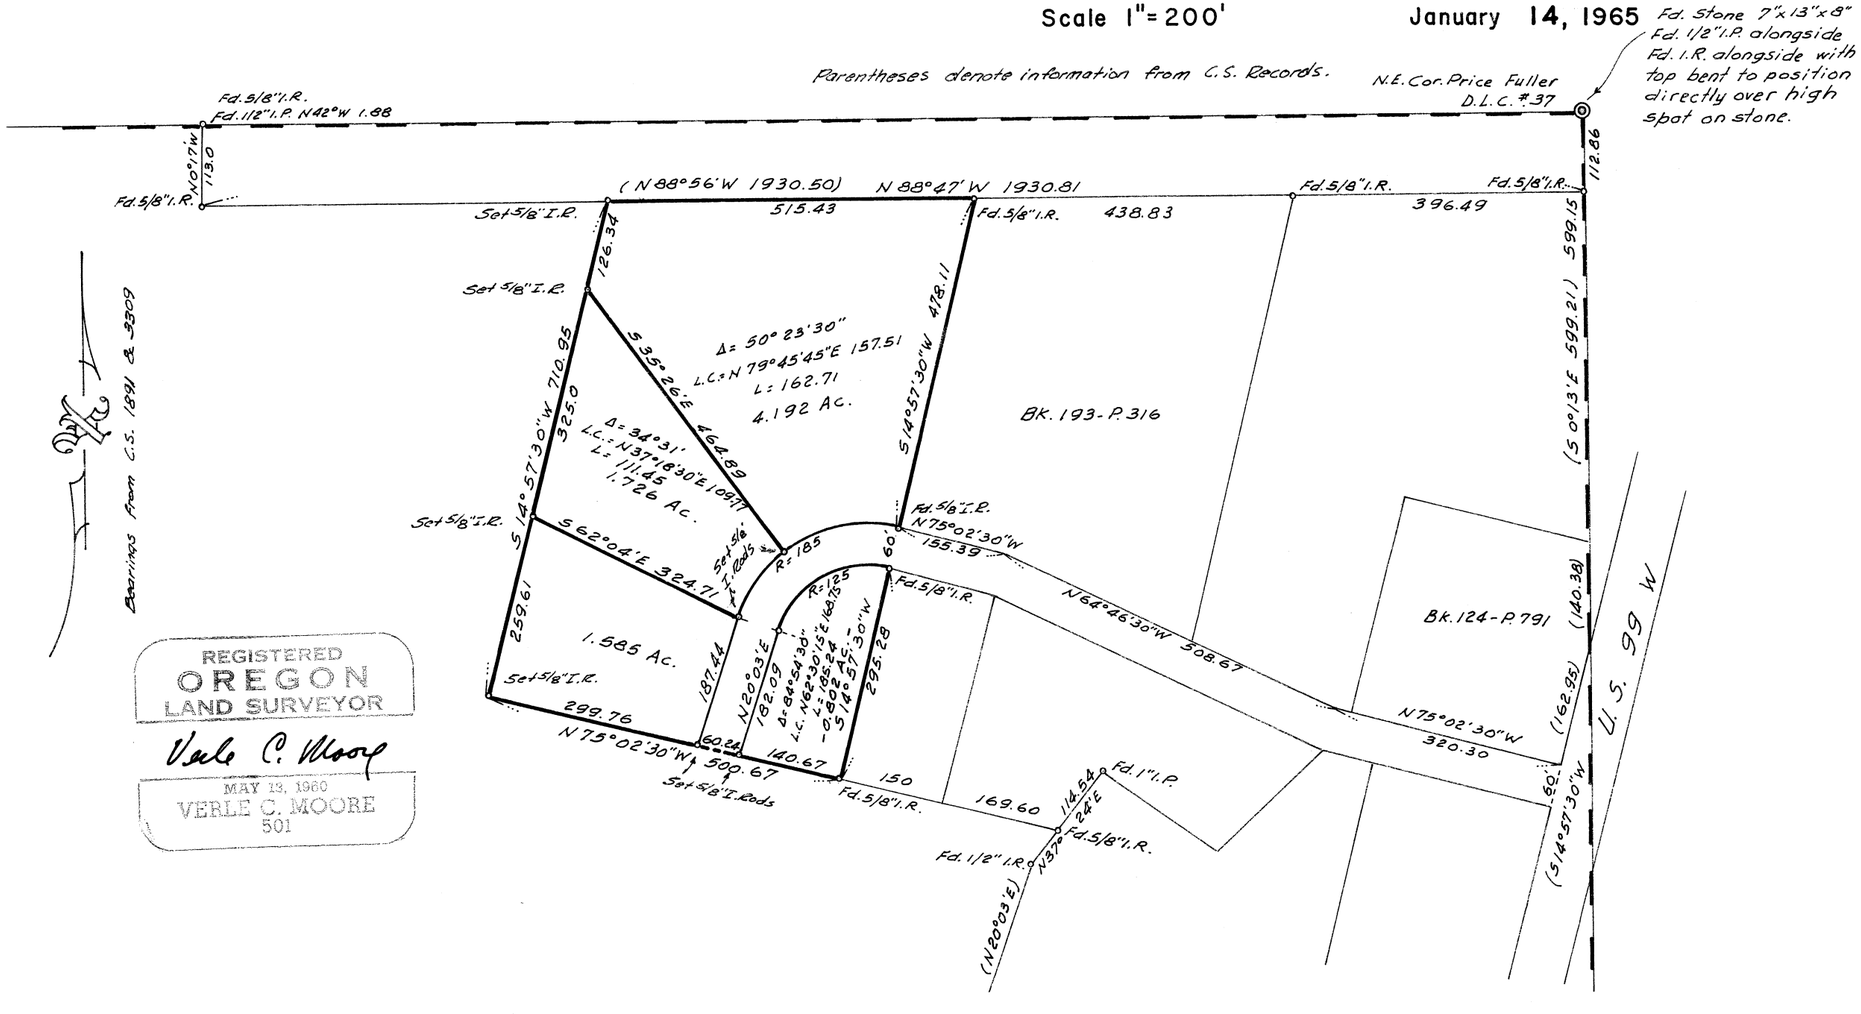

REGISTERED
OREGON
LAND SURVEYOR

Verle C. Moore

MAY 13, 1960
VERLE C. MOORE
501