C. S. 4025

SURVEY FOR

Mrs. VERLE QUINLAN

In the Abram N. Locke D.L.C. No. 41

Township 11 South, Range 5 West

of Willamette Meridian

Benton County, Oregon

Scale: 1" = 100' Oct. 15, 1964
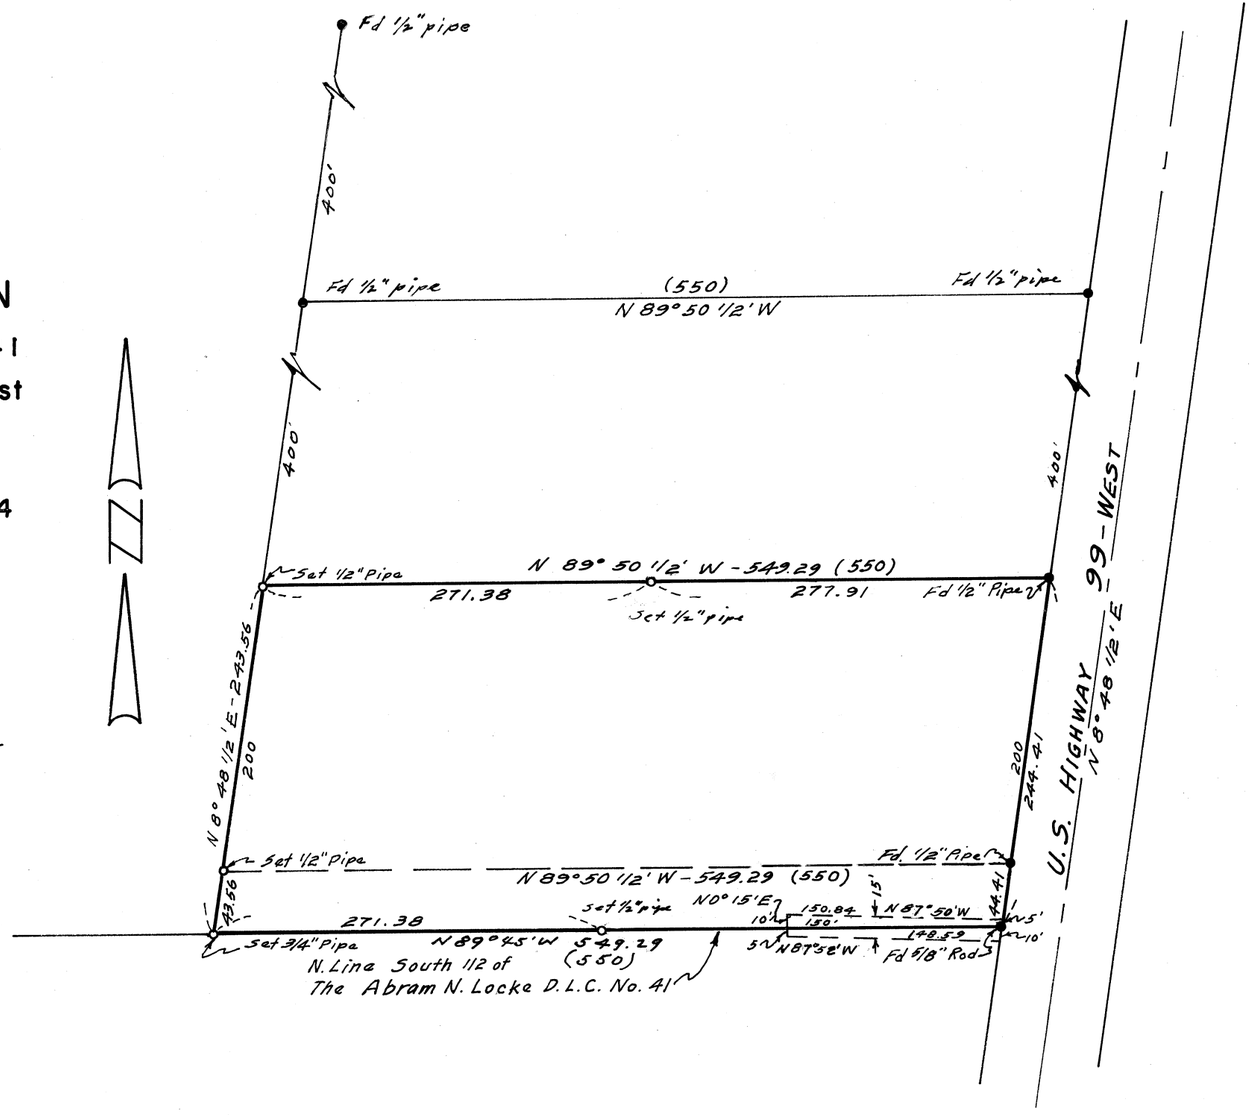
REGISTERED
OREGON
LAND SURVEYOR
Fred I. Lemke
MAY 2, 1958
FRED I. LEMKE
443