C.S. Nº 4040

Record of Survey
for
CLOVERDALE FARMS
in the
A. M. Rainwater D.L.C. 39
E. 1/2 Sec. 1, T. 11 S., R. 4 W. W.M.
Benton County, Oregon

Scale: 1" = 200' March 10, 1965

Parentheses denote information from deeds or State Hwy map.

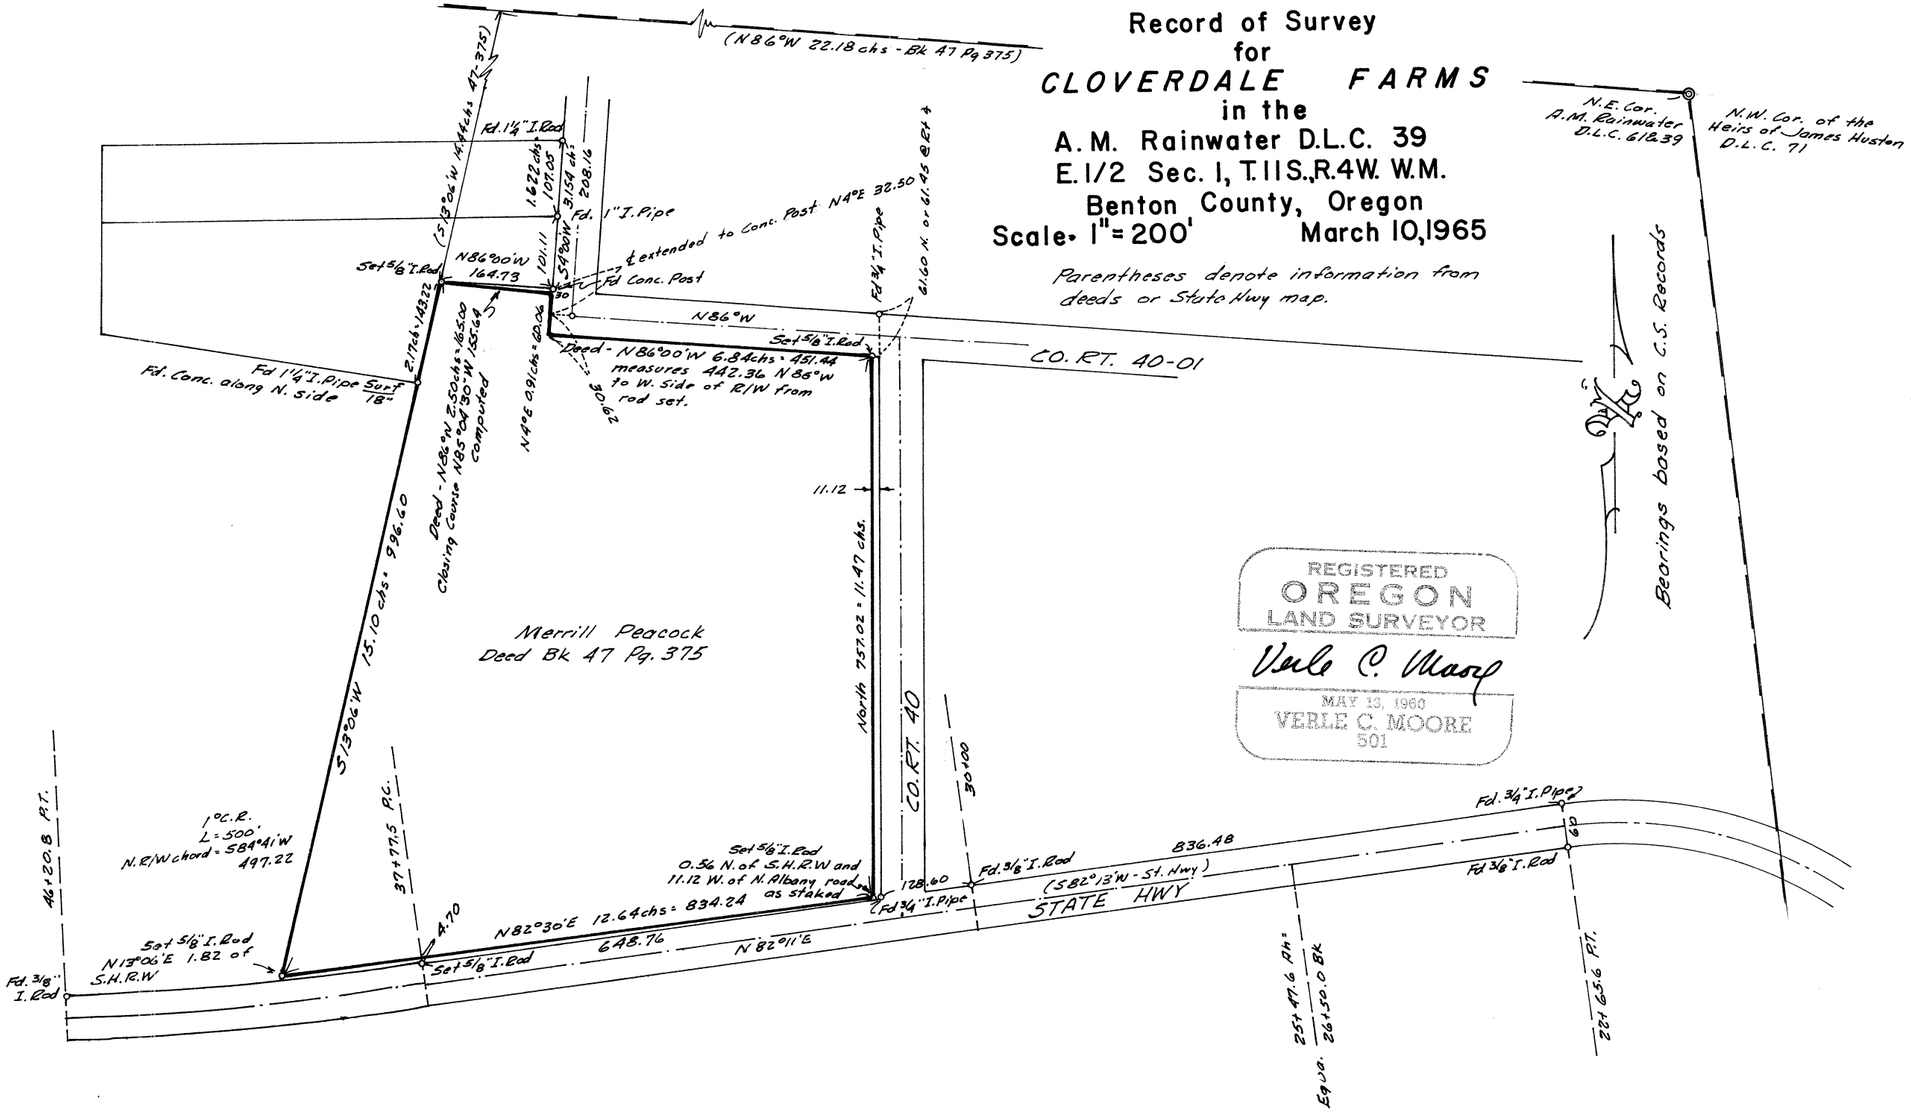

REGISTERED OREGON LAND SURVEYOR

Verle C. Moore

MAY 13, 1960
VERLE C. MOORE
501

Bearings based on C.S. Records