C.S. 4101

SURVEY FOR

F. WAYNE BEALS

In the David Butterfield D.L.C. No. 47

Township 12 South, Range 5 West of W.M.

Corvallis, Benton County, Oregon

Scale: 1"=100' © May 7, 1965
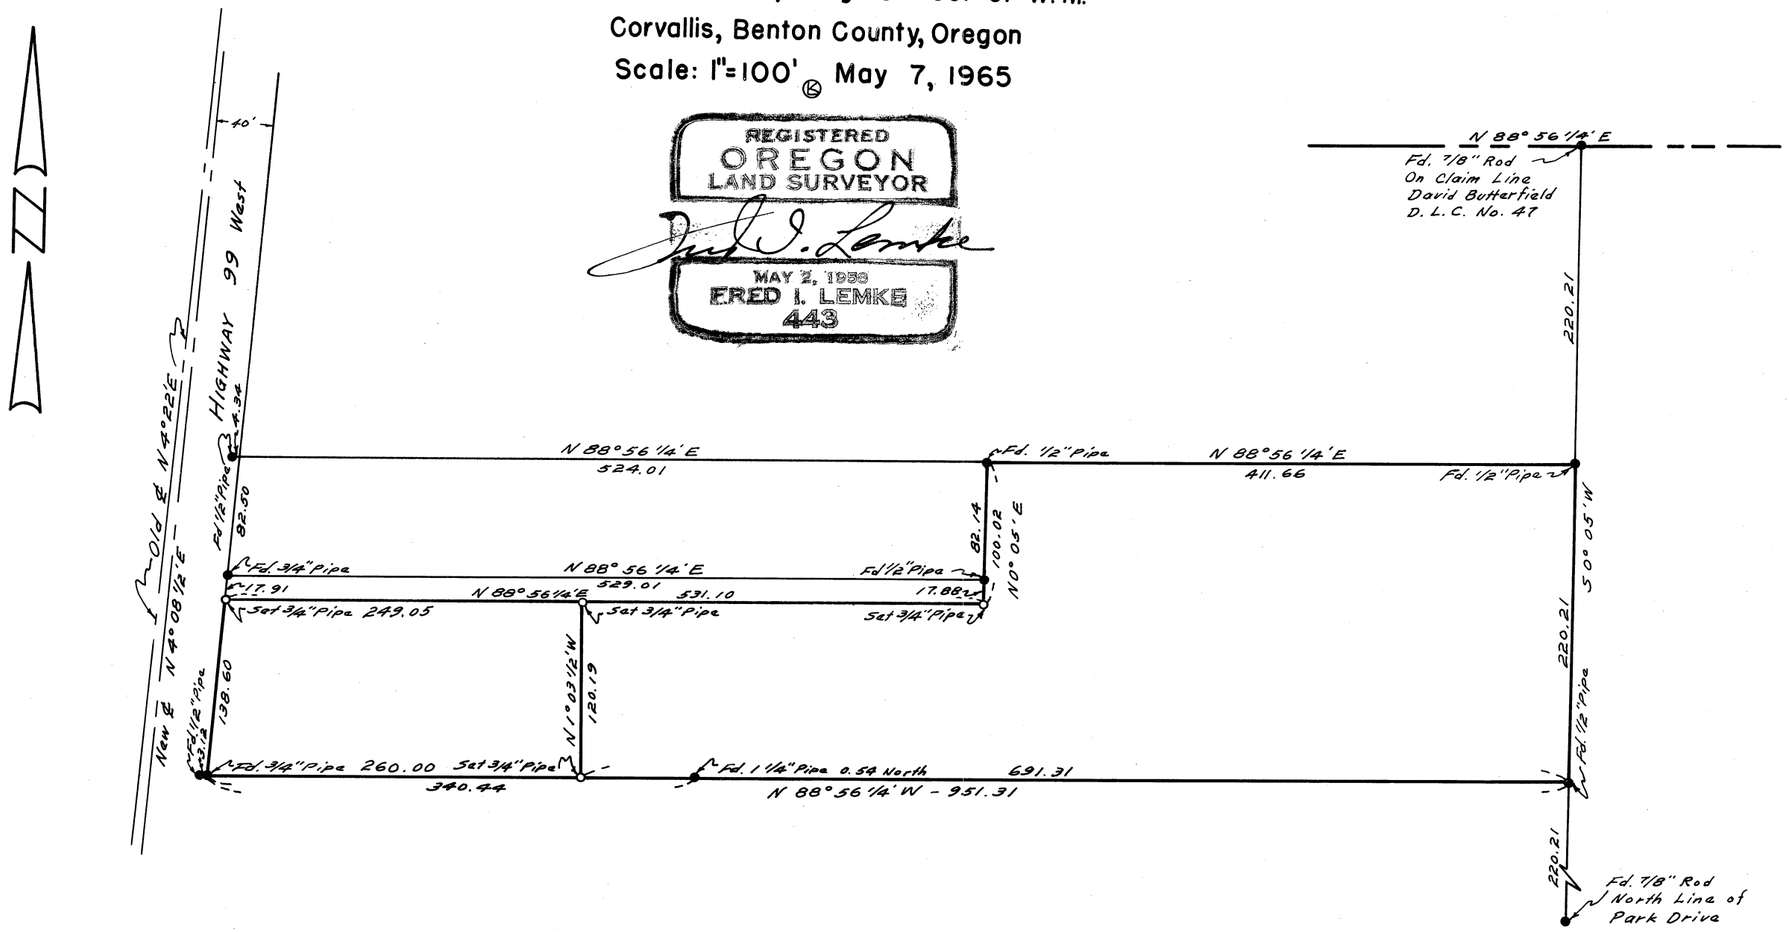
REGISTERED
OREGON
LAND SURVEYOR
Fred I. Lemke
MAY 2, 1958
FRED I. LEMKE
443