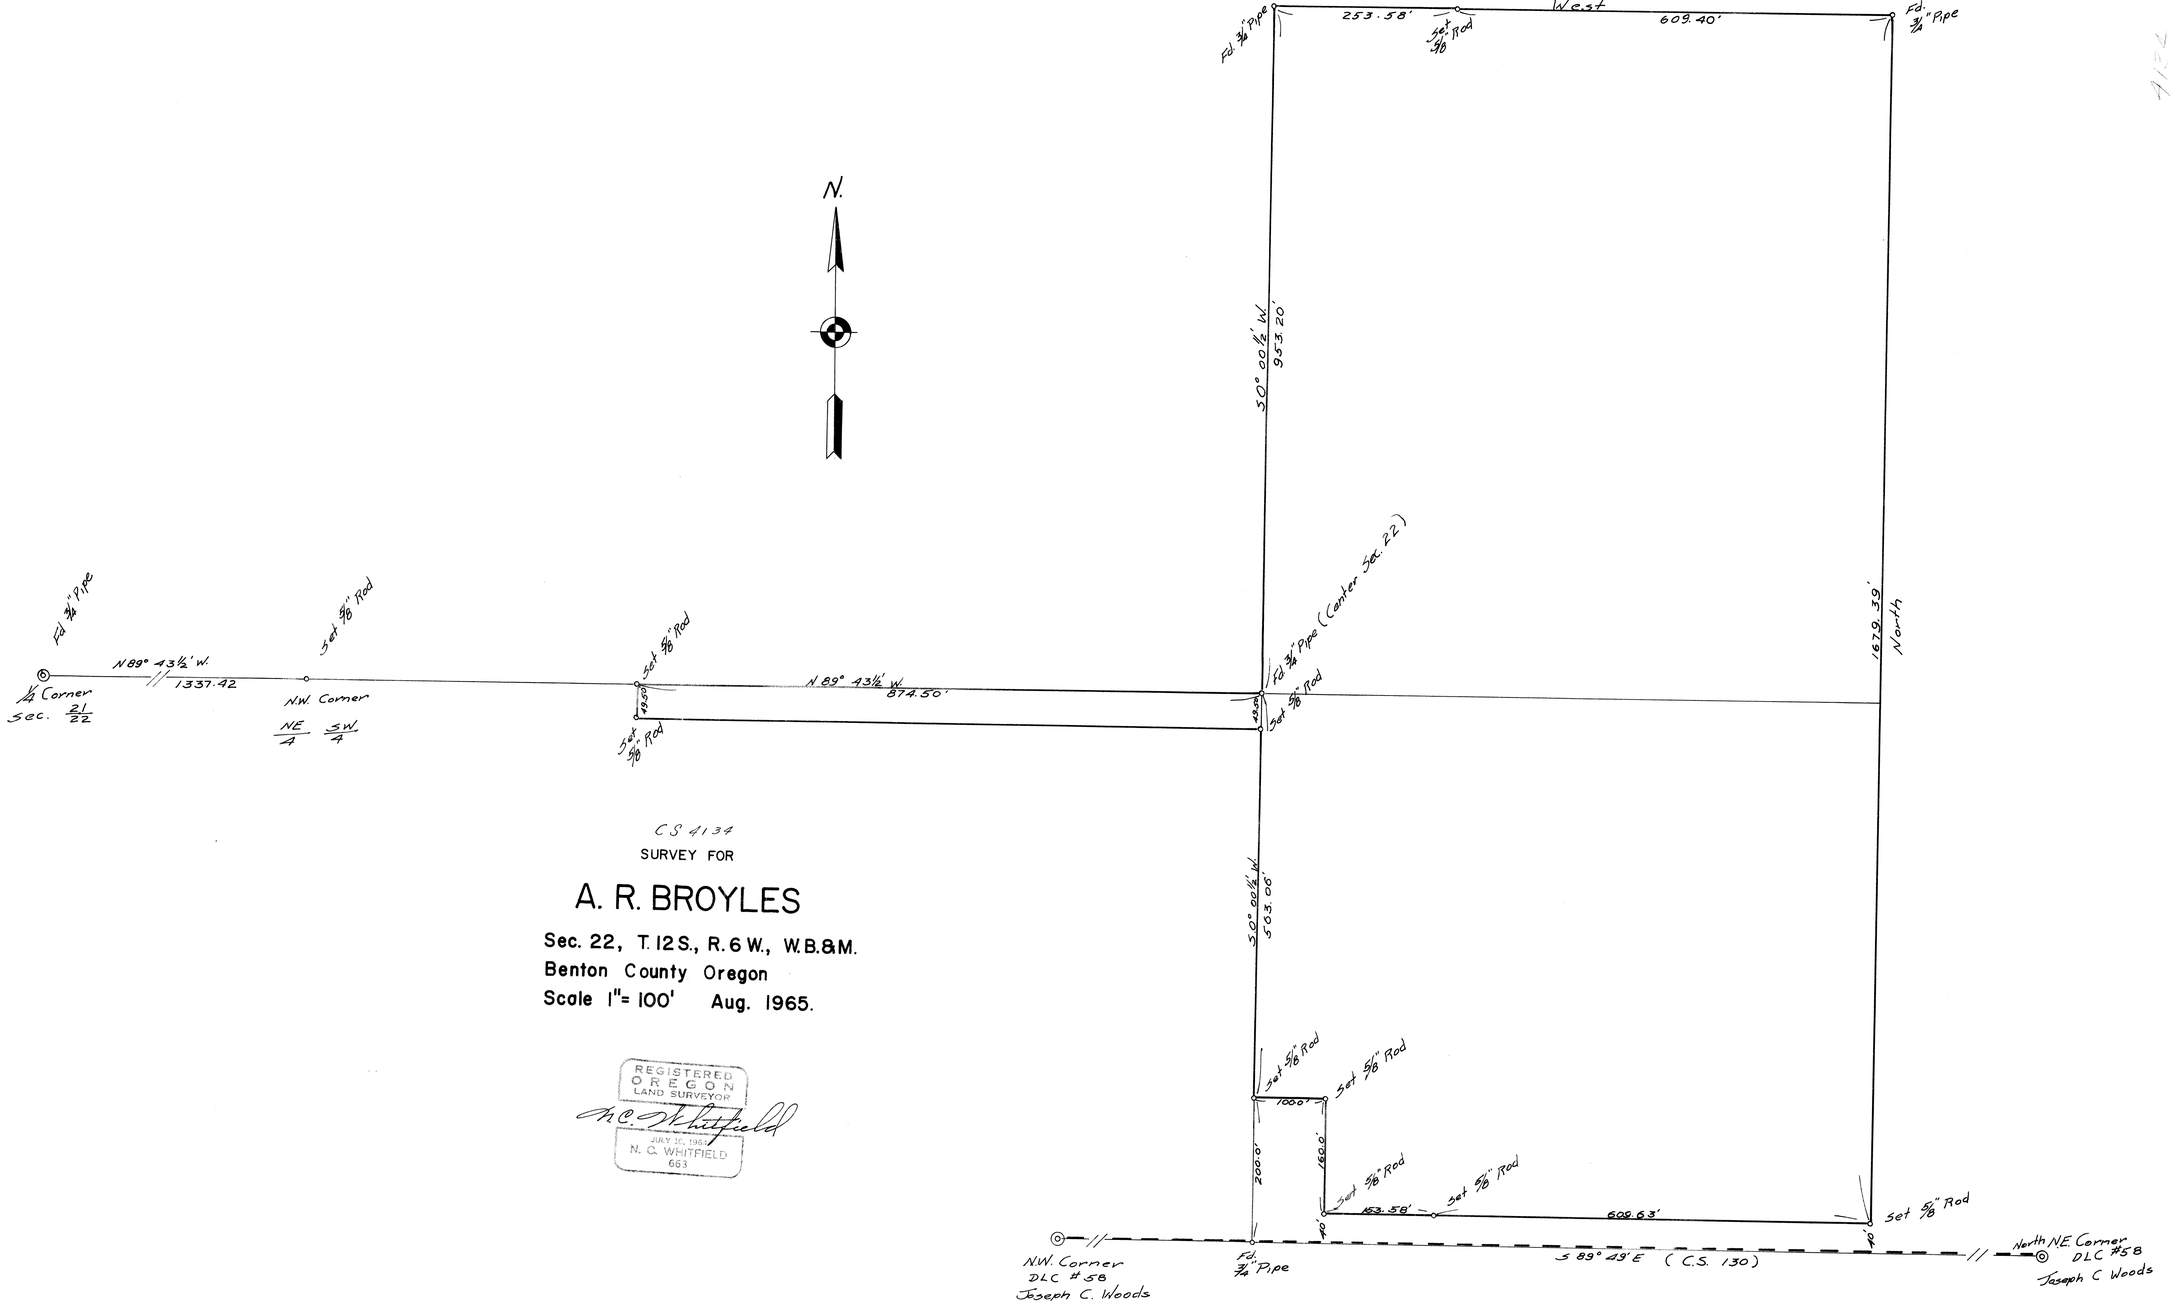

CS 4134

SURVEY FOR

A. R. BROYLES

Sec. 22, T. 12 S., R. 6 W., W.B.&M.
Benton County Oregon
Scale 1"= 100' Aug. 1965.

REGISTERED
OREGON
LAND SURVEYOR
N. C. Whitfield
JULY 30, 1965
N. C. WHITFIELD
663