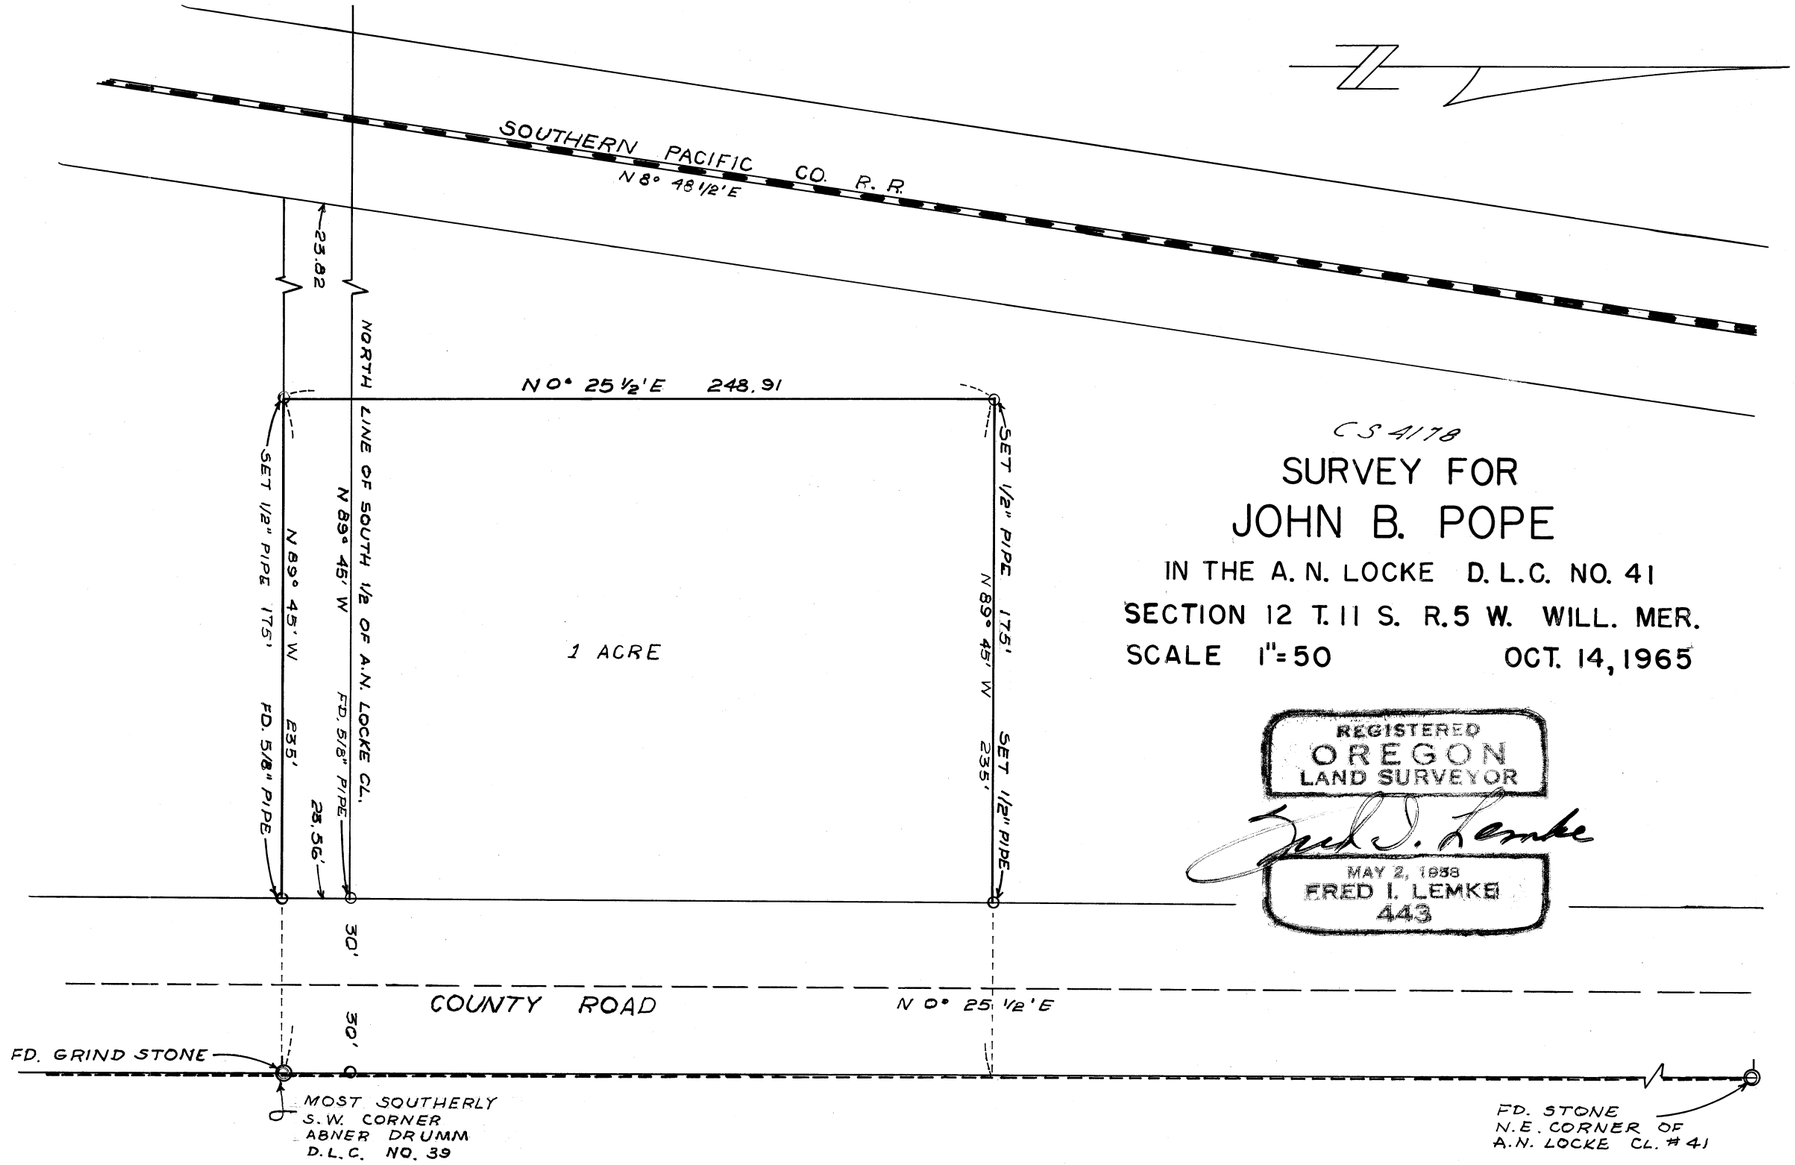

CS 4178

SURVEY FOR
JOHN B. POPE

IN THE A. N. LOCKE D. L. C. NO. 41

SECTION 12 T. 11 S. R. 5 W. WILL. MER.

SCALE 1"=50 OCT. 14, 1965

REGISTERED
OREGON
LAND SURVEYOR

Fred I. Lemke

MAY 2, 1958
FRED I. LEMKE
443

65-220