CS 4184

H. L. SCHUDEL

Sec. 15, T. 13 S., R. 6 W., W.M.

Dec. 20, 1965
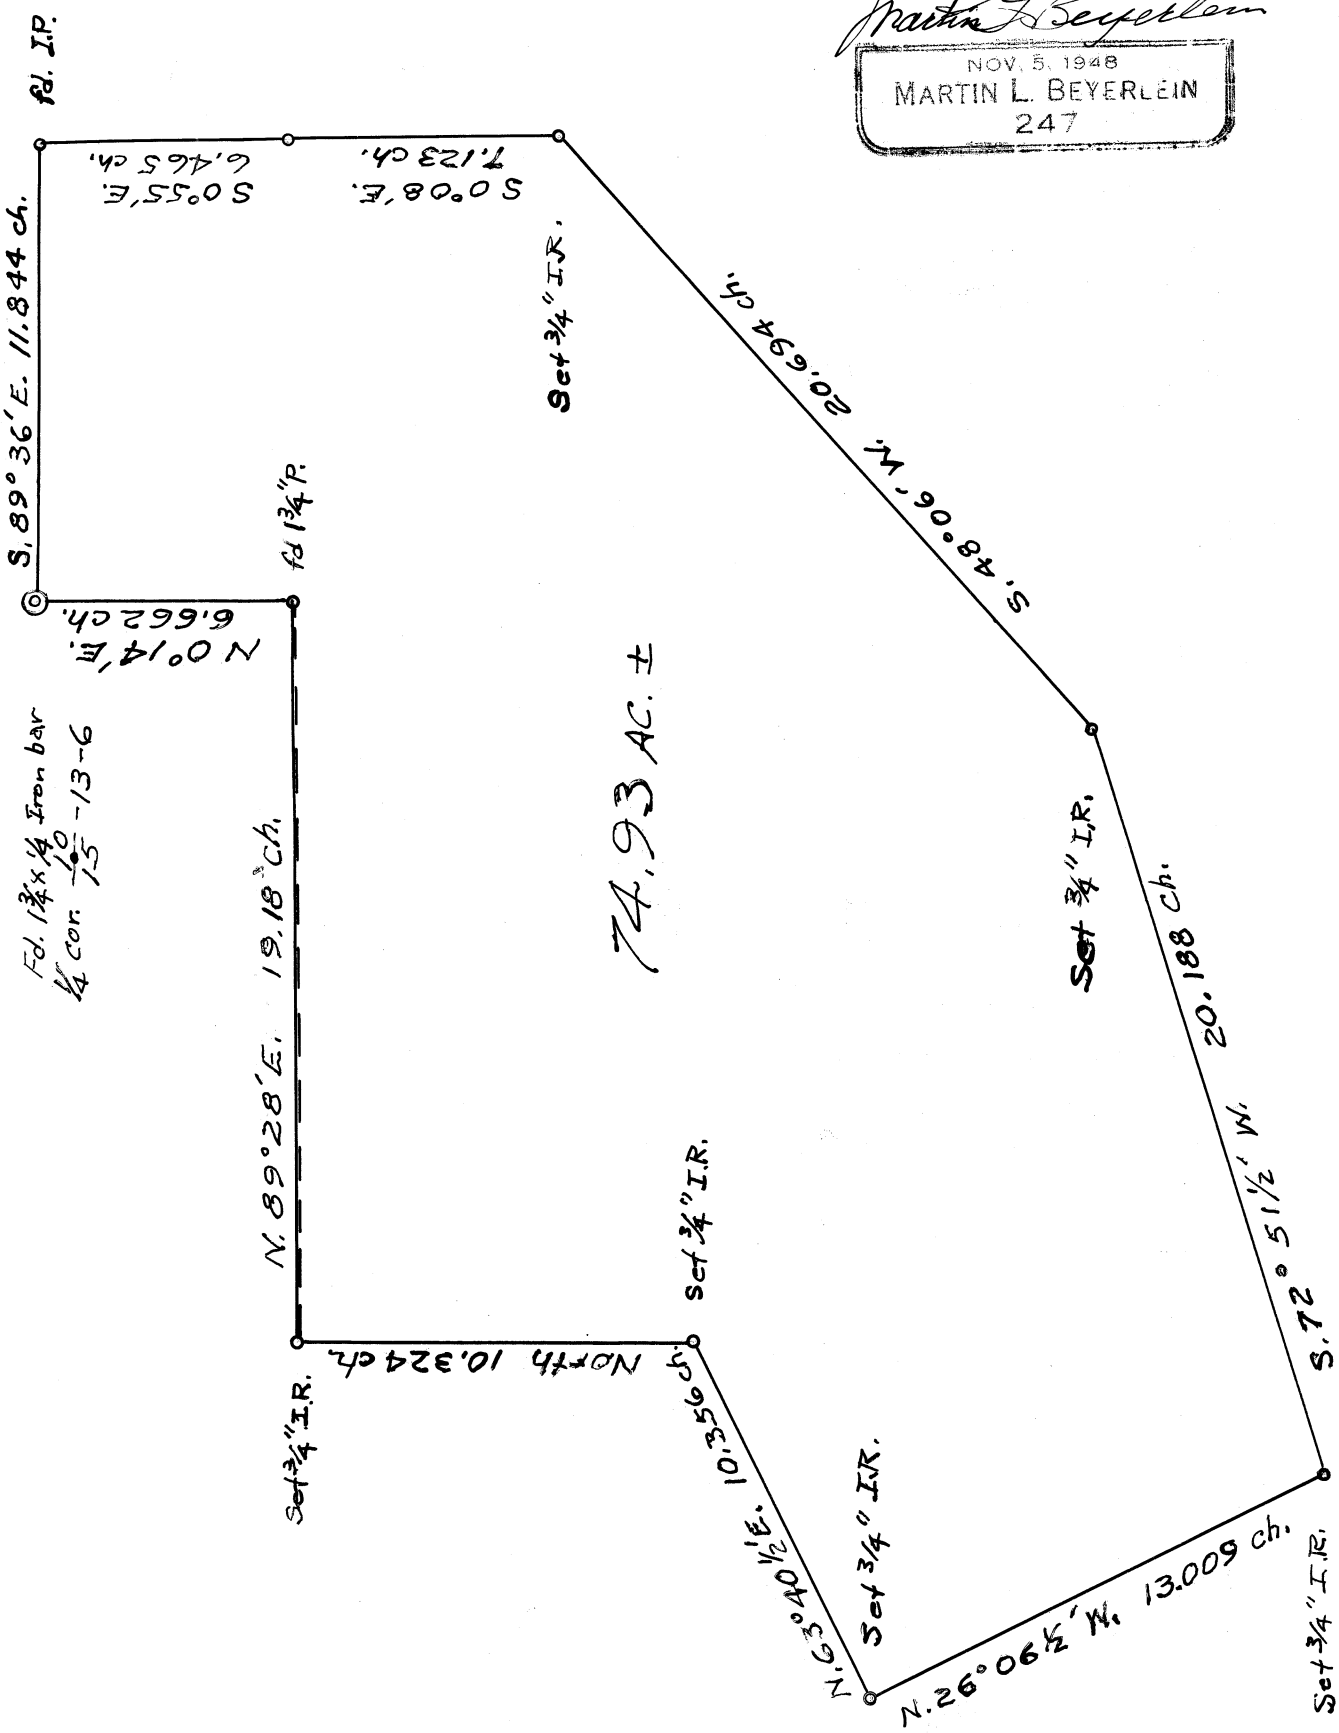
REGISTERED
OREGON
LAND SURVEYOR
Martin L. Beyerlein
NOV. 5, 1948
MARTIN L. BEYERLEIN
247