C.S. 4508

Record of Survey
for
ORVILLE CAMP
in the
Northwest Quarter of Section 30
T. 11 S., R. 5 W. W.B.& M.
Benton County, Oregon
Scale 1"= 200' February 19, 1968

24 | 19
25 | 30

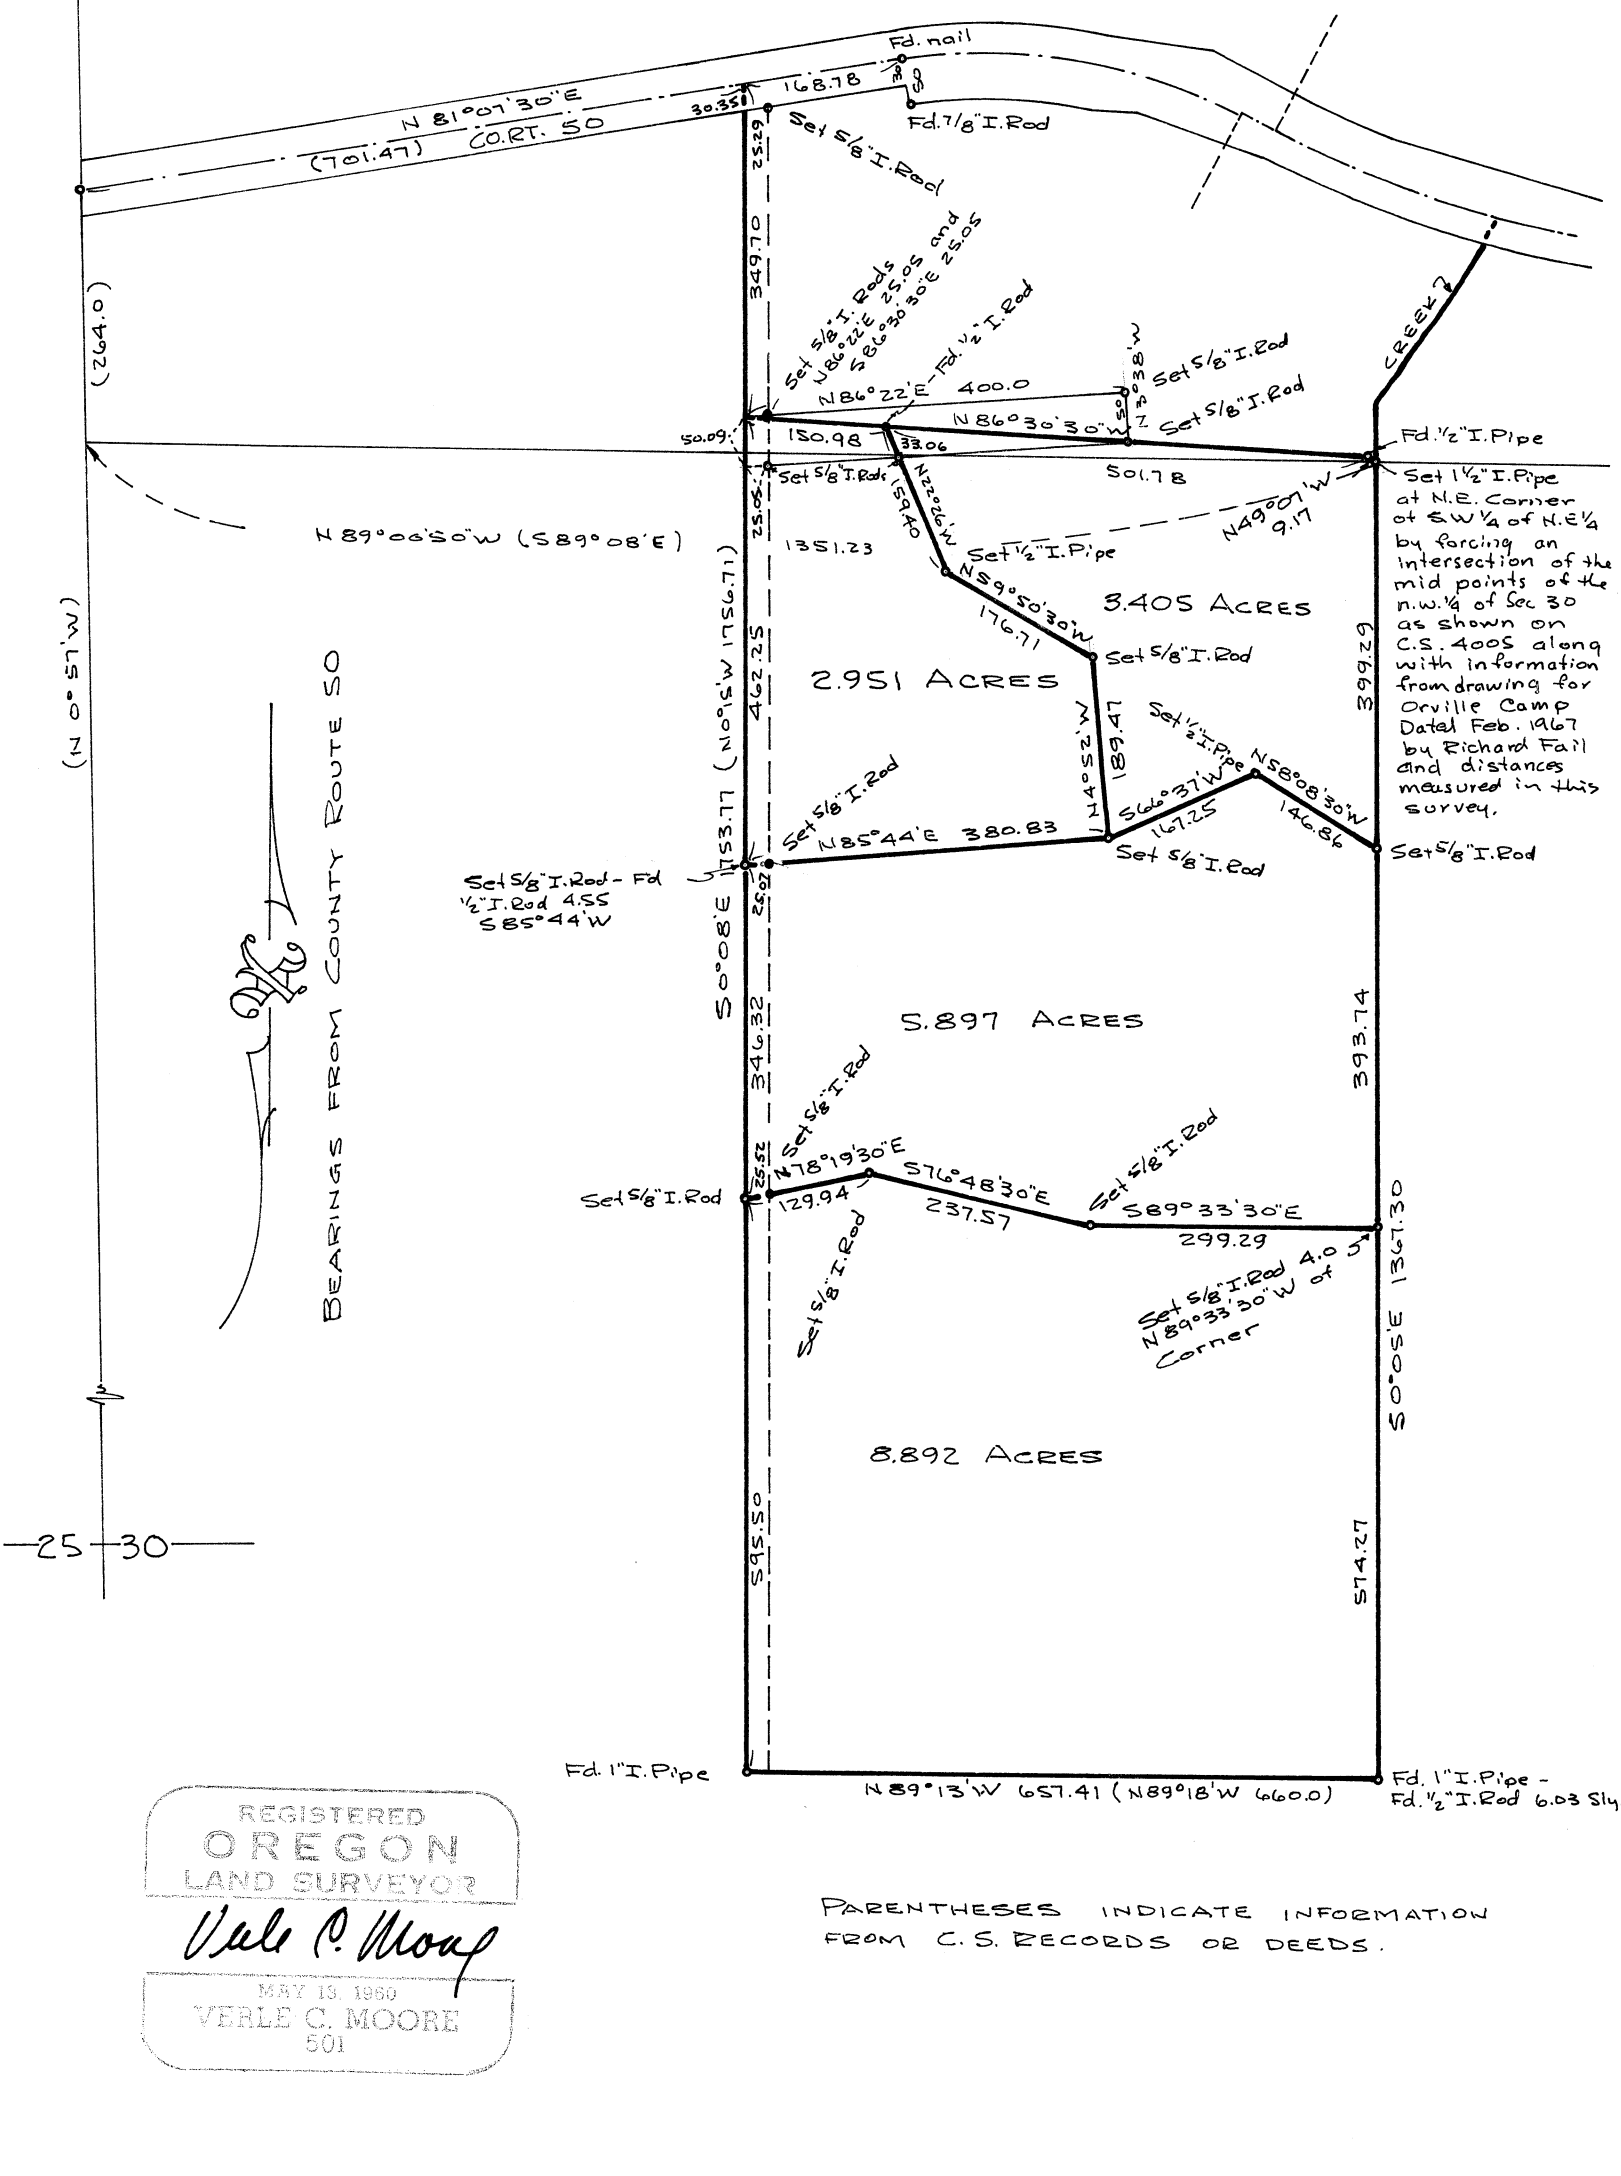

REGISTERED
OREGON
LAND SURVEYOR
Verle C. Moore
MAY 19, 1960
VERLE C. MOORE
501

PARENTHESES INDICATE INFORMATION FROM C. S. RECORDS OR DEEDS.