C.S.4538

G. BEST

FARM LOT 1 PHILOMATH, BENTON CO., OREGON

Scale: 1" = 50'

June 27, 1968
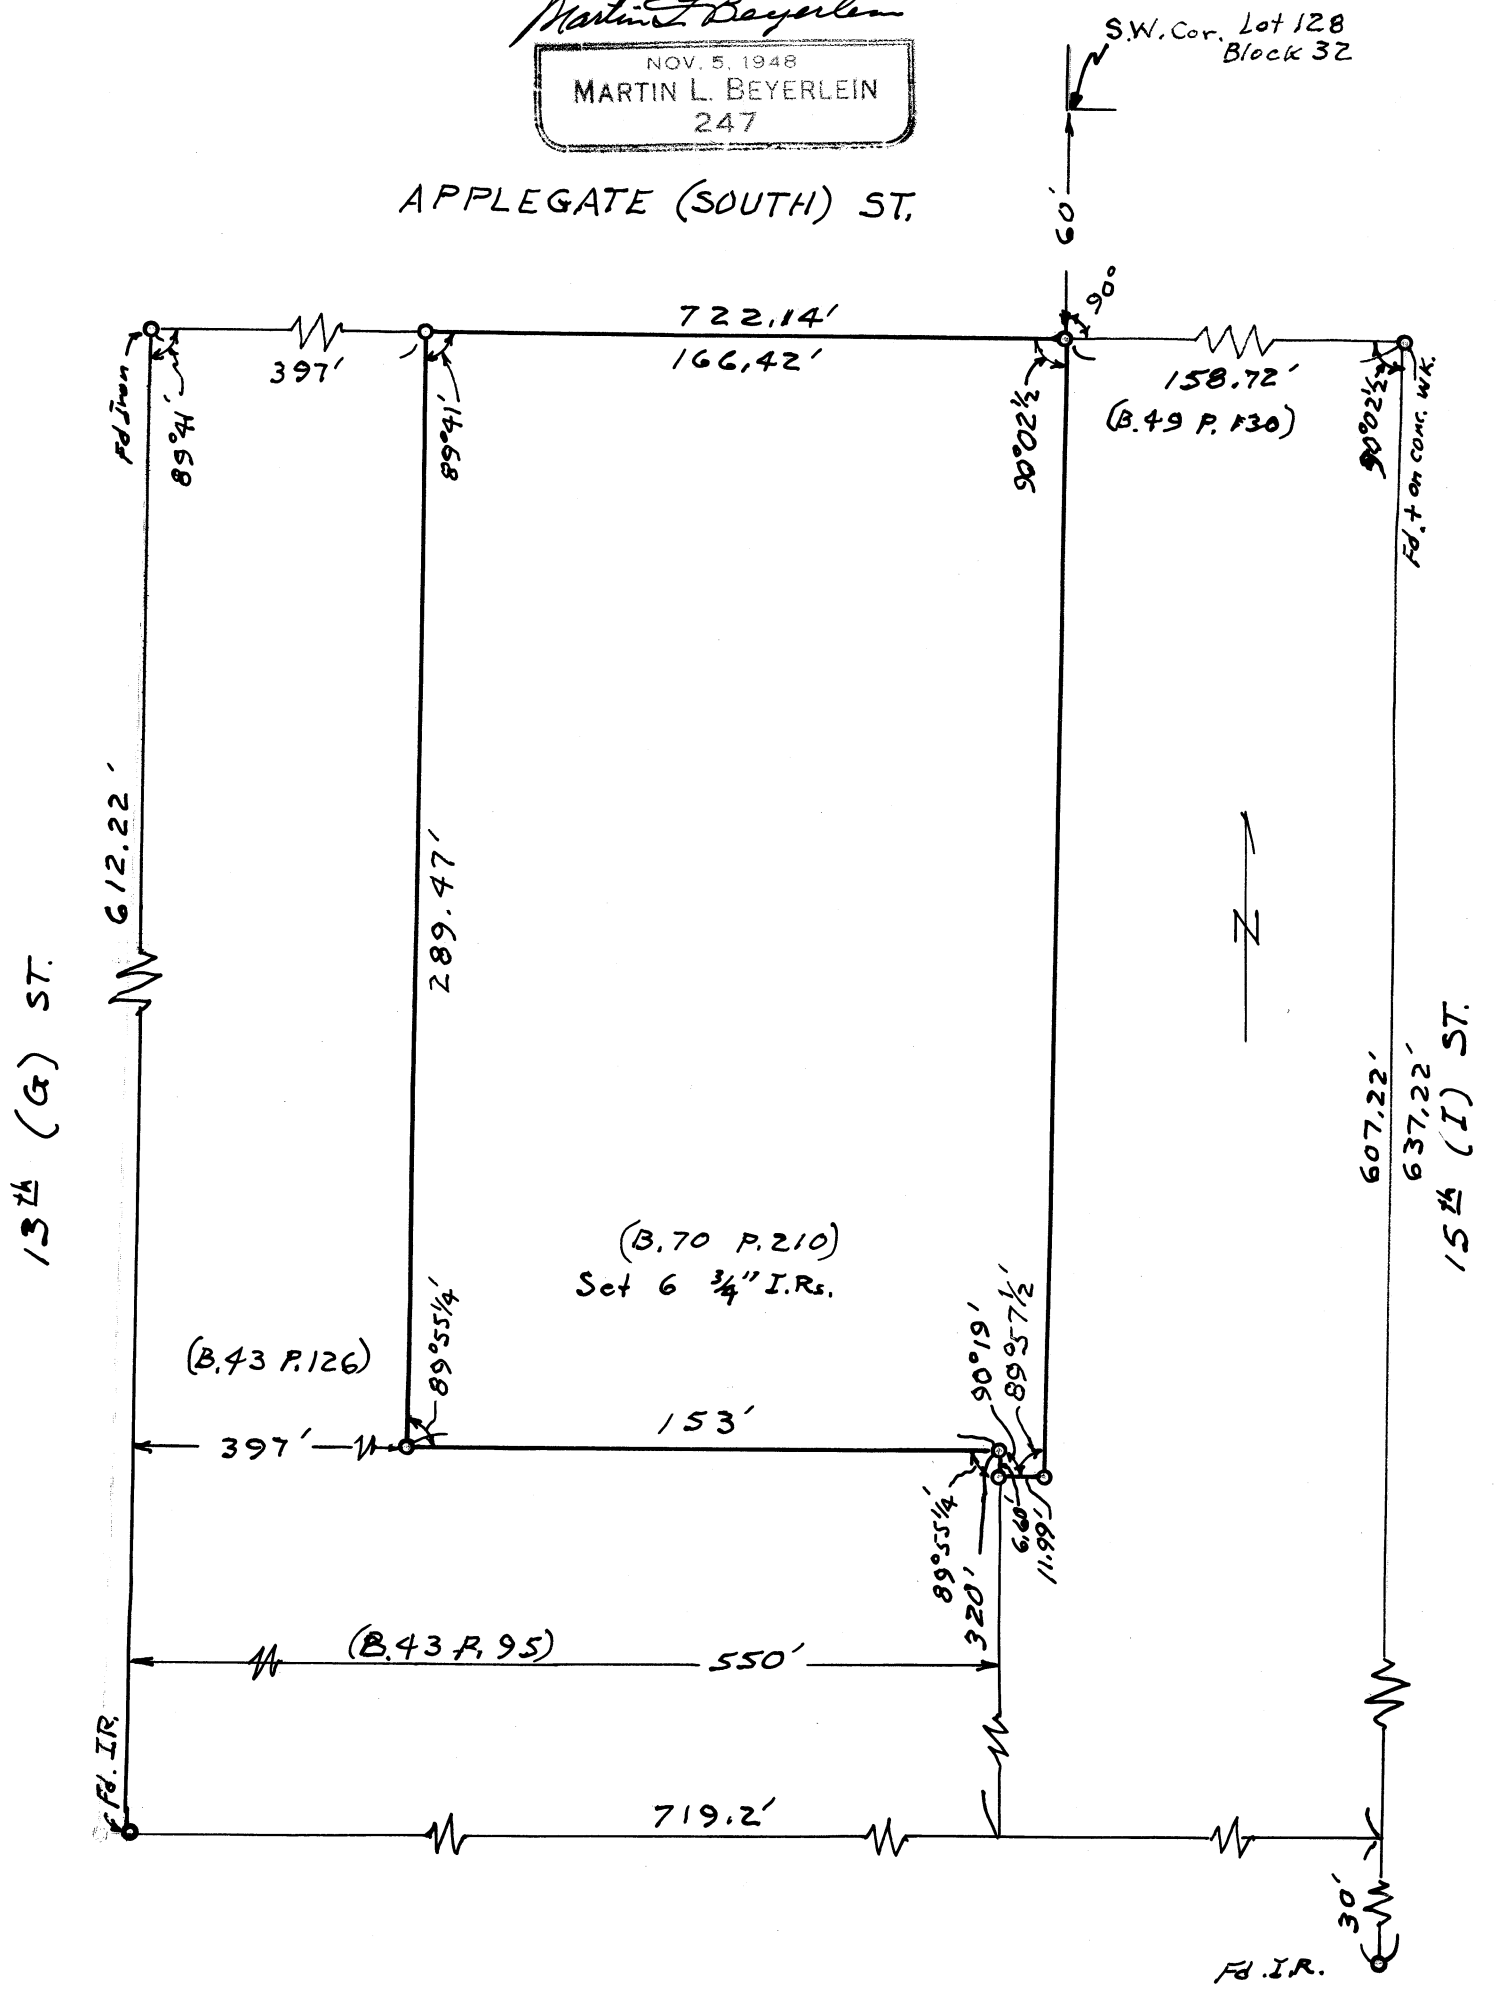
REGISTERED
OREGON
LAND SURVEYOR
Martin L. Beyerlein
NOV. 5, 1948
MARTIN L. BEYERLEIN
247