2-9-1992
NOTE: SEE ALSO CS 4542-A
DATED FEB. 5, 1971

C.S. 4542

NORMAN WELCH

SEC. 21, T. 11 S., R. 5 W., W.M.

SCALE: 1" = 3ch. = 198' JUNE 17, 1968

EASEMENT
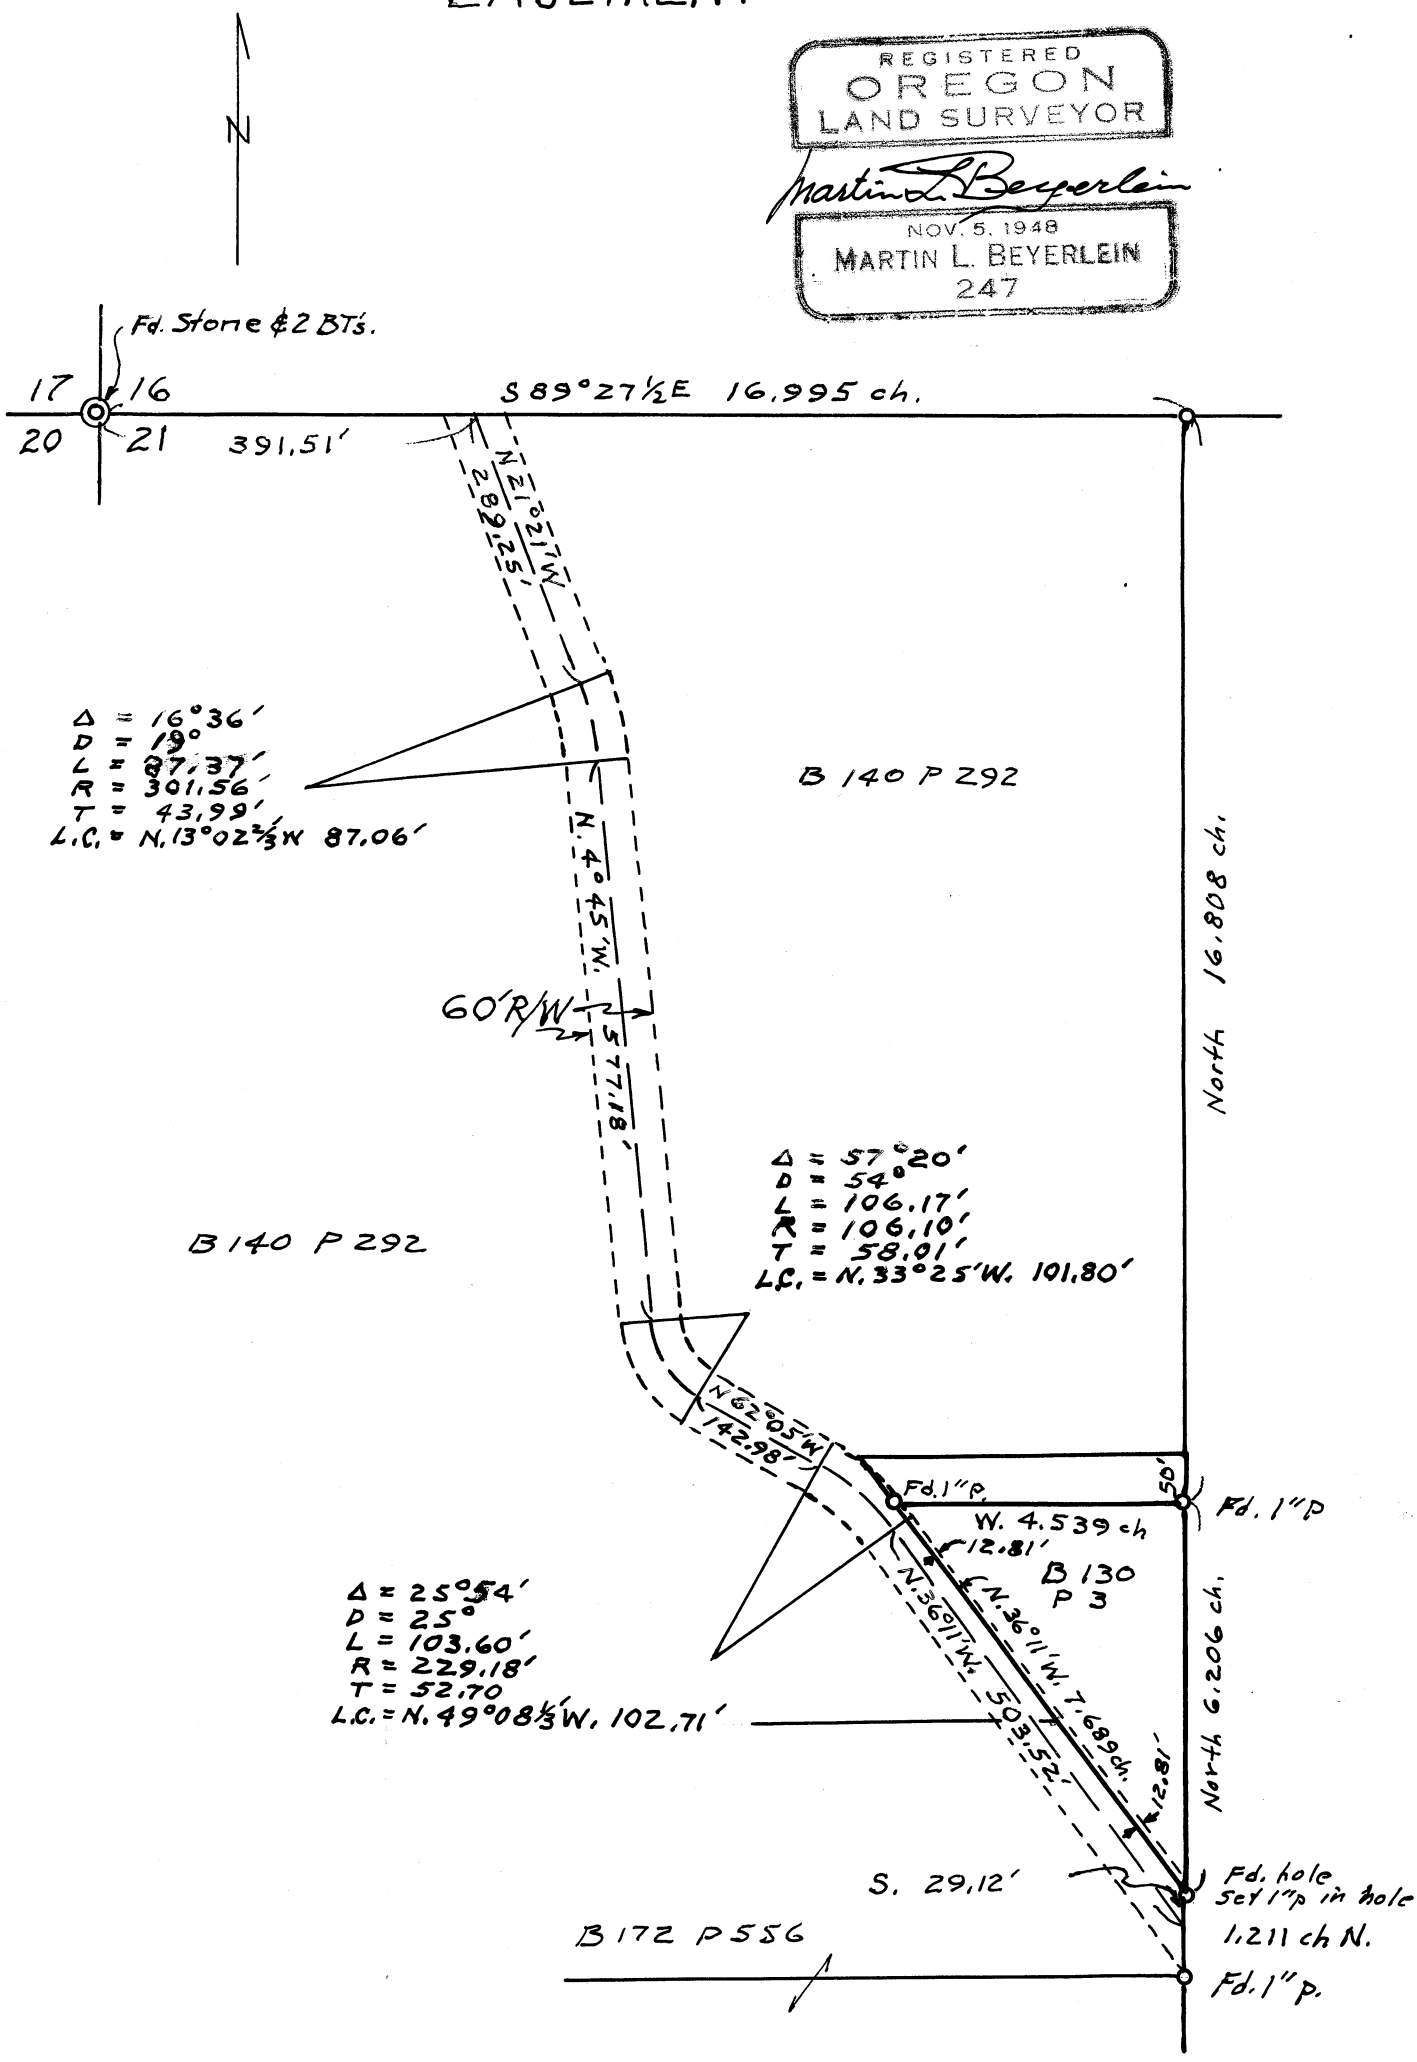
REGISTERED
OREGON
LAND SURVEYOR
Martin L. Beyerlein
NOV. 5, 1948
MARTIN L. BEYERLEIN
247