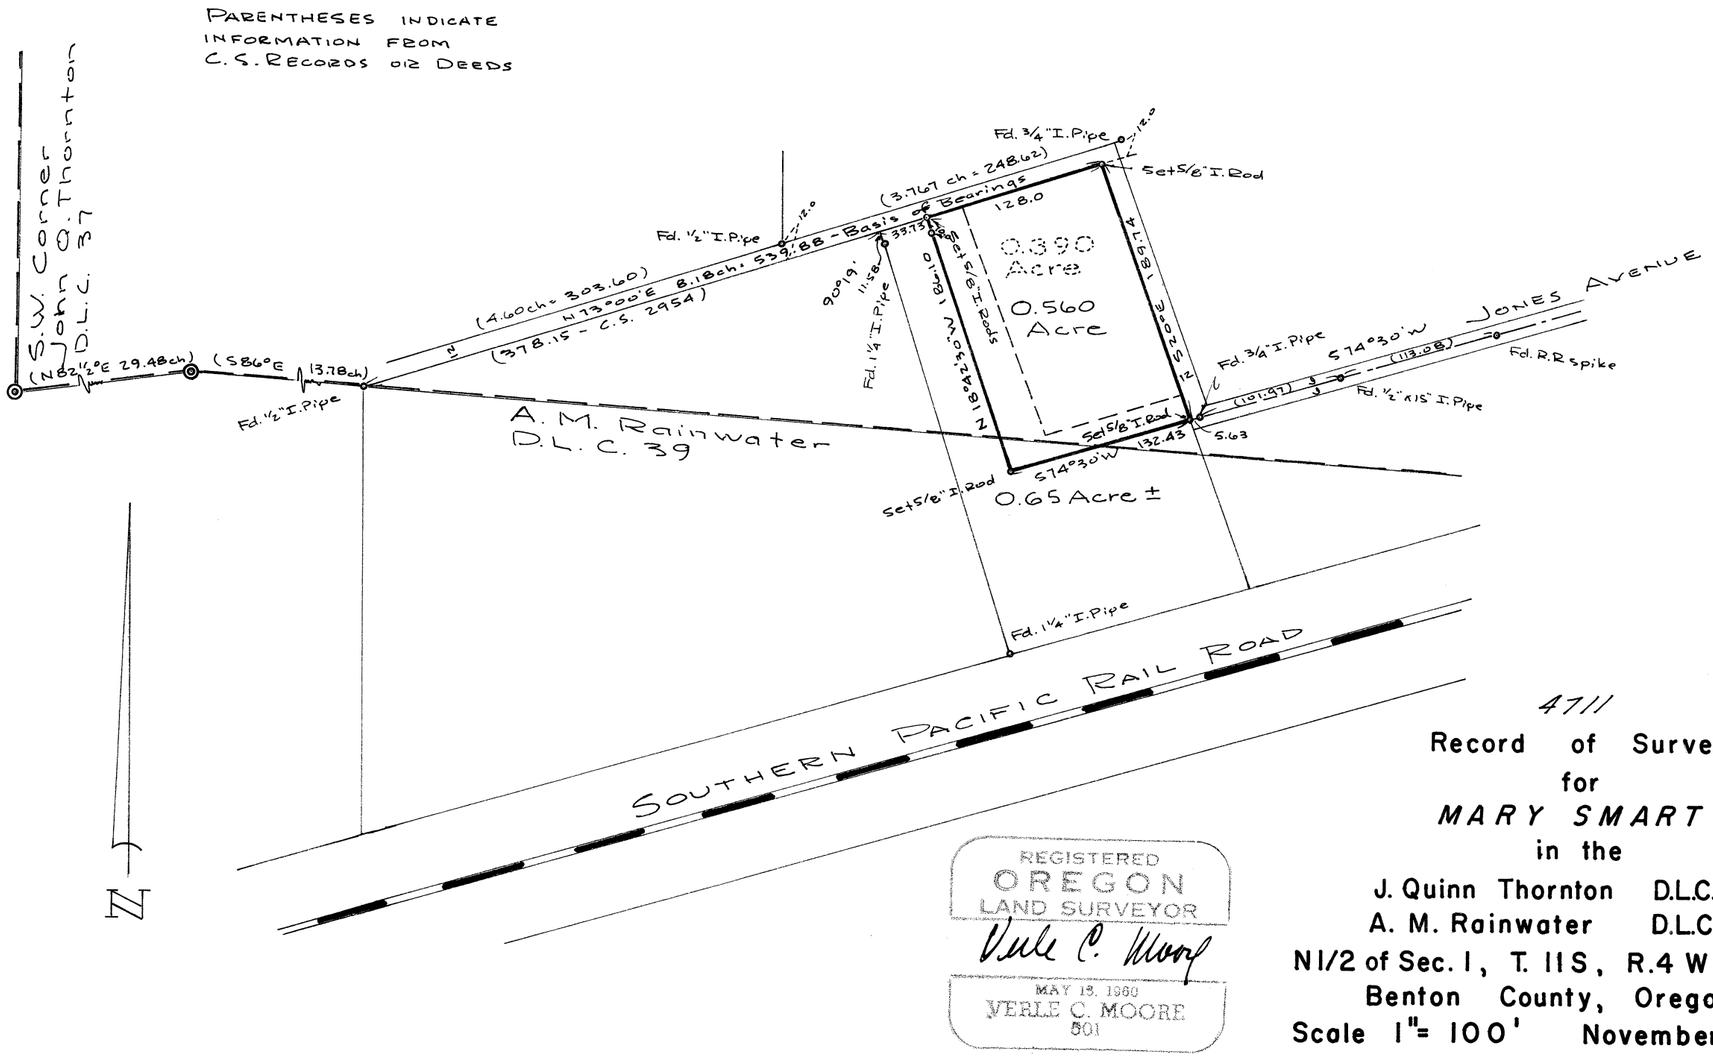

REGISTERED
OREGON
LAND SURVEYOR
Verle C. Moore
MAY 13, 1960
VERLE C. MOORE
501

4711

Record of Survey
for
MARY SMART
in the

J. Quinn Thornton D.L.C. 37
A. M. Rainwater D.L.C. 39
N1/2 of Sec. 1, T. 11S, R.4 W, W.B.&M.
Benton County, Oregon
Scale 1"= 100' November 27, 1968