4826

4826

4826

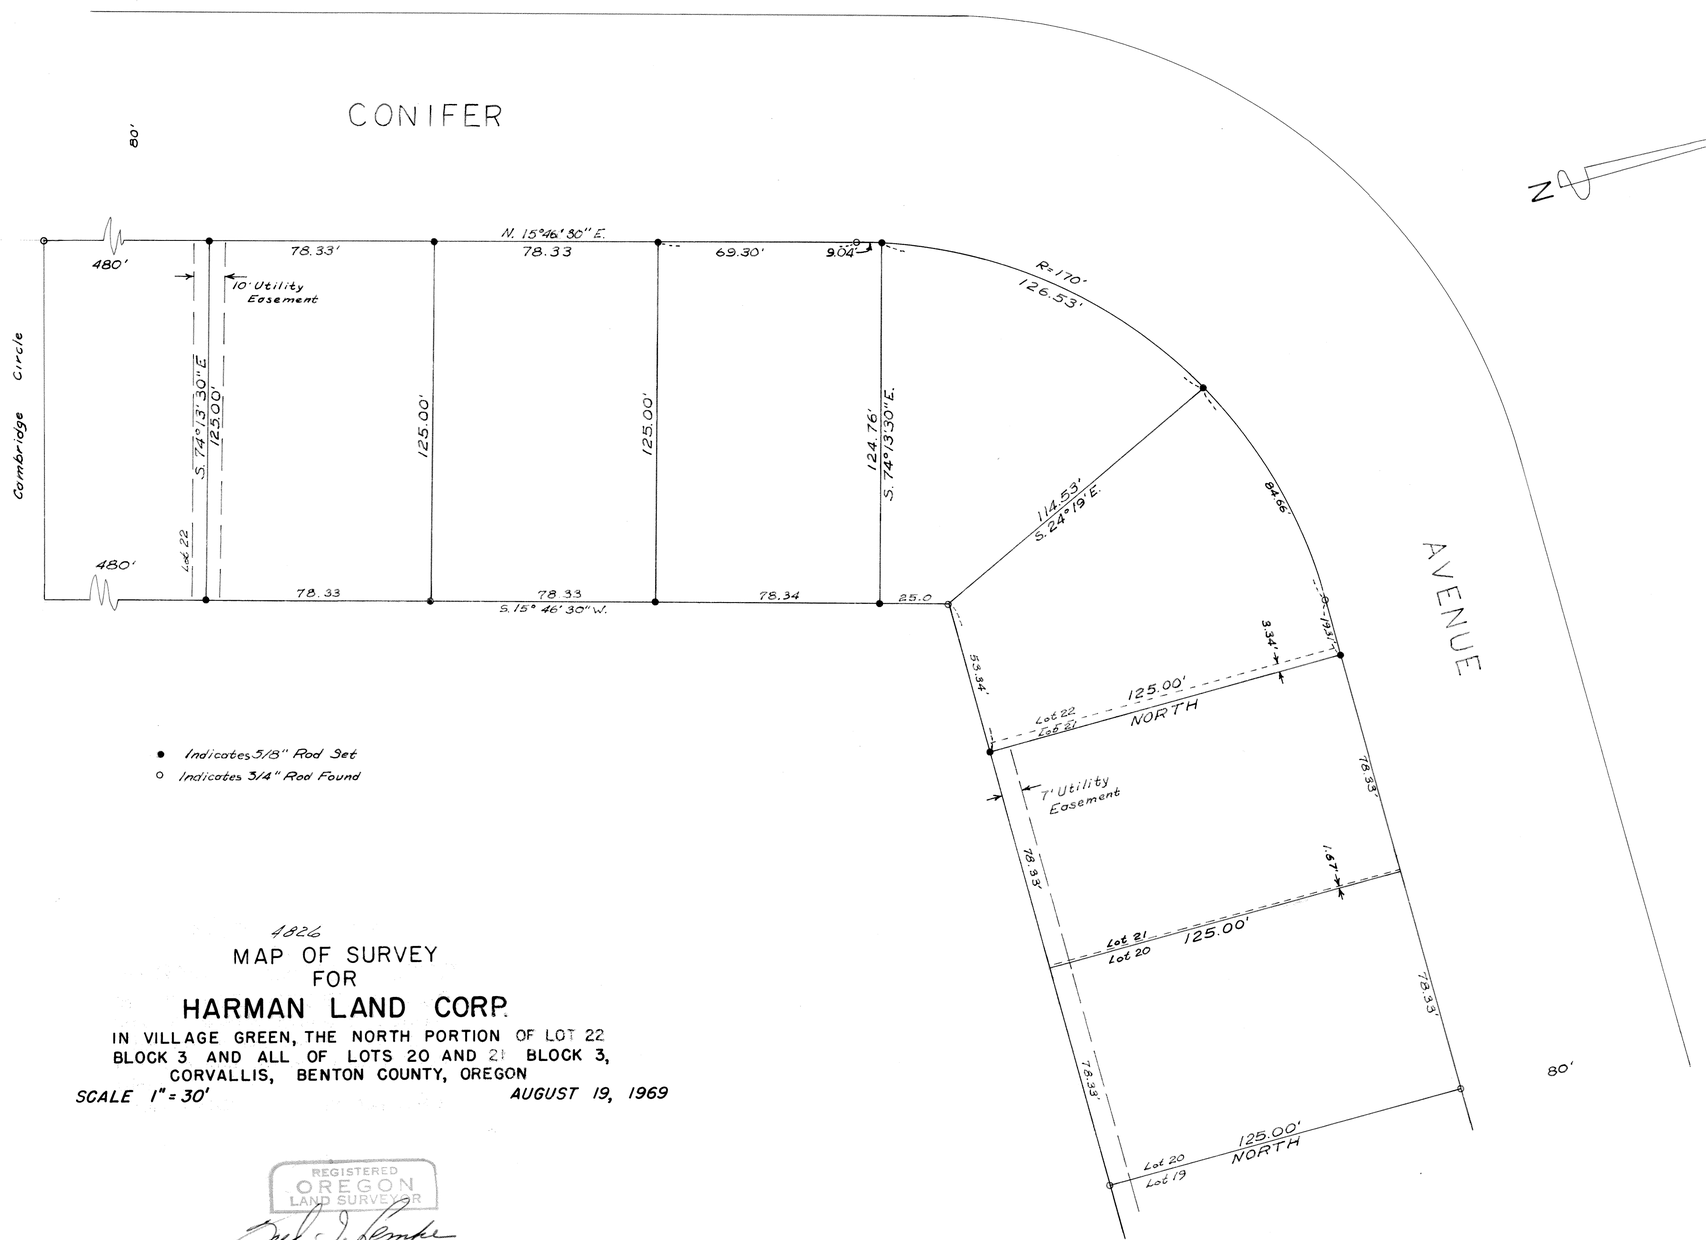

● Indicates 5/8" Rod Set
○ Indicates 3/4" Rod Found

4826

MAP OF SURVEY FOR HARMAN LAND CORP.

IN VILLAGE GREEN, THE NORTH PORTION OF LOT 22 BLOCK 3 AND ALL OF LOTS 20 AND 21 BLOCK 3, CORVALLIS, BENTON COUNTY, OREGON

SCALE 1" = 30'

AUGUST 19, 1969

REGISTERED OREGON LAND SURVEYOR
Fred J. Lemke
MAY 2, 1958
FRED I. LEMKE
443