4858

4858

CS 4858

HOWARD L. ROPP

NE 1/4 SECTION 1, T.11S., R.4 W., W.M., BENTON COUNTY, OREGON

Scale 1"= 100'

February 14, 1970

BEARINGS BASED ON SOLAR OBSERVATION

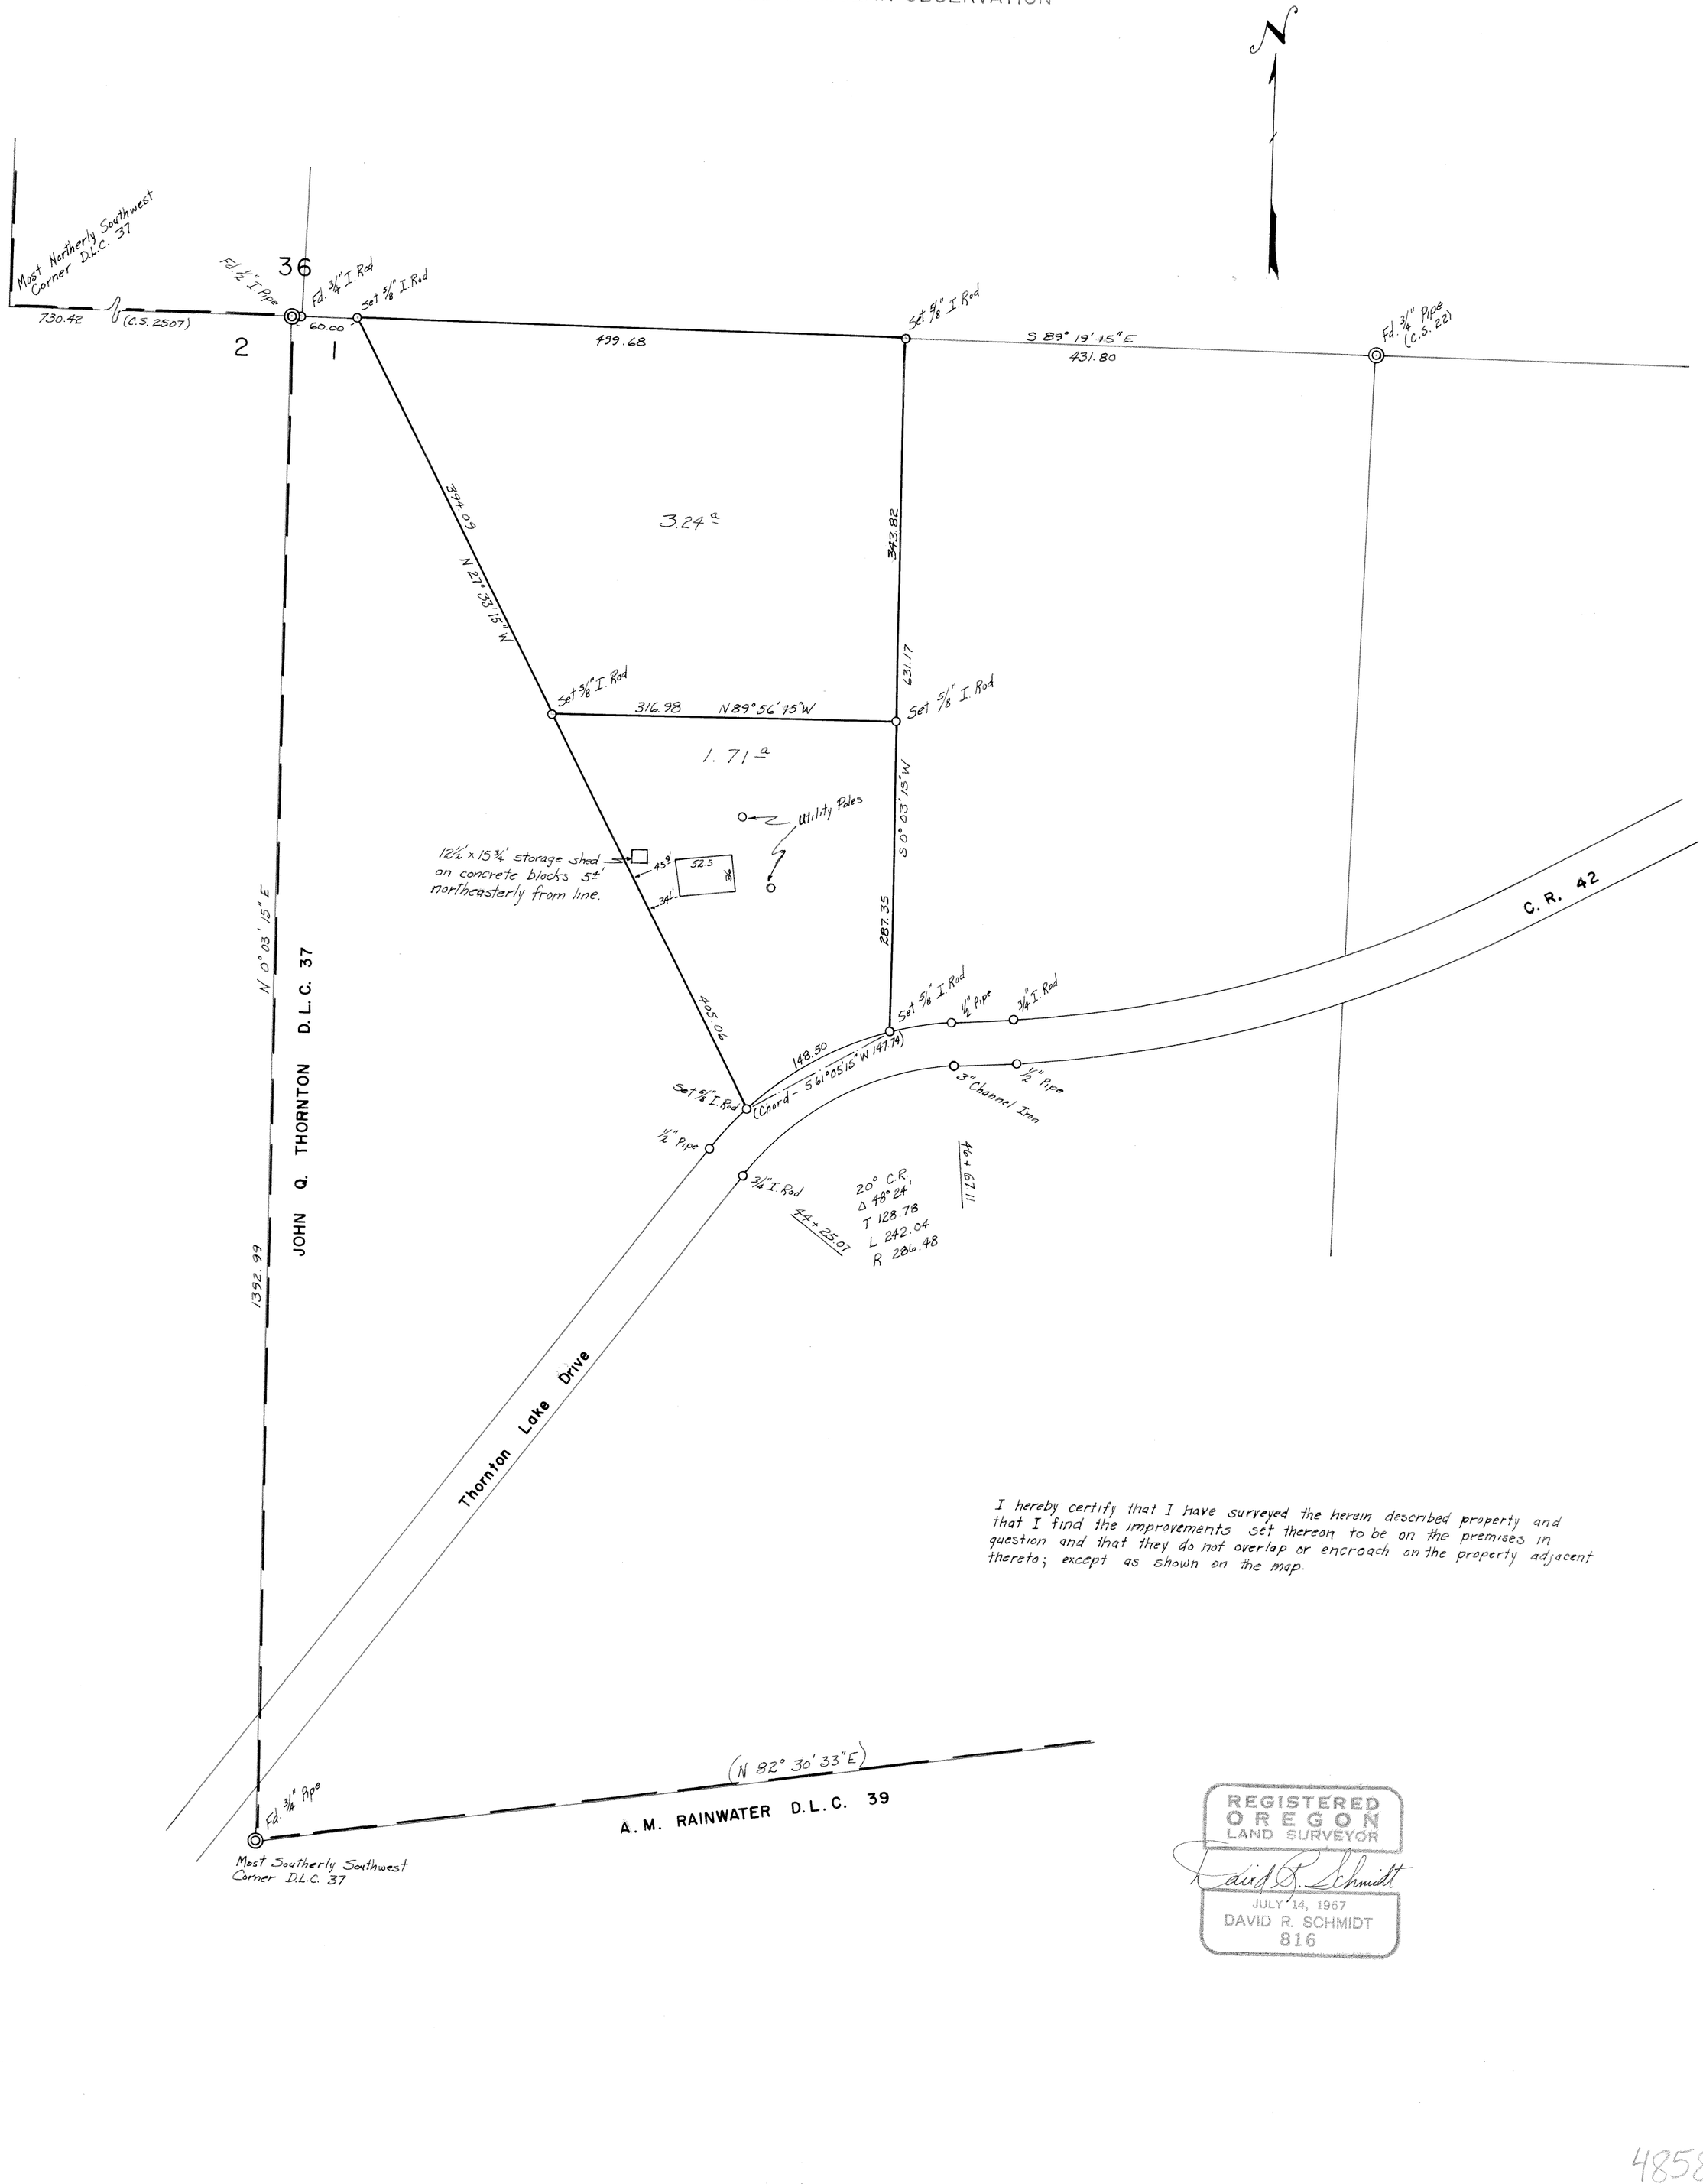

I hereby certify that I have surveyed the herein described property and that I find the improvements set thereon to be on the premises in question and that they do not overlap or encroach on the property adjacent thereto; except as shown on the map.

REGISTERED
OREGON
LAND SURVEYOR

David R. Schmidt

JULY 14, 1967
DAVID R. SCHMIDT
816

4858