
SURVEY FOR

Wm. V. ALLEN

OSCAR CLARK D.L.C. No. 42

T 11 S R 5 W WM

BENTON COUNTY OREGON

SCALE 1" = 50' APRIL 1970

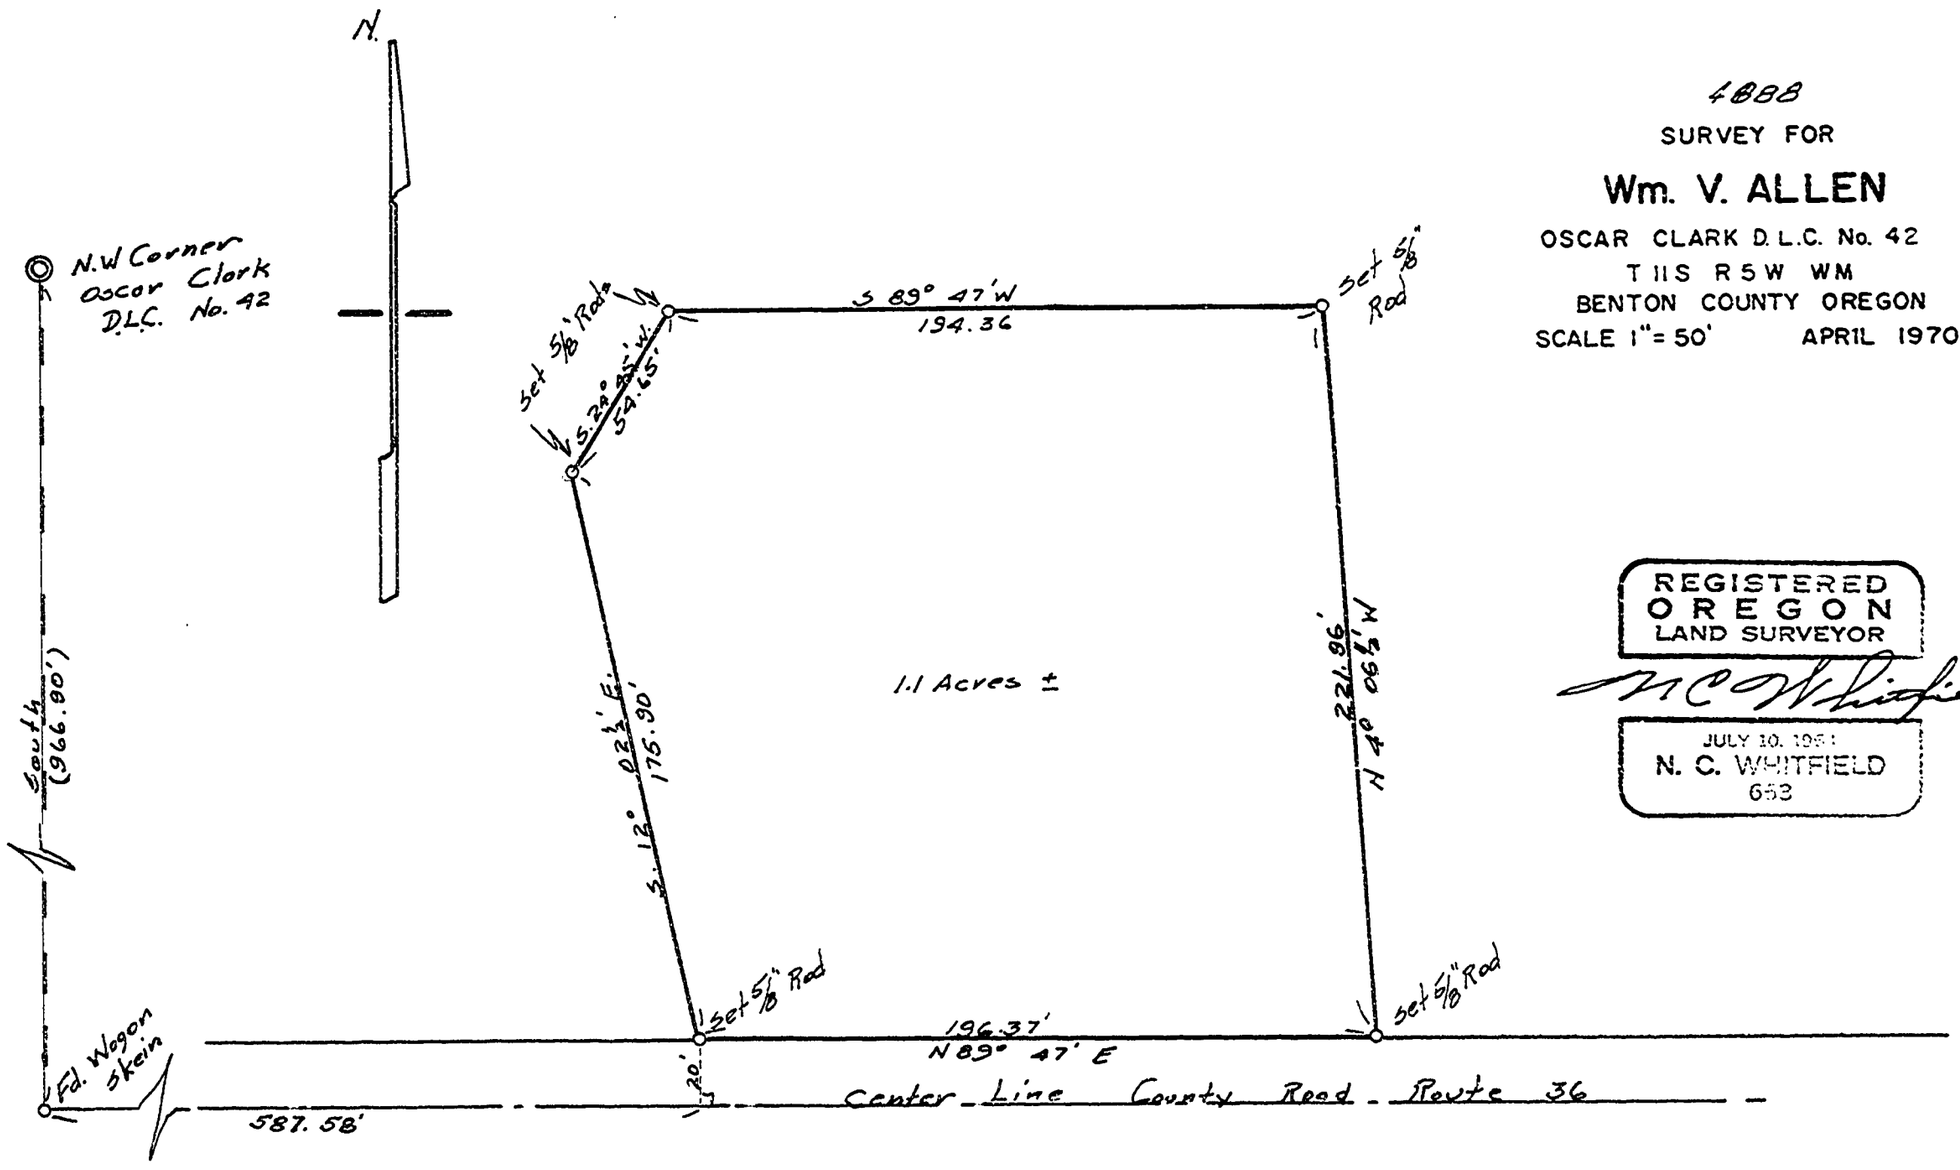

REGISTERED
OREGON
LAND SURVEYOR

N C Whitfield

JULY 30, 1951
N. C. WHITFIELD
653