4928

C. O. MAYS

SEC. 22, T.11S., R.6W., W.M.

SCALE : 1" = 400' MAY 30, '70

BERT W. UDELL RPE # 2301

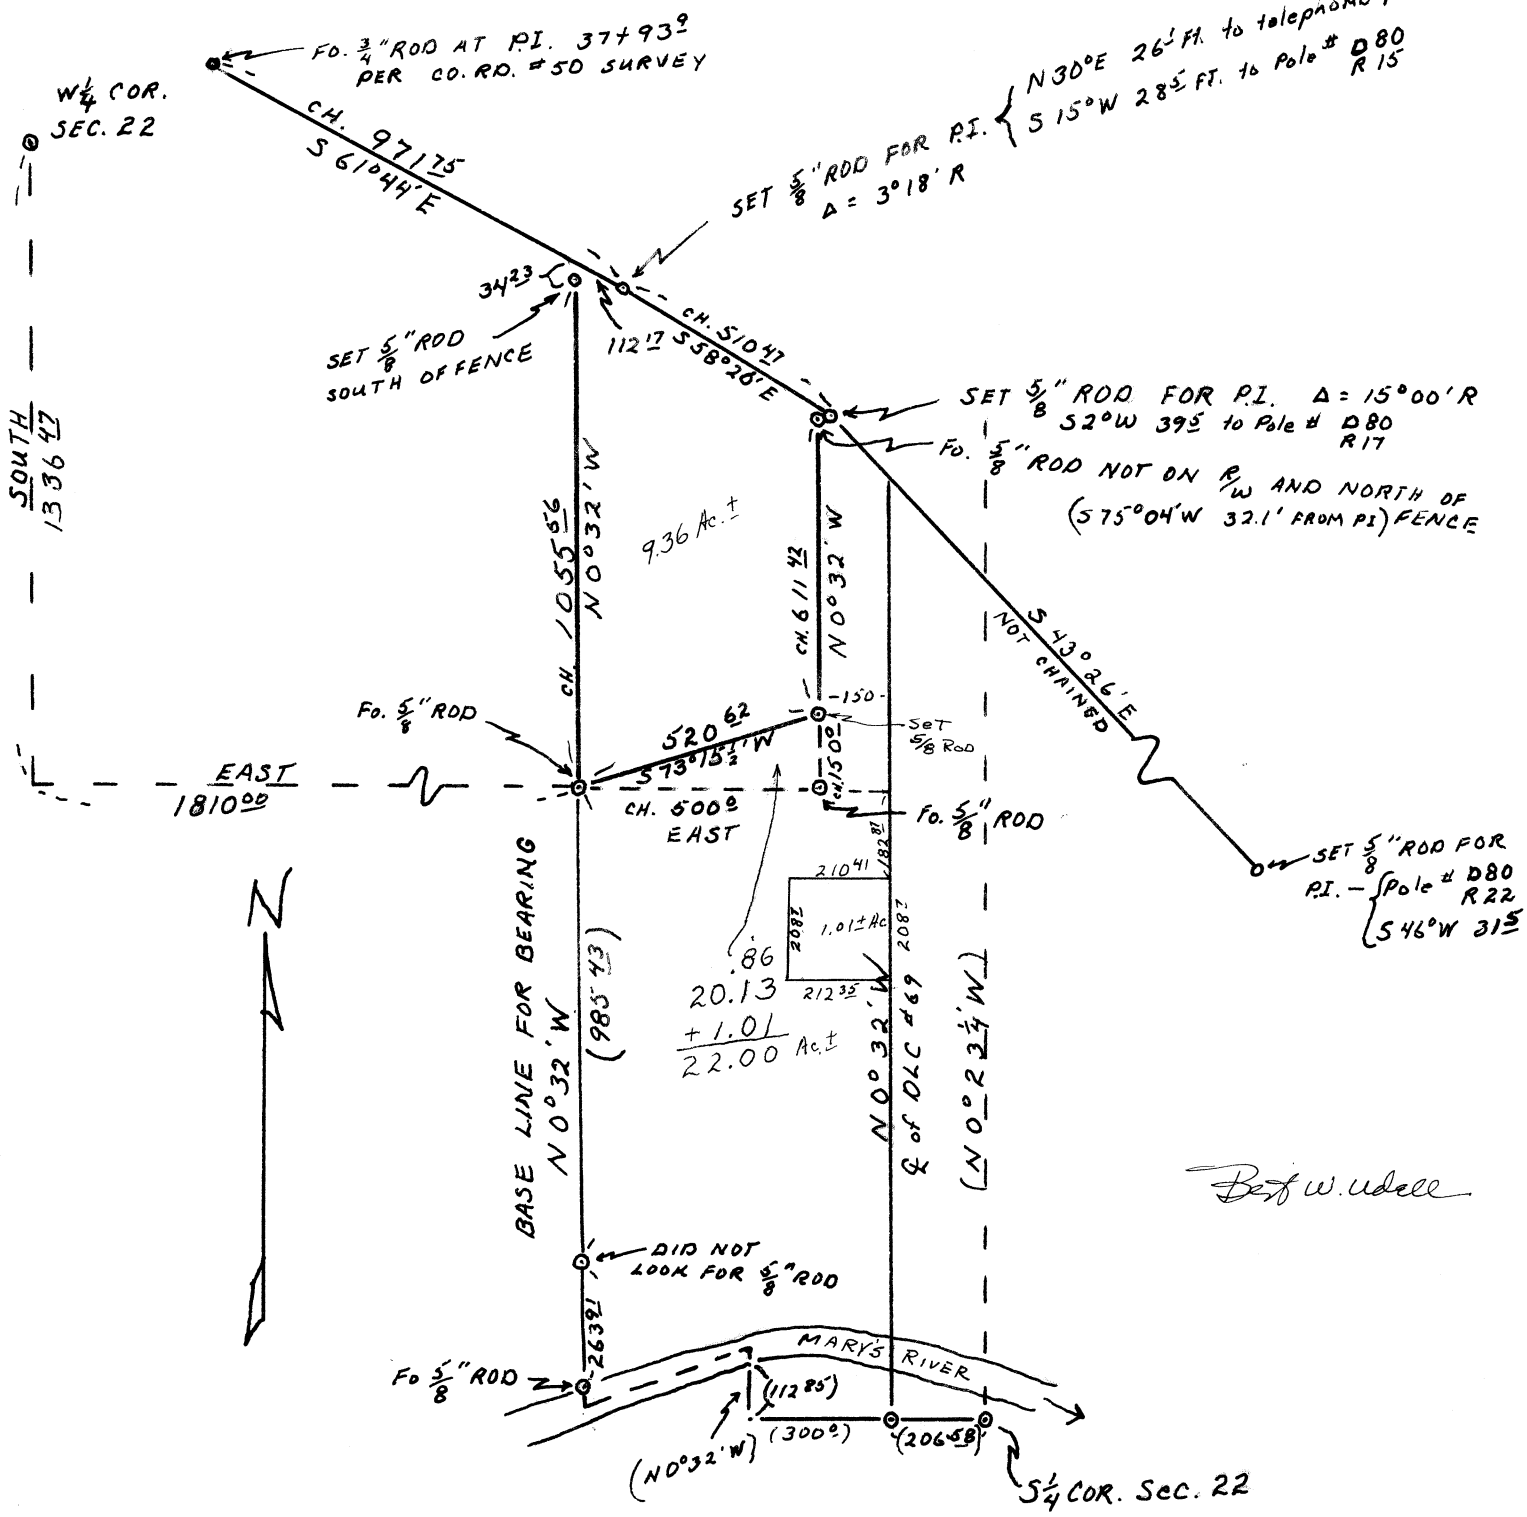

Bert W. Udell