4946

4946

4946

SURVEY
FOR
CITY OF CORVALLIS

IN THE JOSEPH ALEXANDER C.L. 46.

T. 12 S., R. 5 W., W. M.

BENTON COUNTY, OREGON

SURVEYED: NOVEMBER 14, 1969

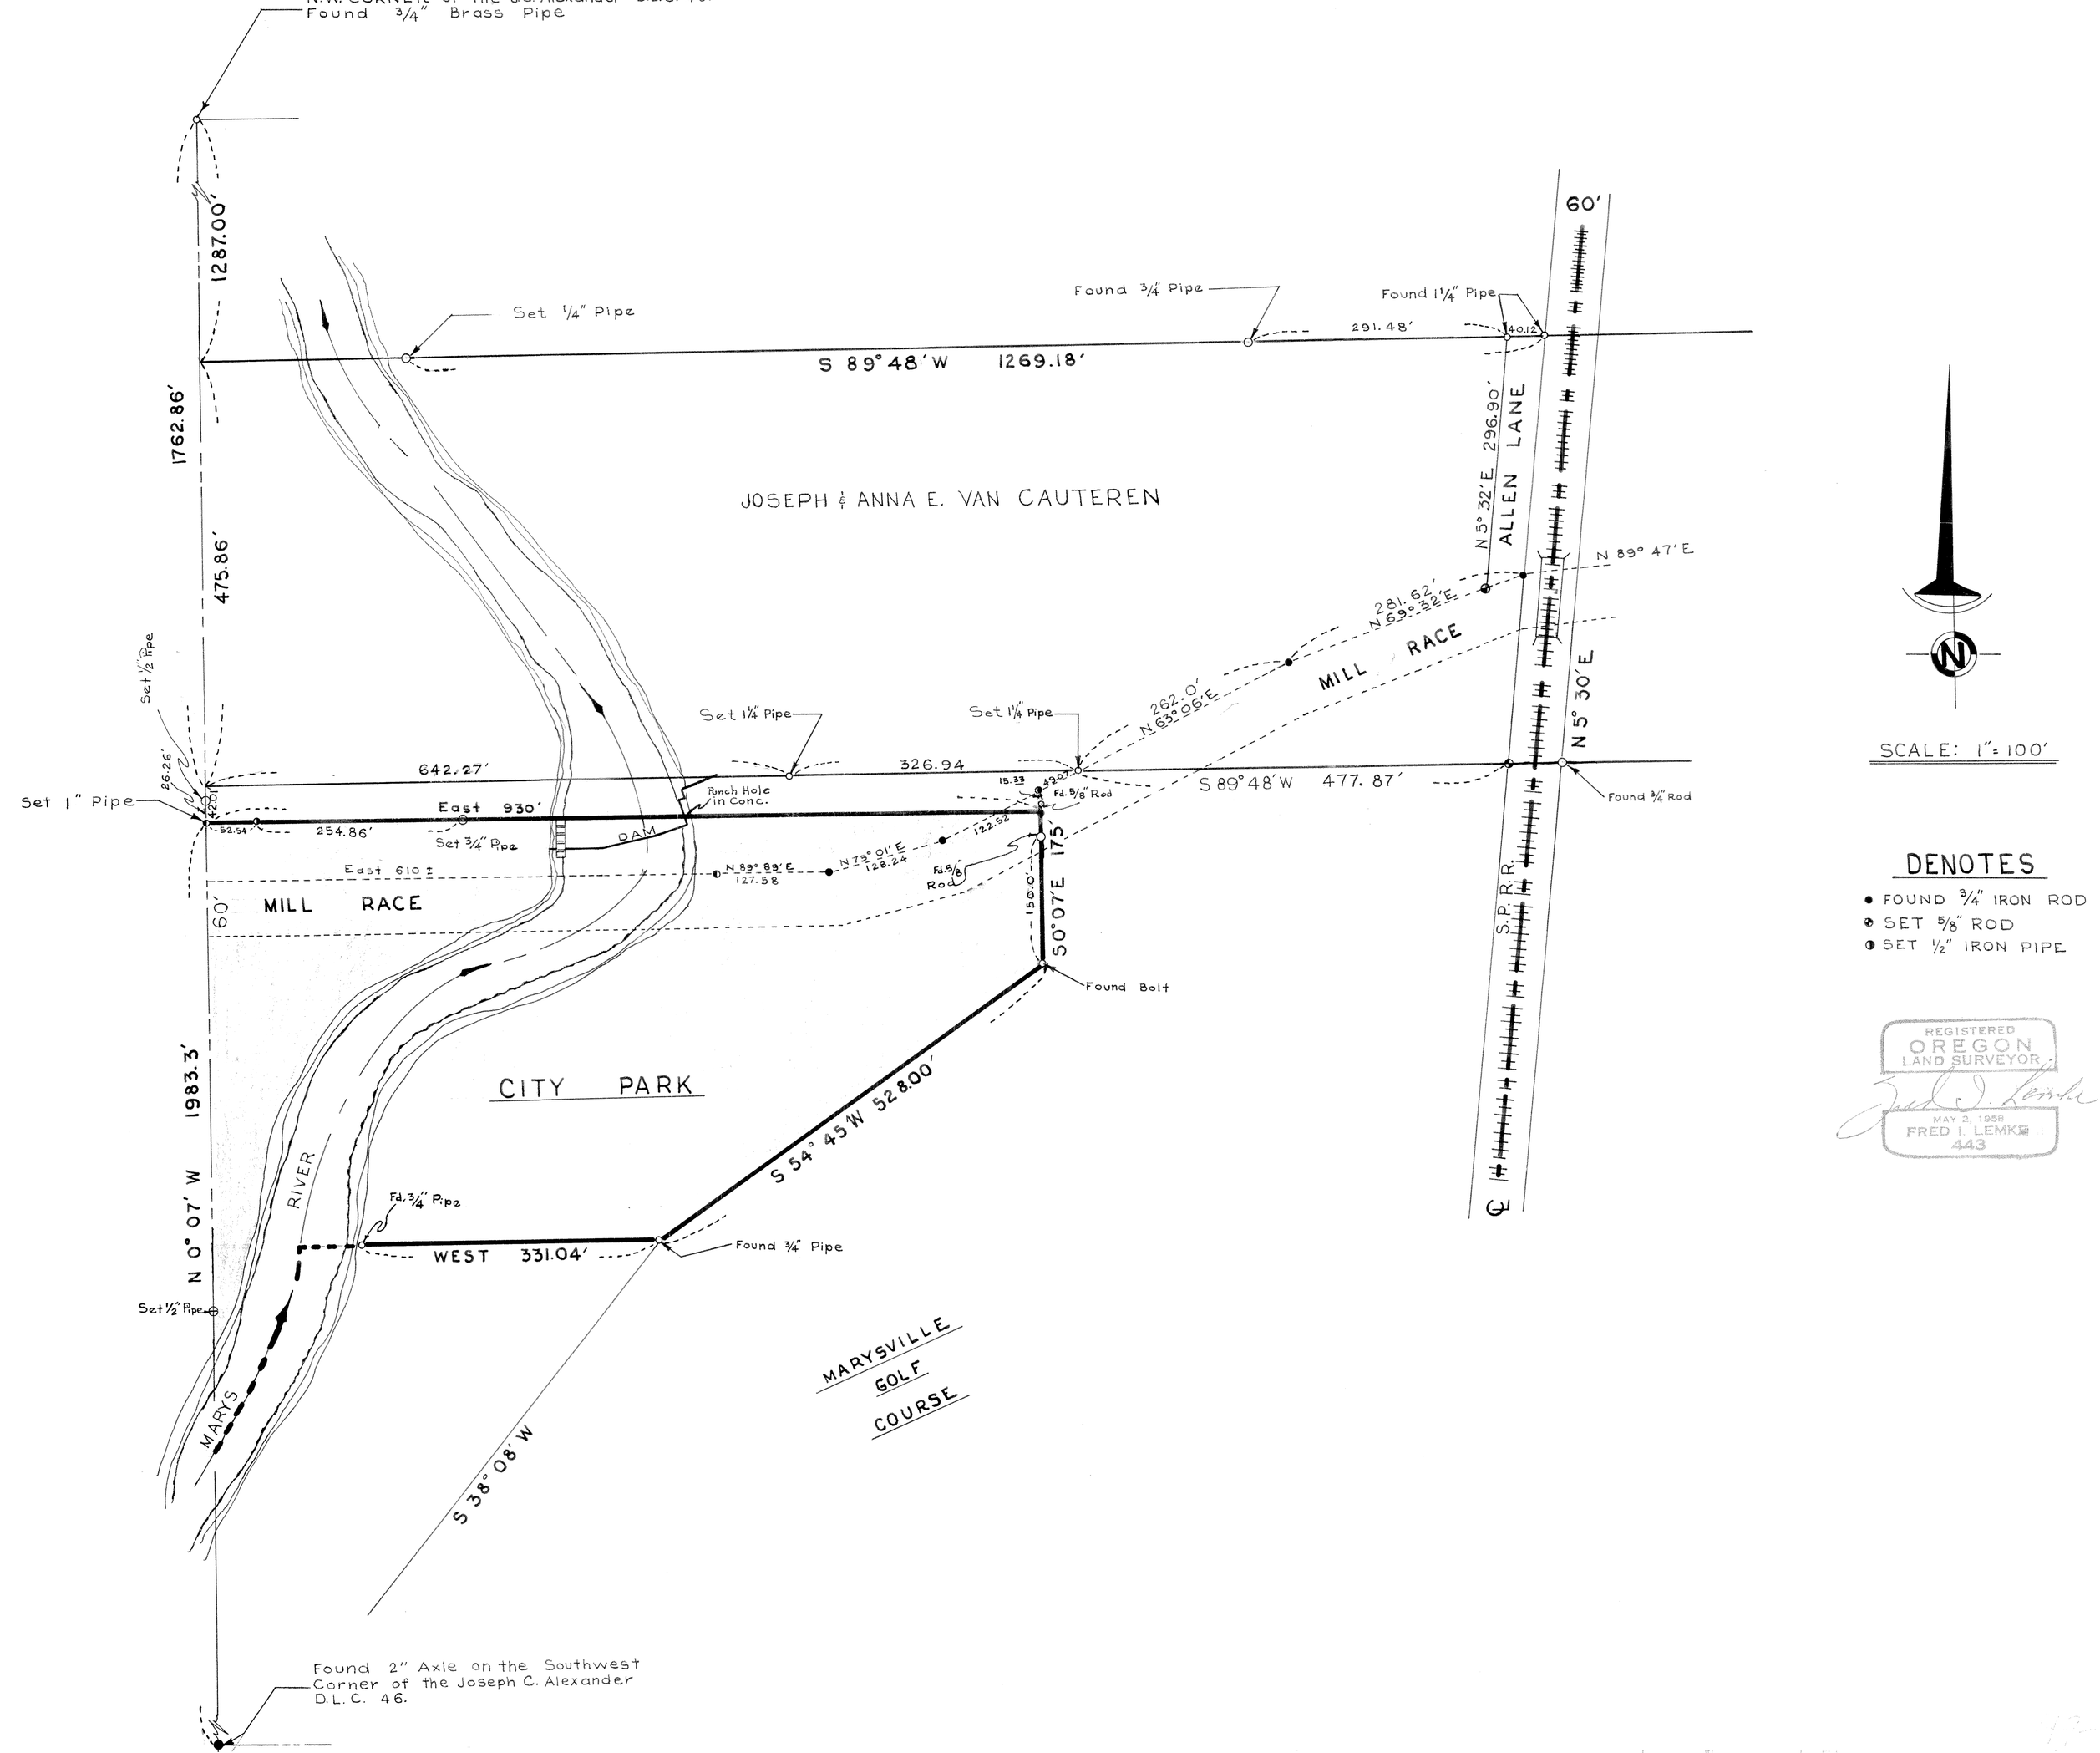

SCALE: 1" = 100'

DENOTES

- ● FOUND 3/4" IRON ROD
- ◉ SET 5/8" ROD
- ◑ SET 1/2" IRON PIPE

REGISTERED
OREGON
LAND SURVEYOR

MAY 2, 1958
FRED I. LEMKE
443