5136

Record of Survey
for
WILLIAM K. LARSEN
in
Braden Tracts
J. Q. Thornton D.L.C. 37
T. 10 S., R. 4 W., W.B.&M
Benton County, Oregon
Scale: 1"=100' January 12, 1971
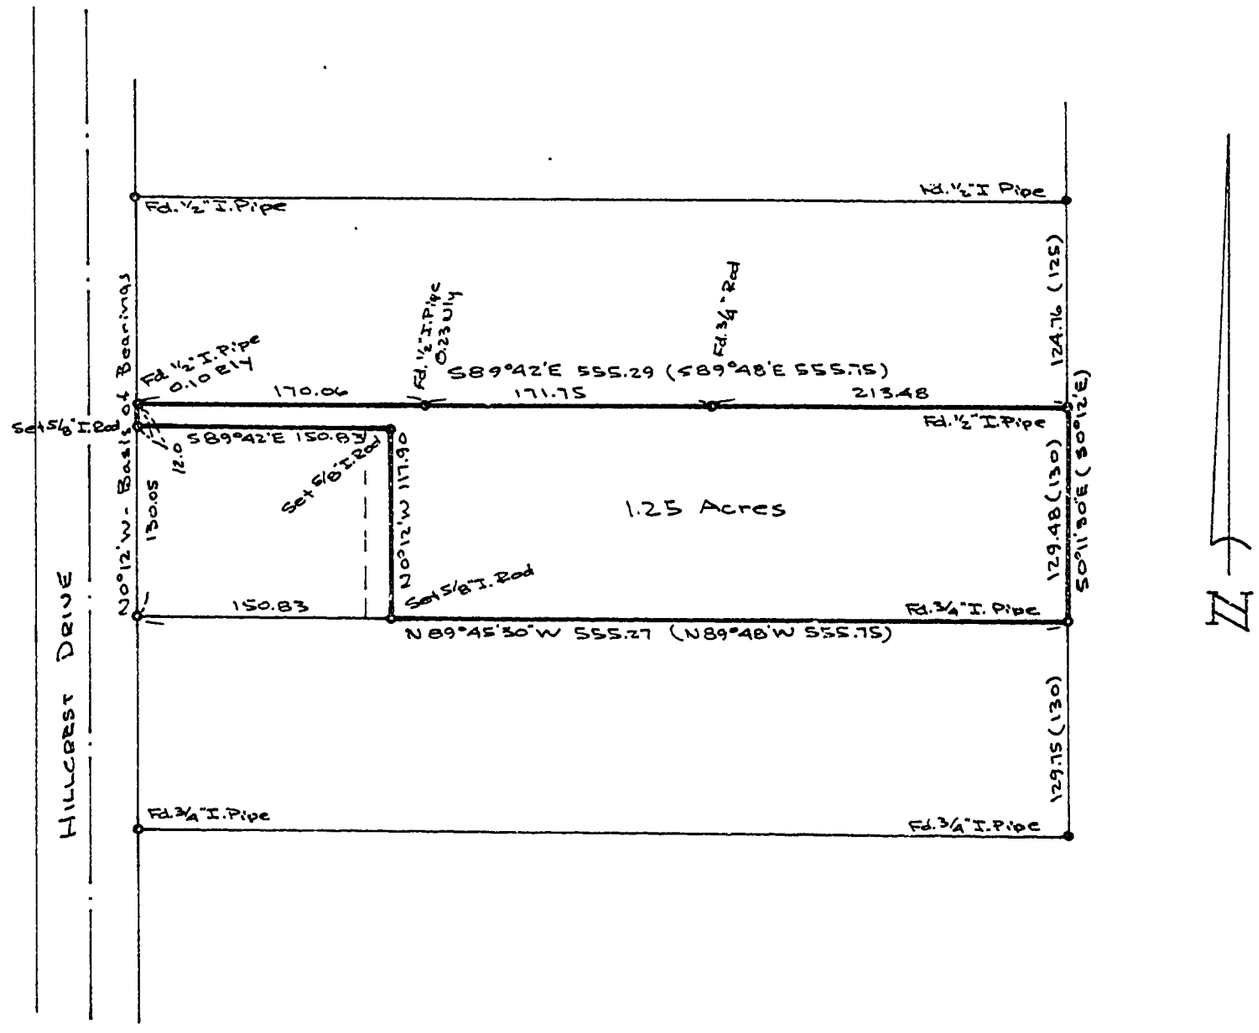
REGISTERED
OREGON
LAND SURVEYOR
Verle C. Moore
MAY 13, 1960
VERLE C. MOORE
501