5266

CARL BENNETT

Wm. MATZGER D.L.C. No. 50, T. 12S., R. 6W., Will. Mer. BENTON COUNTY, ORE.

Scale : 1" = 200' April 26, 1972.
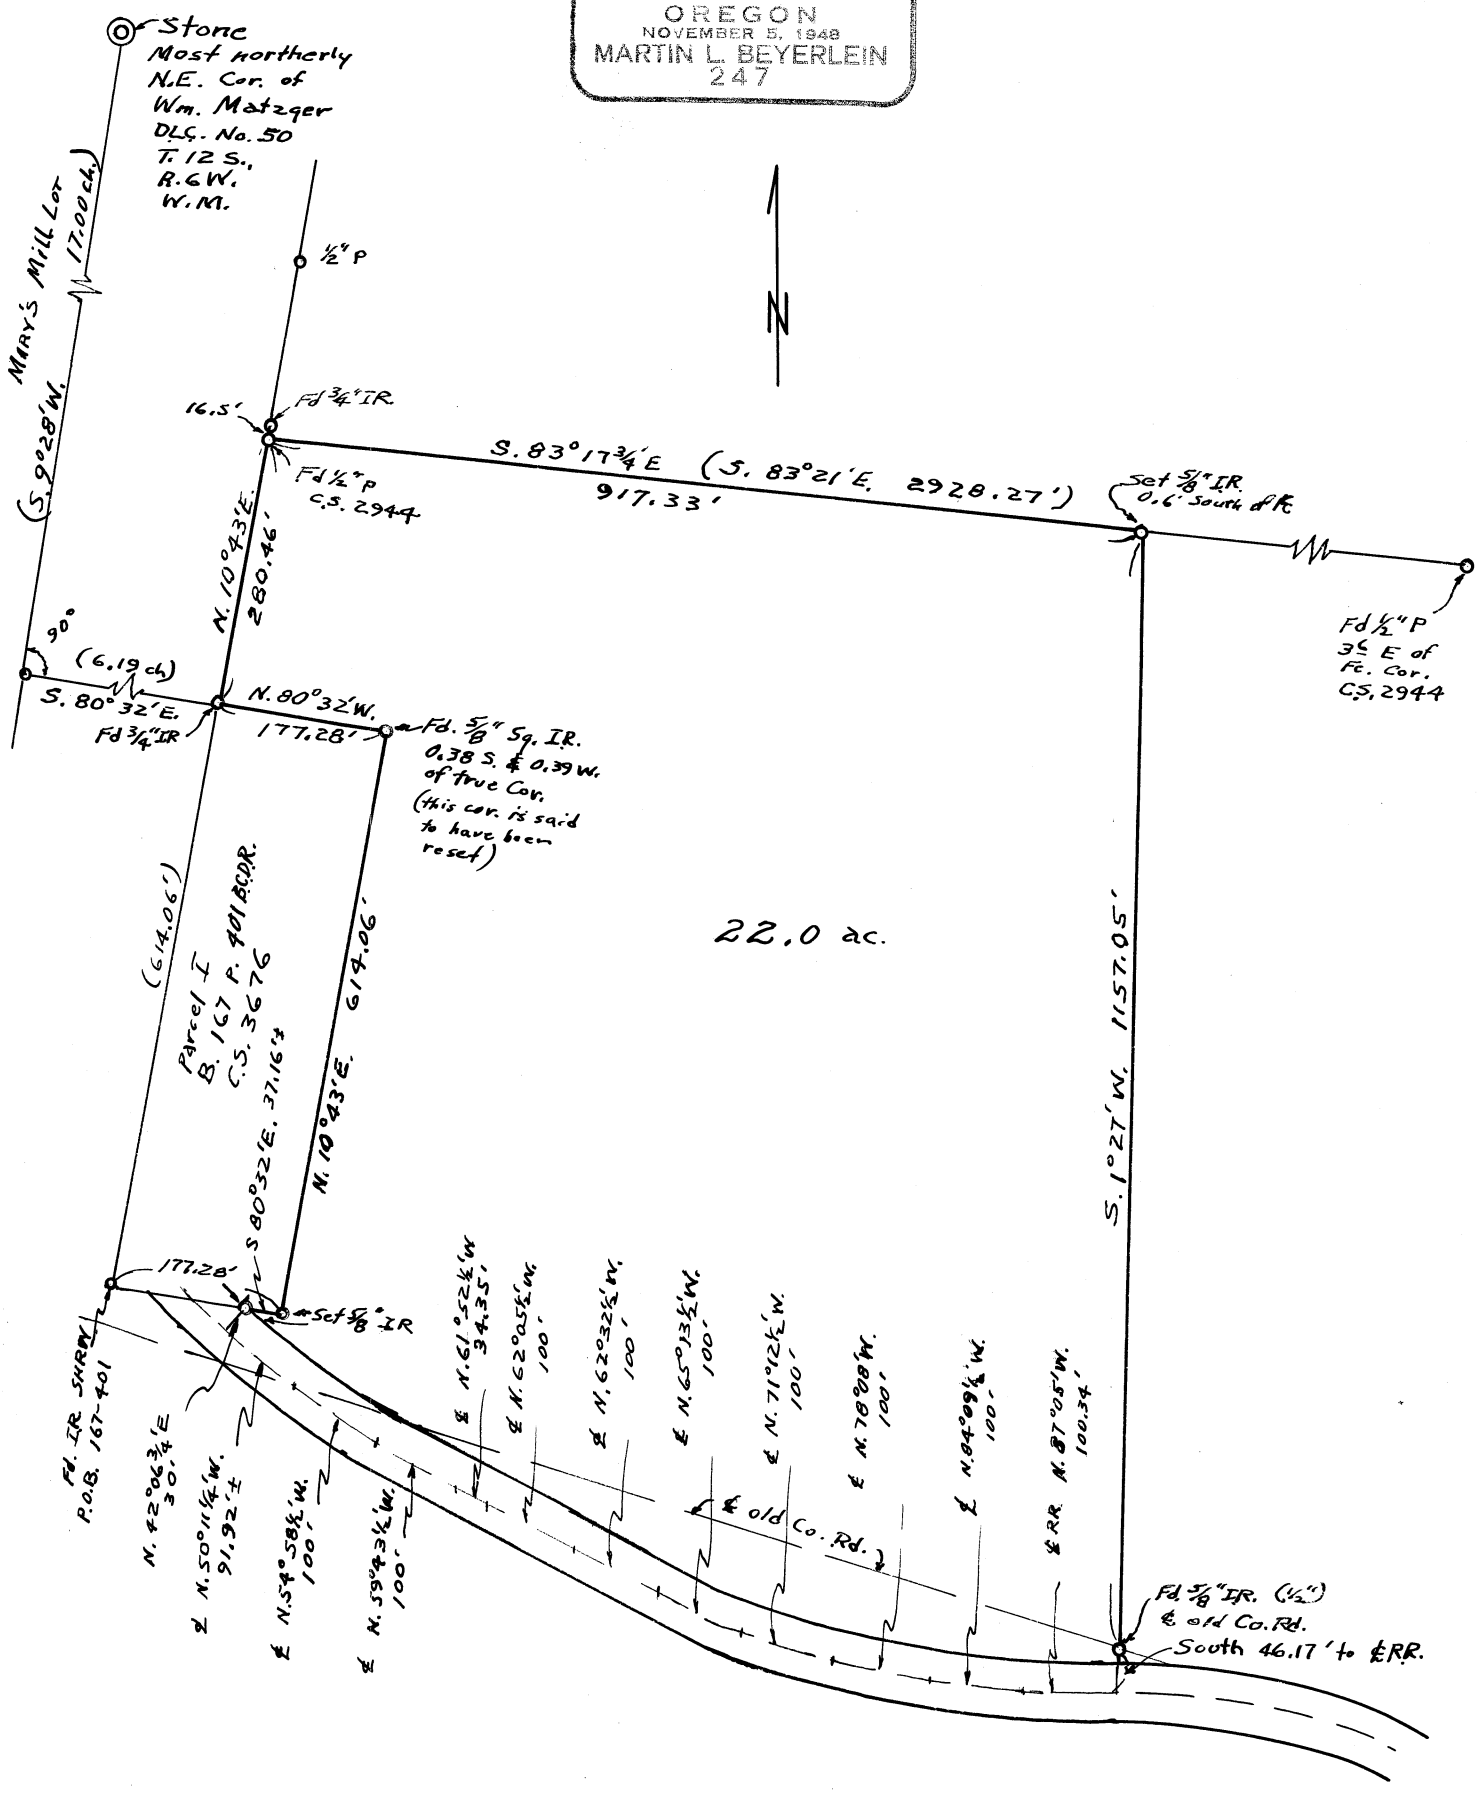
REGISTERED PROFESSIONAL LAND SURVEYOR
Martin L. Beyerlein
OREGON
NOVEMBER 5, 1948
MARTIN L. BEYERLEIN
247