5312

5312

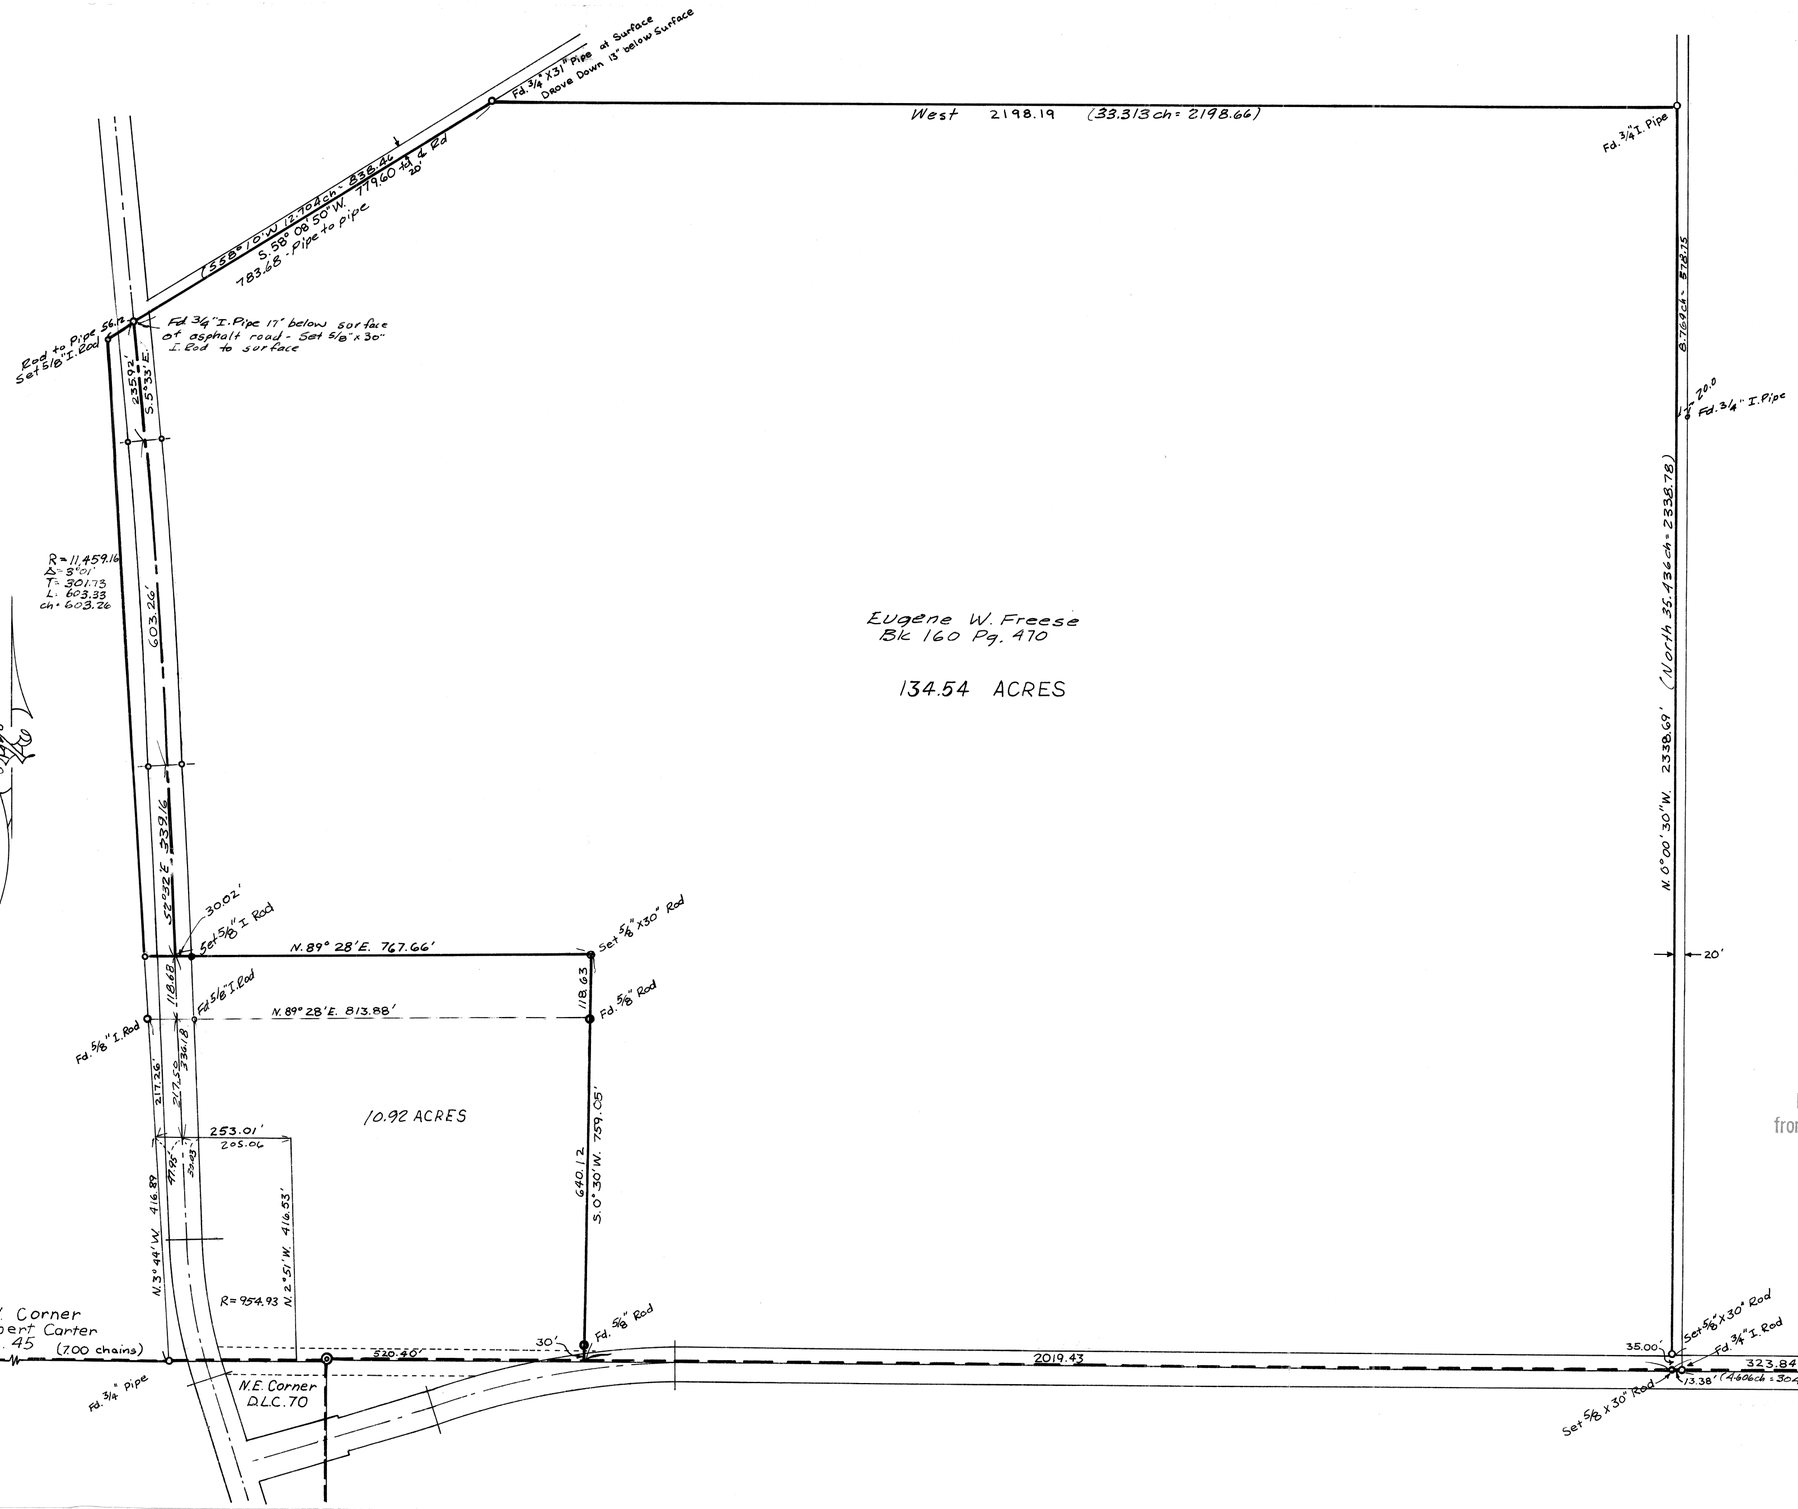

5312

Record of Survey
for
EUGENE FREESE
in the
Tolbert Carter D.L.C. 45
East Half of Sec. 21, T.10S., R.4 W., W.M.
Benton County
Scale: 1" = 200' MAY 19, 1972

Parentheses indicate information from County Survey records or deeds.

REGISTERED
PROFESSIONAL
LAND SURVEYOR
Verle C. Moore
OREGON
MAY 13, 1960
VERLE C. MOORE
501