5324

5324

5324

Survey for

COLLEGE UNITED METHODIST CHURCH

In PHILOMATH, Benton County, Oregon

September 6, 1972 **Rev. Sept. 19, 1972**

SCALE: 1" = 60'

REGISTERED PROFESSIONAL LAND SURVEYOR

Fred I. Lemhe

OREGON

- ○ Denotes 5/8" rod set
- ● Denotes 3/4" pipe found
- ◀ Denotes 1/2" pipe

Basis of bearings is ℄ 10th street

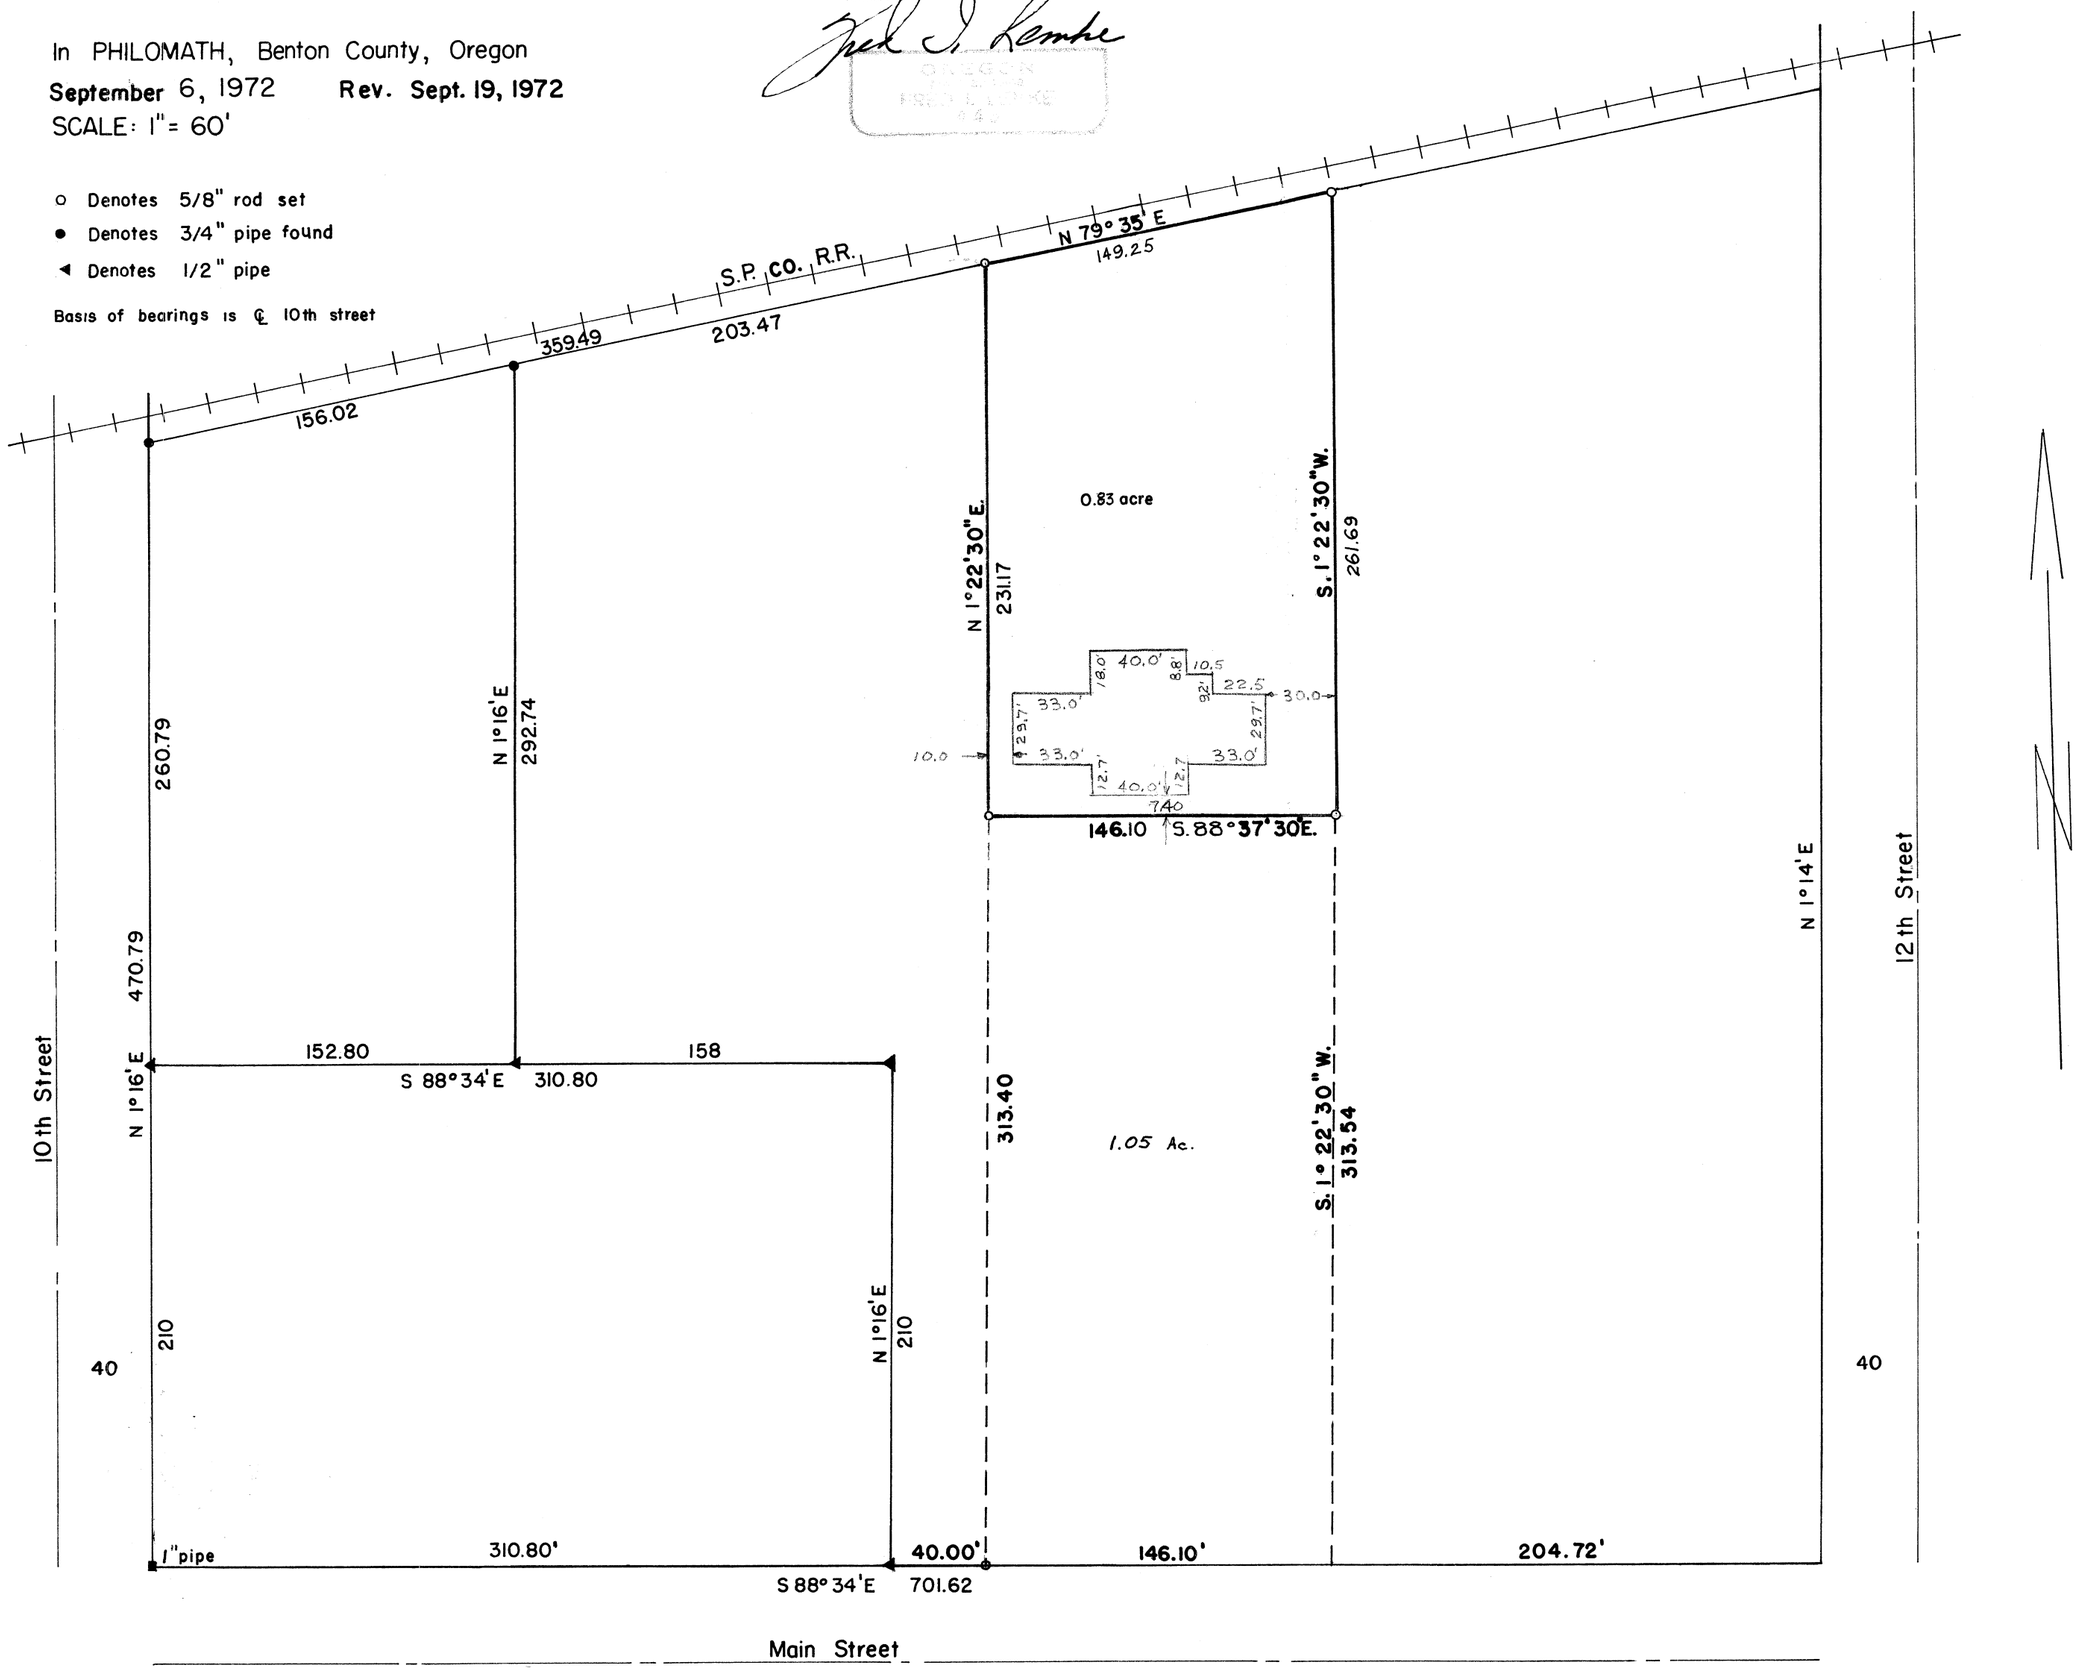

5324