5498

5498

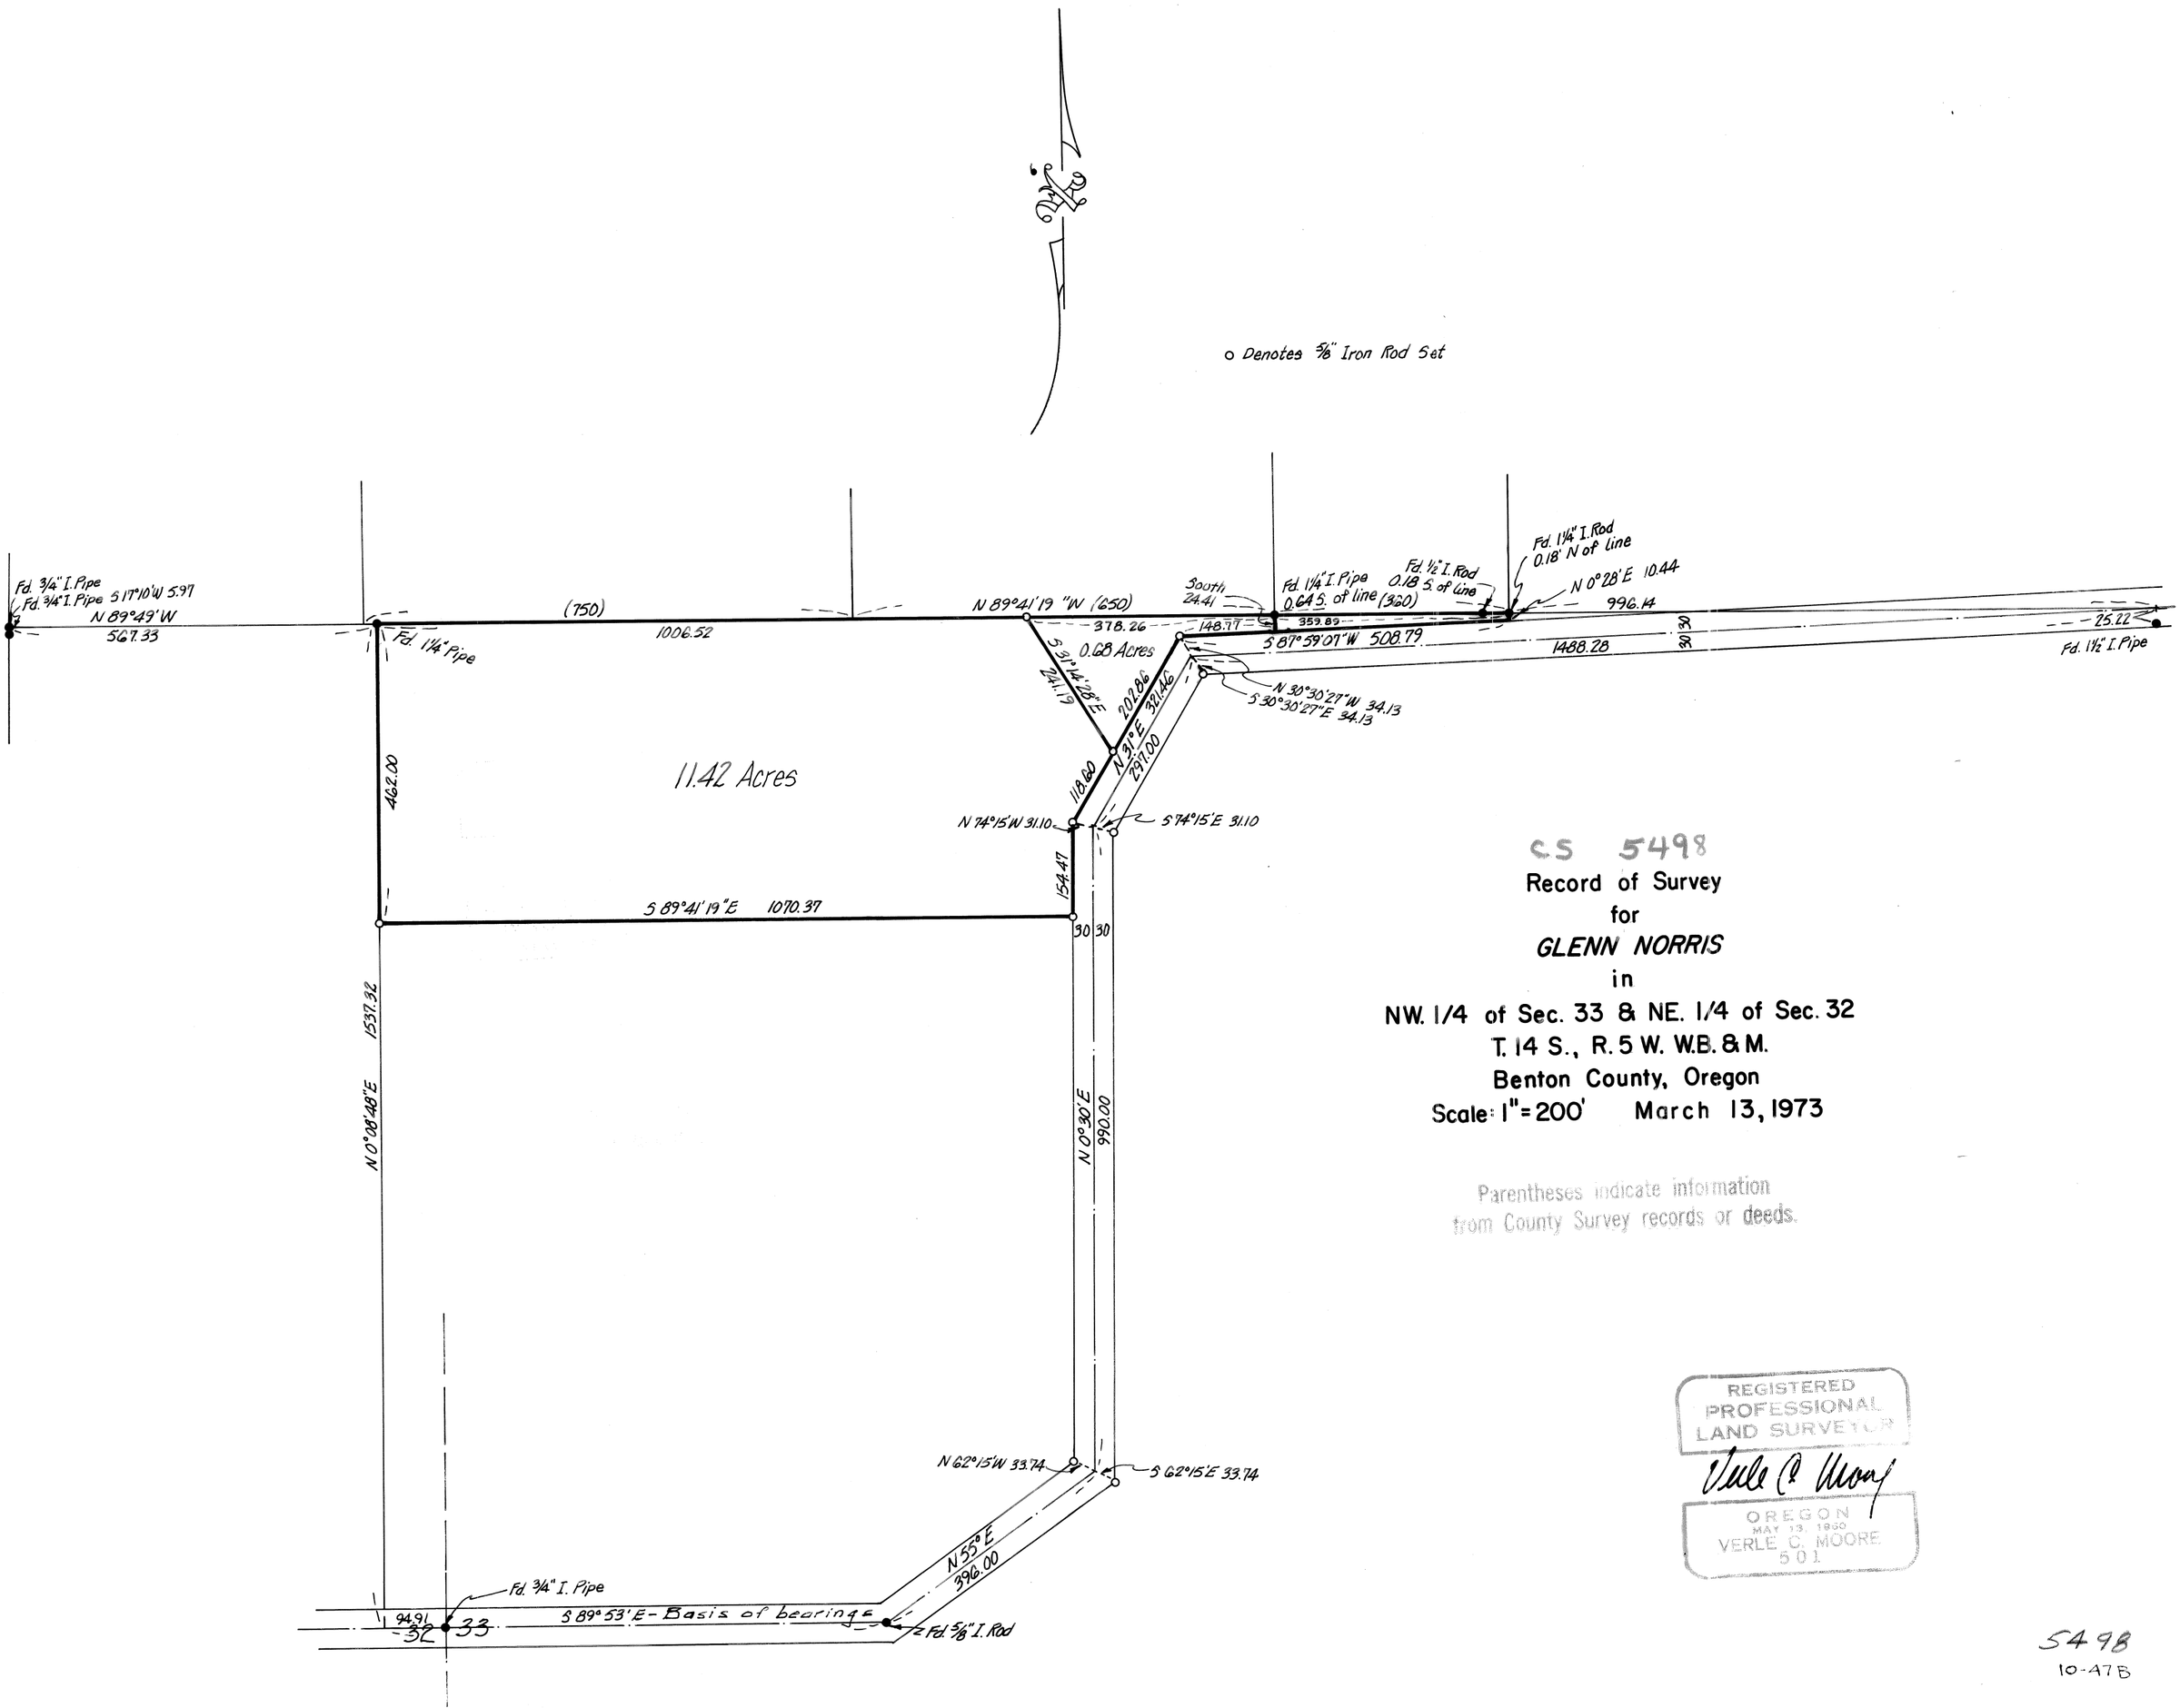

CS 5498

Record of Survey
for
GLENN NORRIS
in
NW. 1/4 of Sec. 33 & NE. 1/4 of Sec. 32
T. 14 S., R. 5 W. W.B. & M.
Benton County, Oregon
Scale: 1" = 200' March 13, 1973

Parentheses indicate information
from County Survey records or deeds.

REGISTERED
PROFESSIONAL
LAND SURVEYOR
Verle C. Moore
OREGON
MAY 13, 1960
VERLE C. MOORE
501

5498
10-47B