5608

5608

STARKER FORESTS

SECTION 2, T. 12 S., R. 7 W., W.M.
Benton County, Oregon

SCALE: 1" = 500'

JANUARY 16, 1974

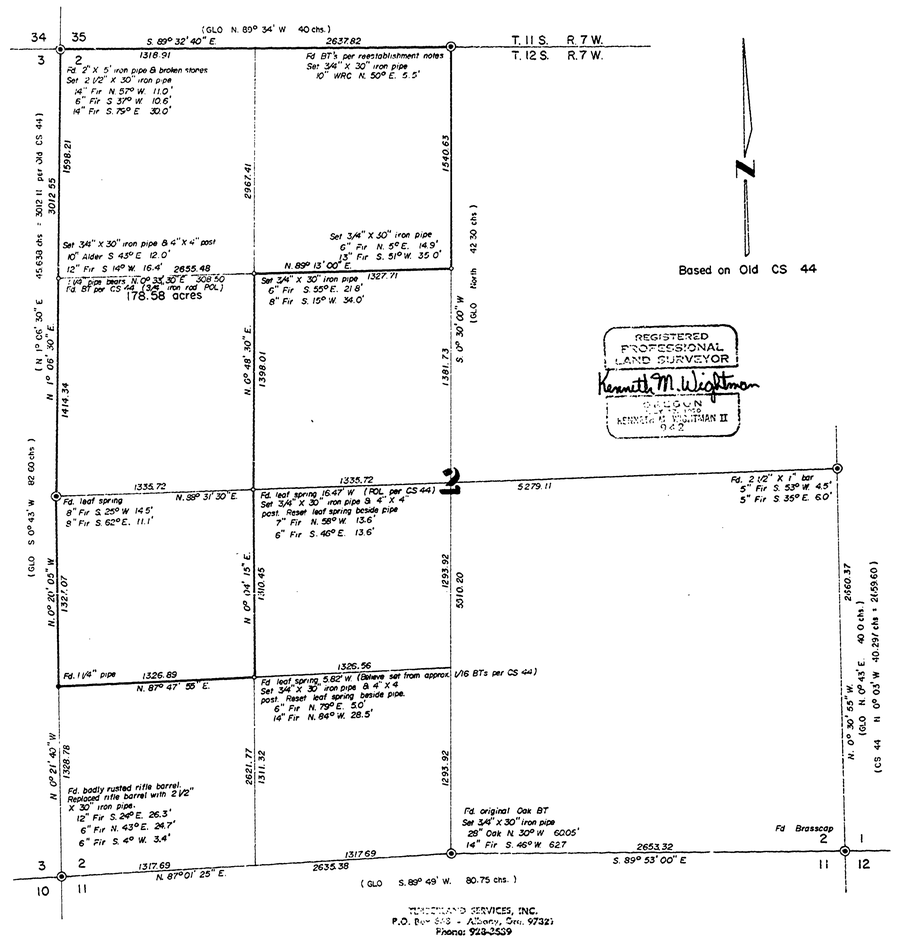

TERRELAND SERVICES, INC.
P.O. Box 548 - Albany, Ore. 97321
Phone: 928-2539