5674

5674

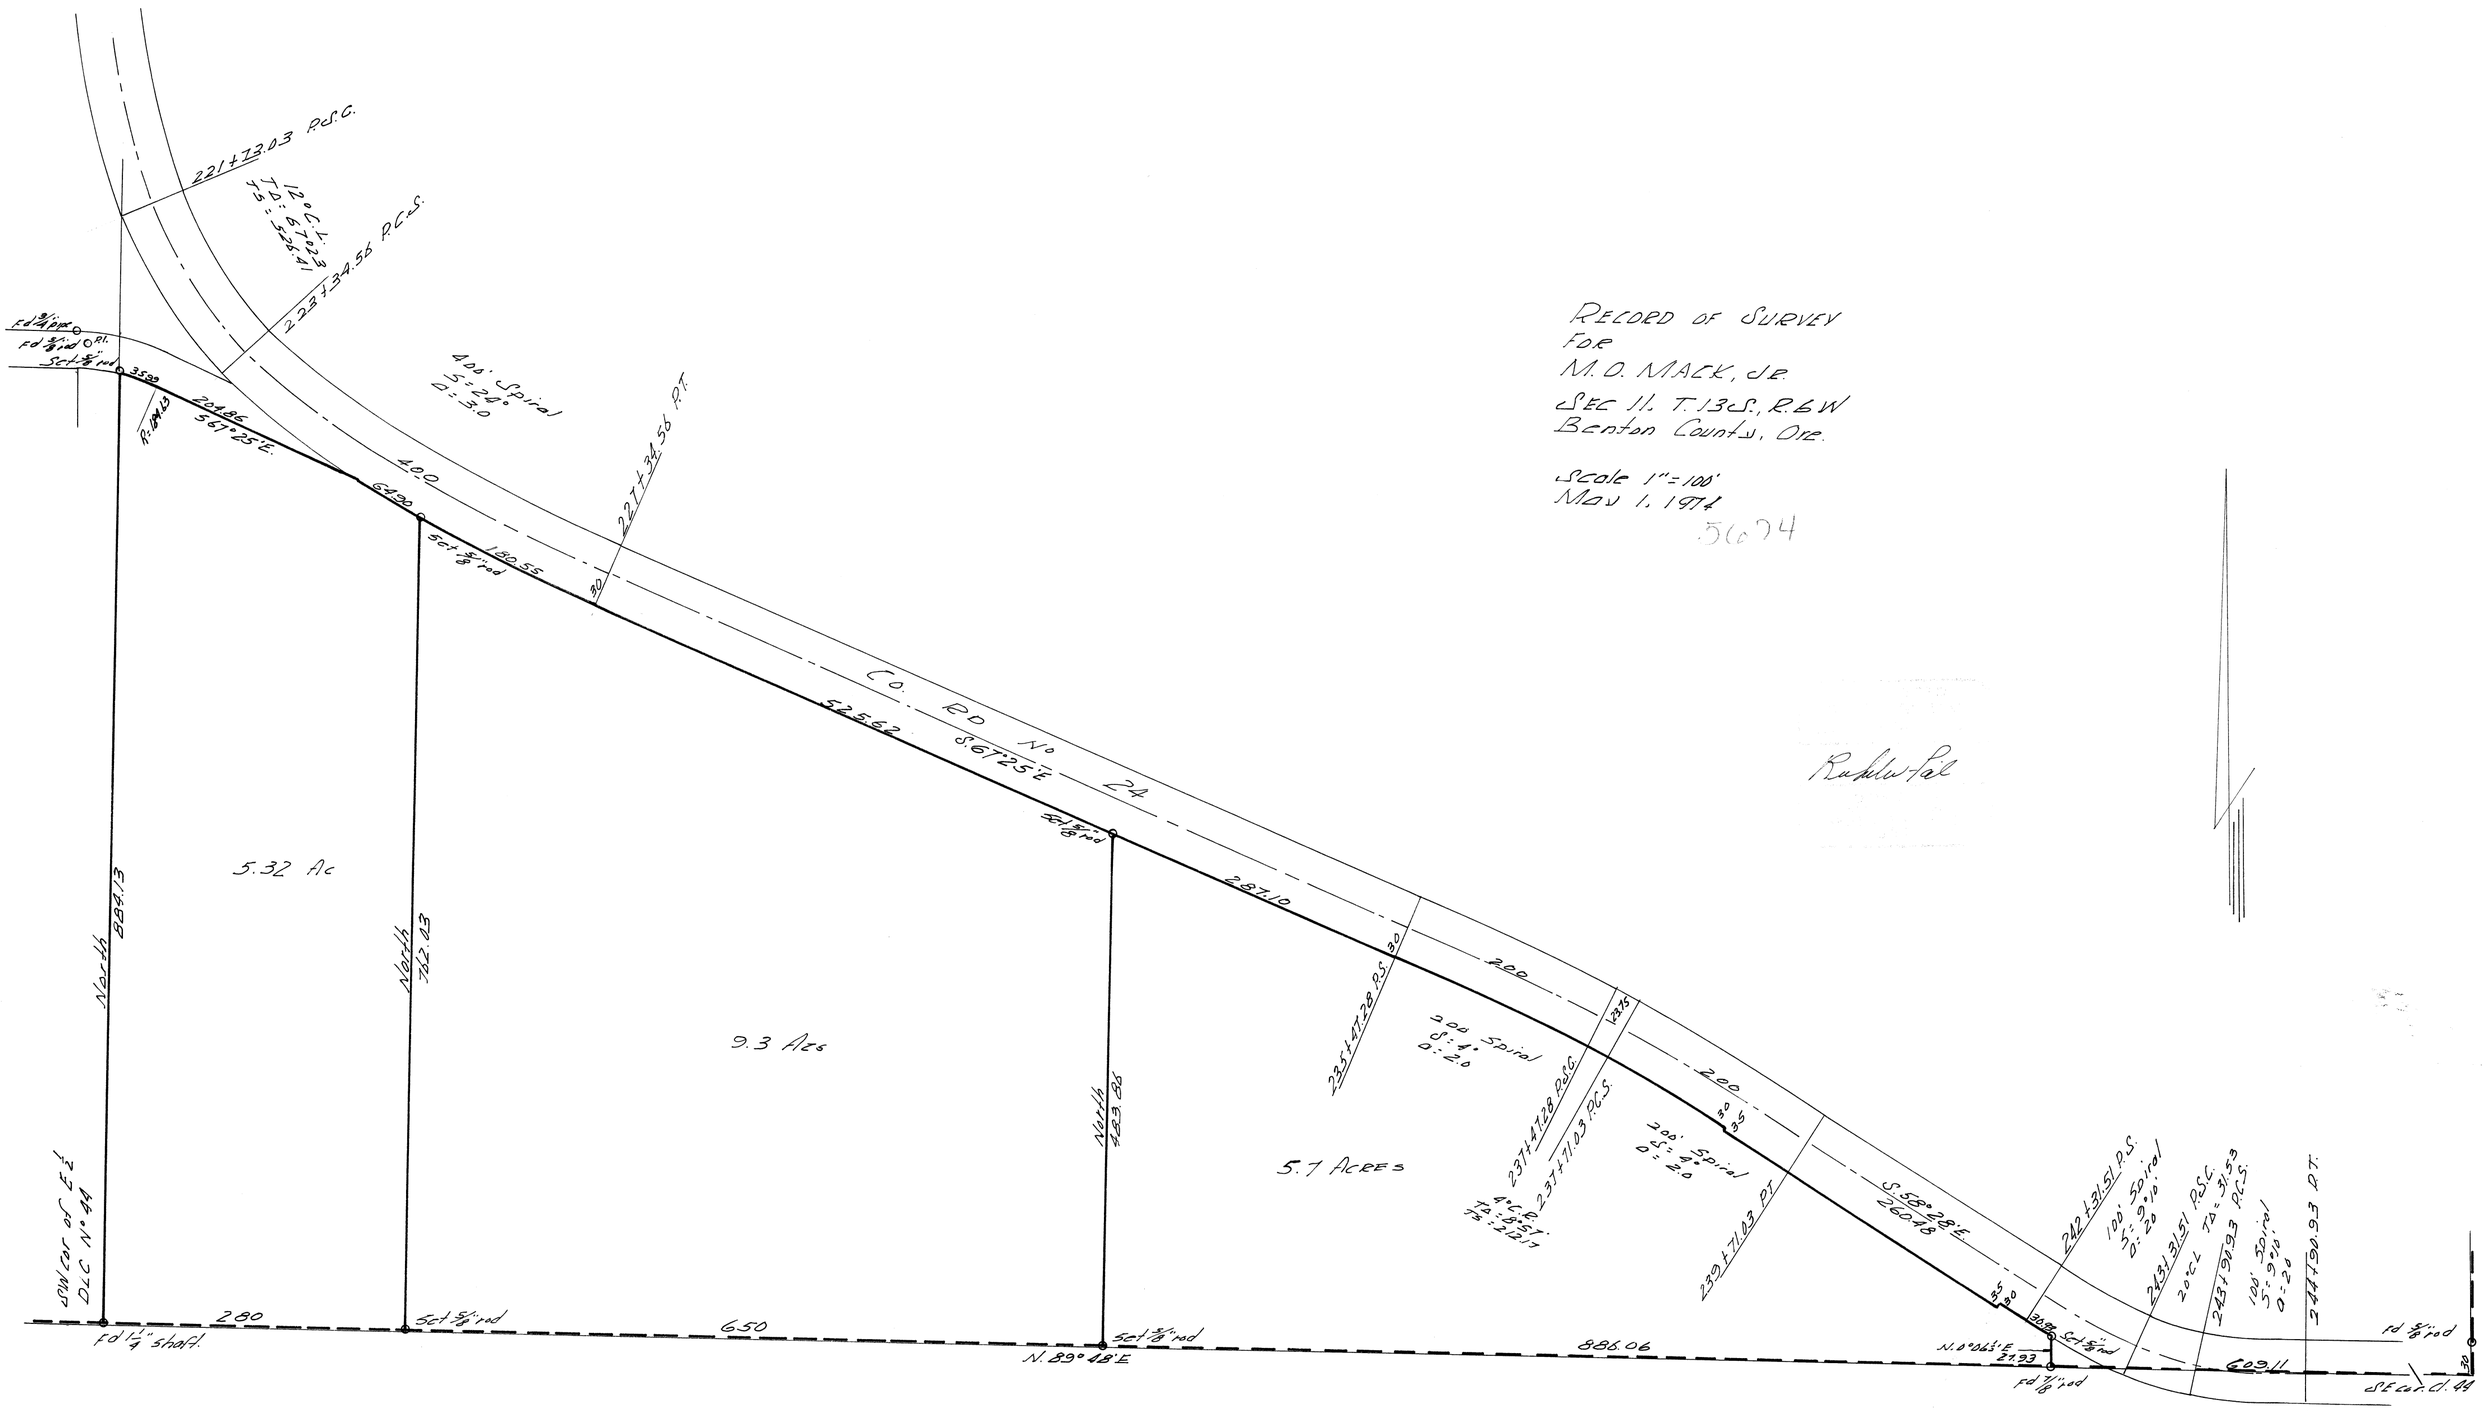

RECORD OF SURVEY
FOR
M. O. MACK, JR.
SEC 11. T.13S., R.6W
Benton County, Ore.

Scale 1" = 100'
May 1, 1974

5674

Rudolph Pal

5674