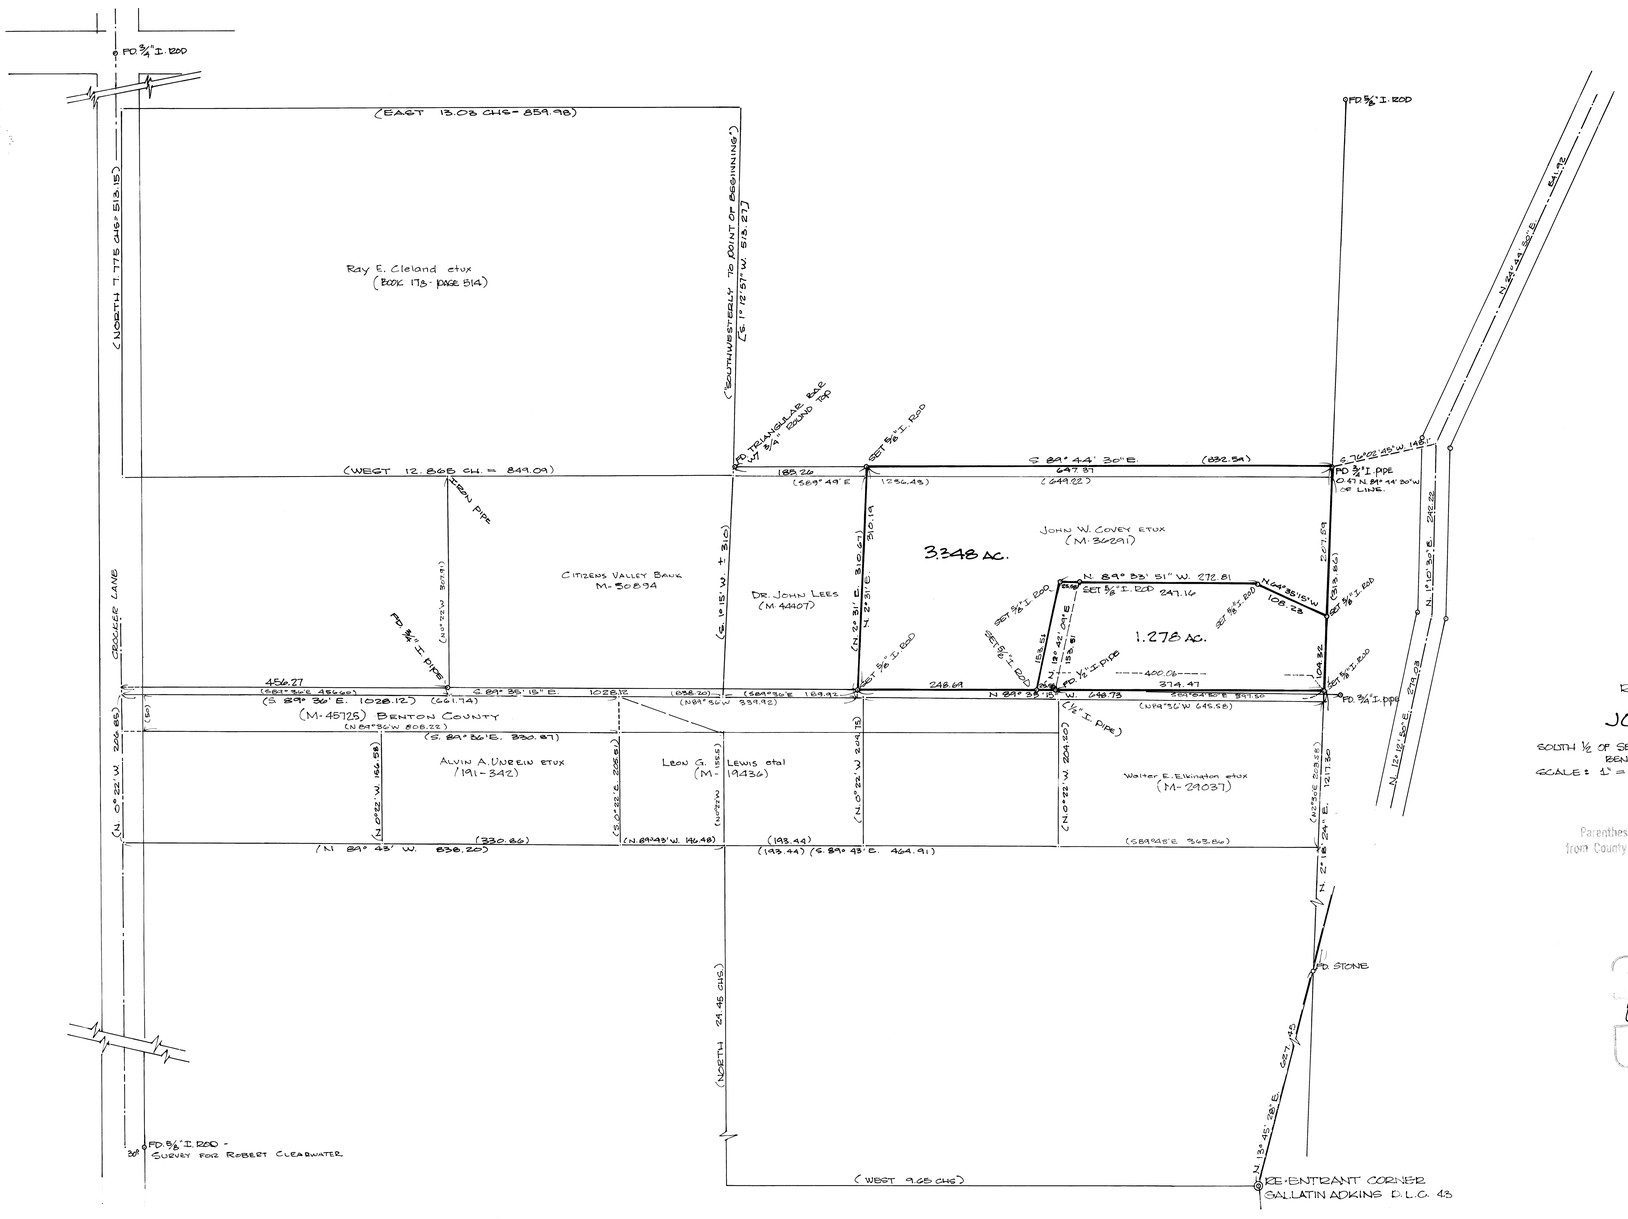

5700

5700
RECORD OF SURVEY
FOR
JOHN COVEY
IN THE
SOUTH ½ OF SEC. 25, T. 10S., R 4 W., W.B. & M.
BENTON COUNTY, OREGON
SCALE: 1" = 100 FT. APRIL 23, 1974

Parentheses indicate information from County Survey records or deeds.

REGISTERED PROFESSIONAL LAND SURVEYOR
OREGON JULY 31, 1962 DON L. MOORE

5700
12-29A