5735

L. STIRNEMANN

JAMES L. BOUNDS DLC. No. 69, T. 12 S., R. 6 W., W.M.

Scale: 1" = 200' August 29, 1974

REGISTERED
PROFESSIONAL
LAND SURVEYOR

Martin L. Beyerlein
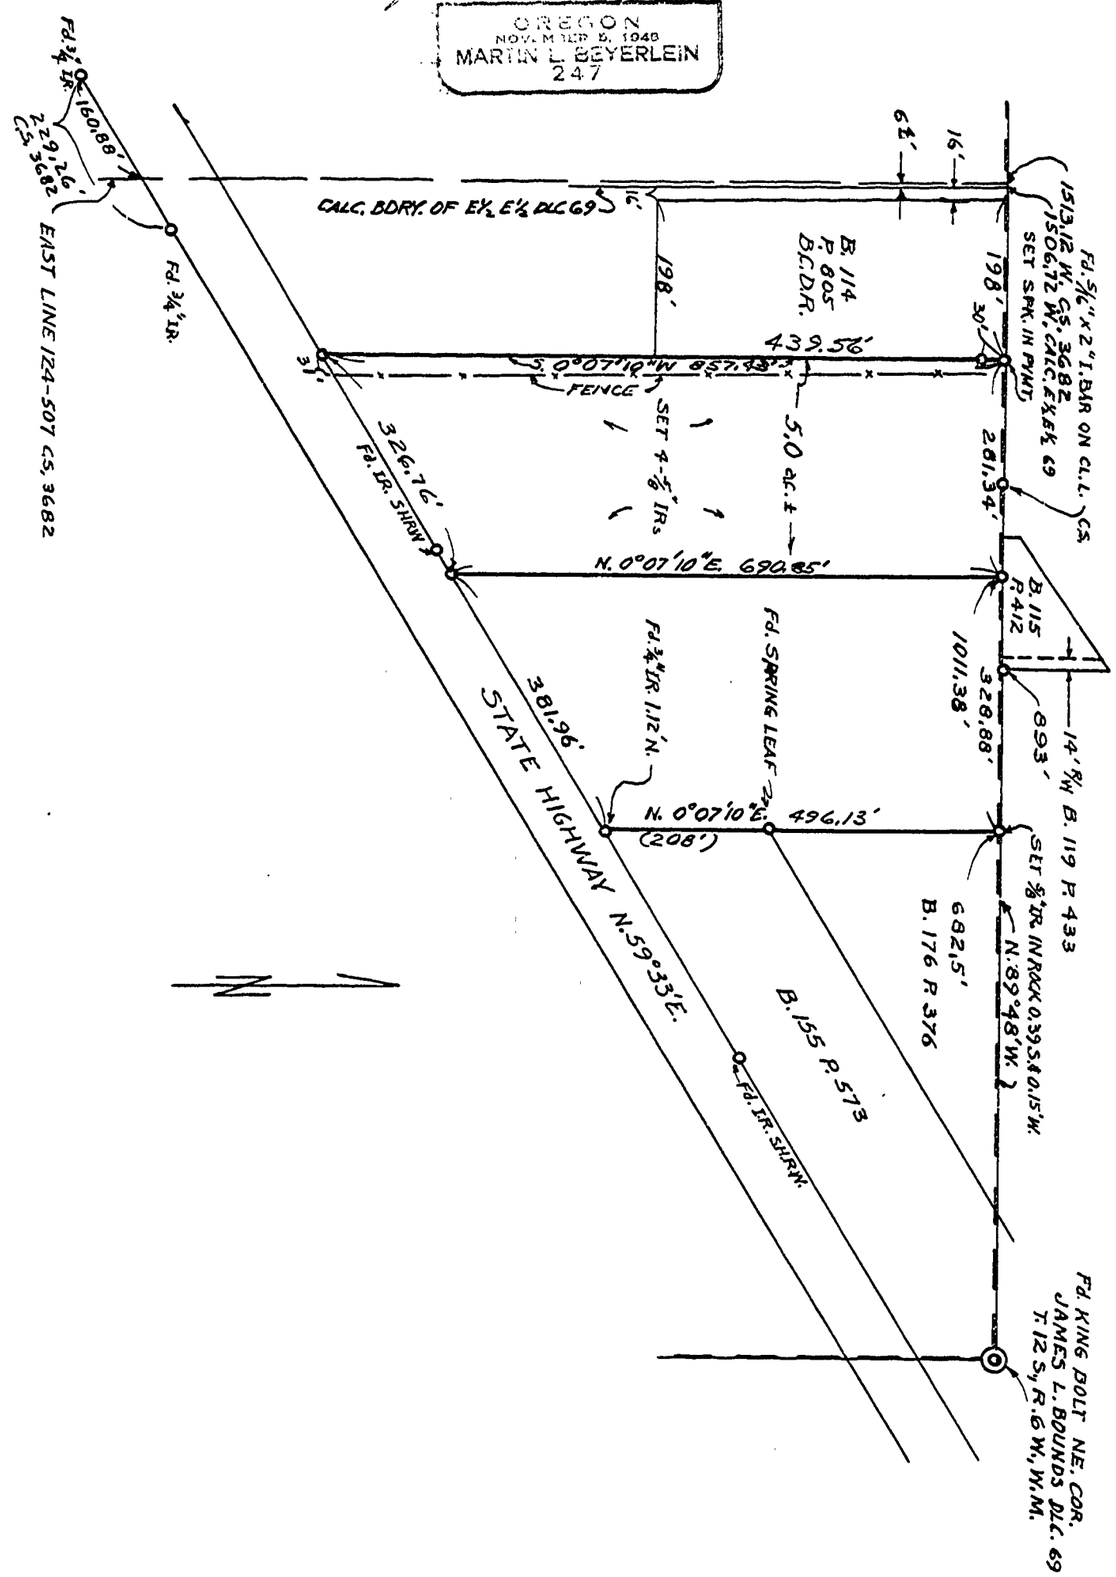
OREGON
NOV. MBER 5, 1948
MARTIN L. BEYERLEIN
247