5802

5802

05802

RECORD OF SURVEY

FOR: *SHERWOOD & ROBERTS, INC.*

IN: The B.W. WILSON D.L.C. No. 64

Township 12 South, Range 5 West, W. M.

Benton County, Oregon December, 1974

Scale: 1" = 200'

REGISTERED
PROFESSIONAL
LAND SURVEYOR

Nick A. Yinger

OREGON
JULY 12, 1968
NICK A. YINGER
876

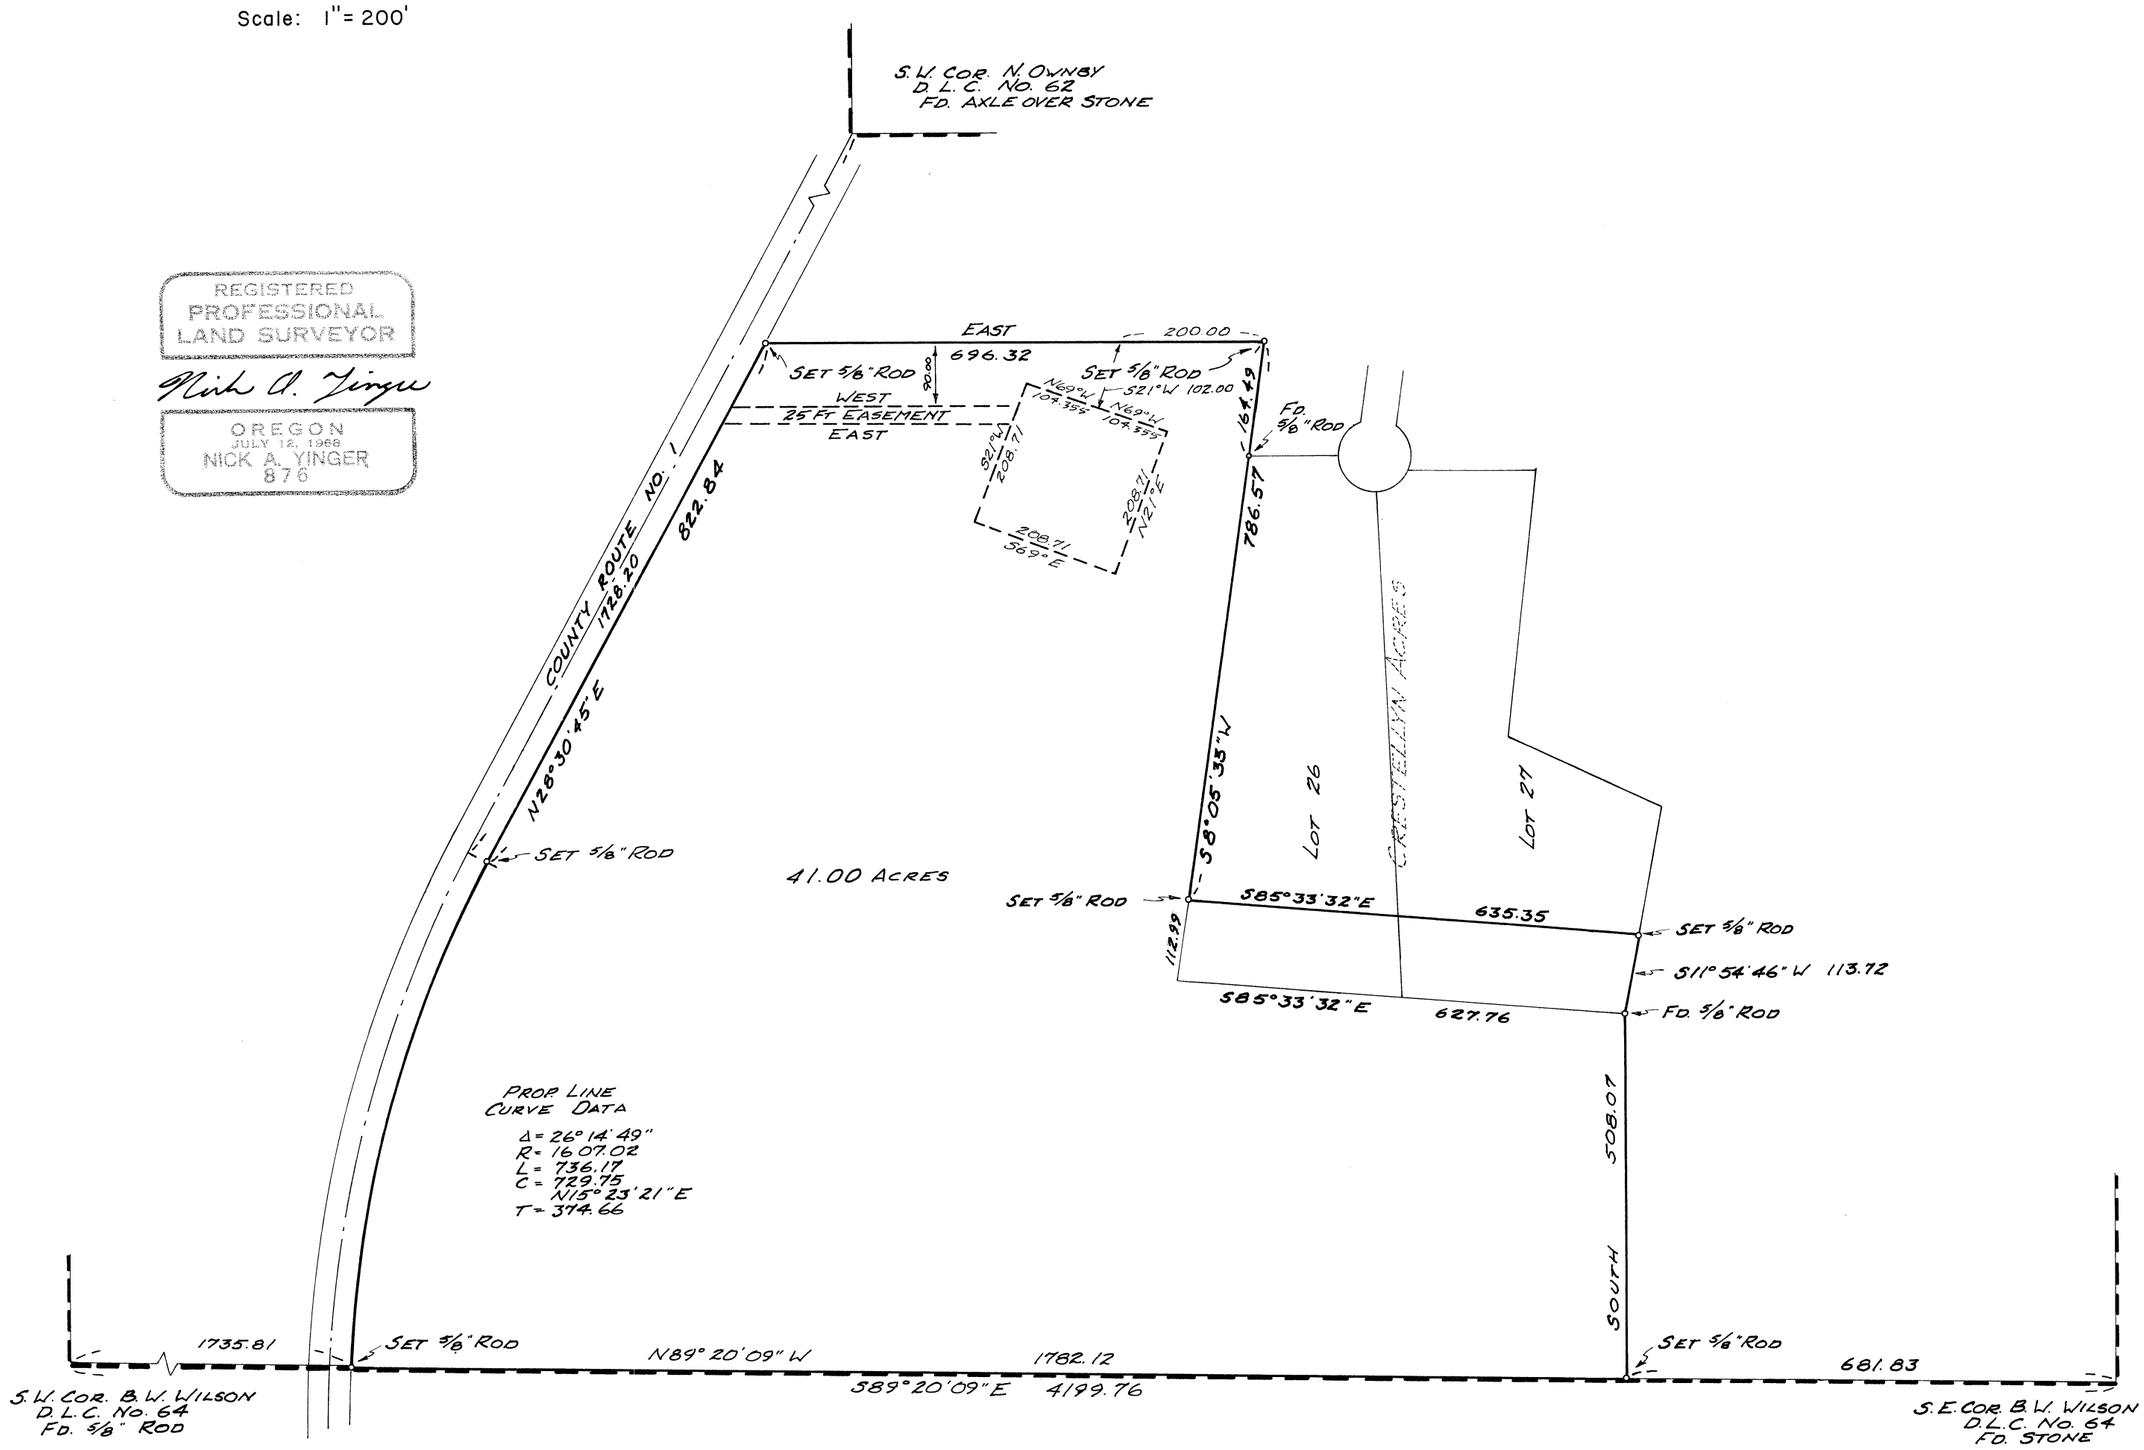

5802