C.S. 5876 REVISED 9/20/75

GERALD A. Mc INNES

S.E. 1/4 SEC. 7, T12S. R 5 W. W. M.

BENTON COUNTY. OREGON

SCALE 1" = 100 FT.

BASED ON C.S. 5578
& C.S. Dated Sept. 1967.

REVISED SEPT. 30, 1975

BERT W. UDELL RPE # 2301
by ARNOLD BRUBAKER RPLS # 992

N

E
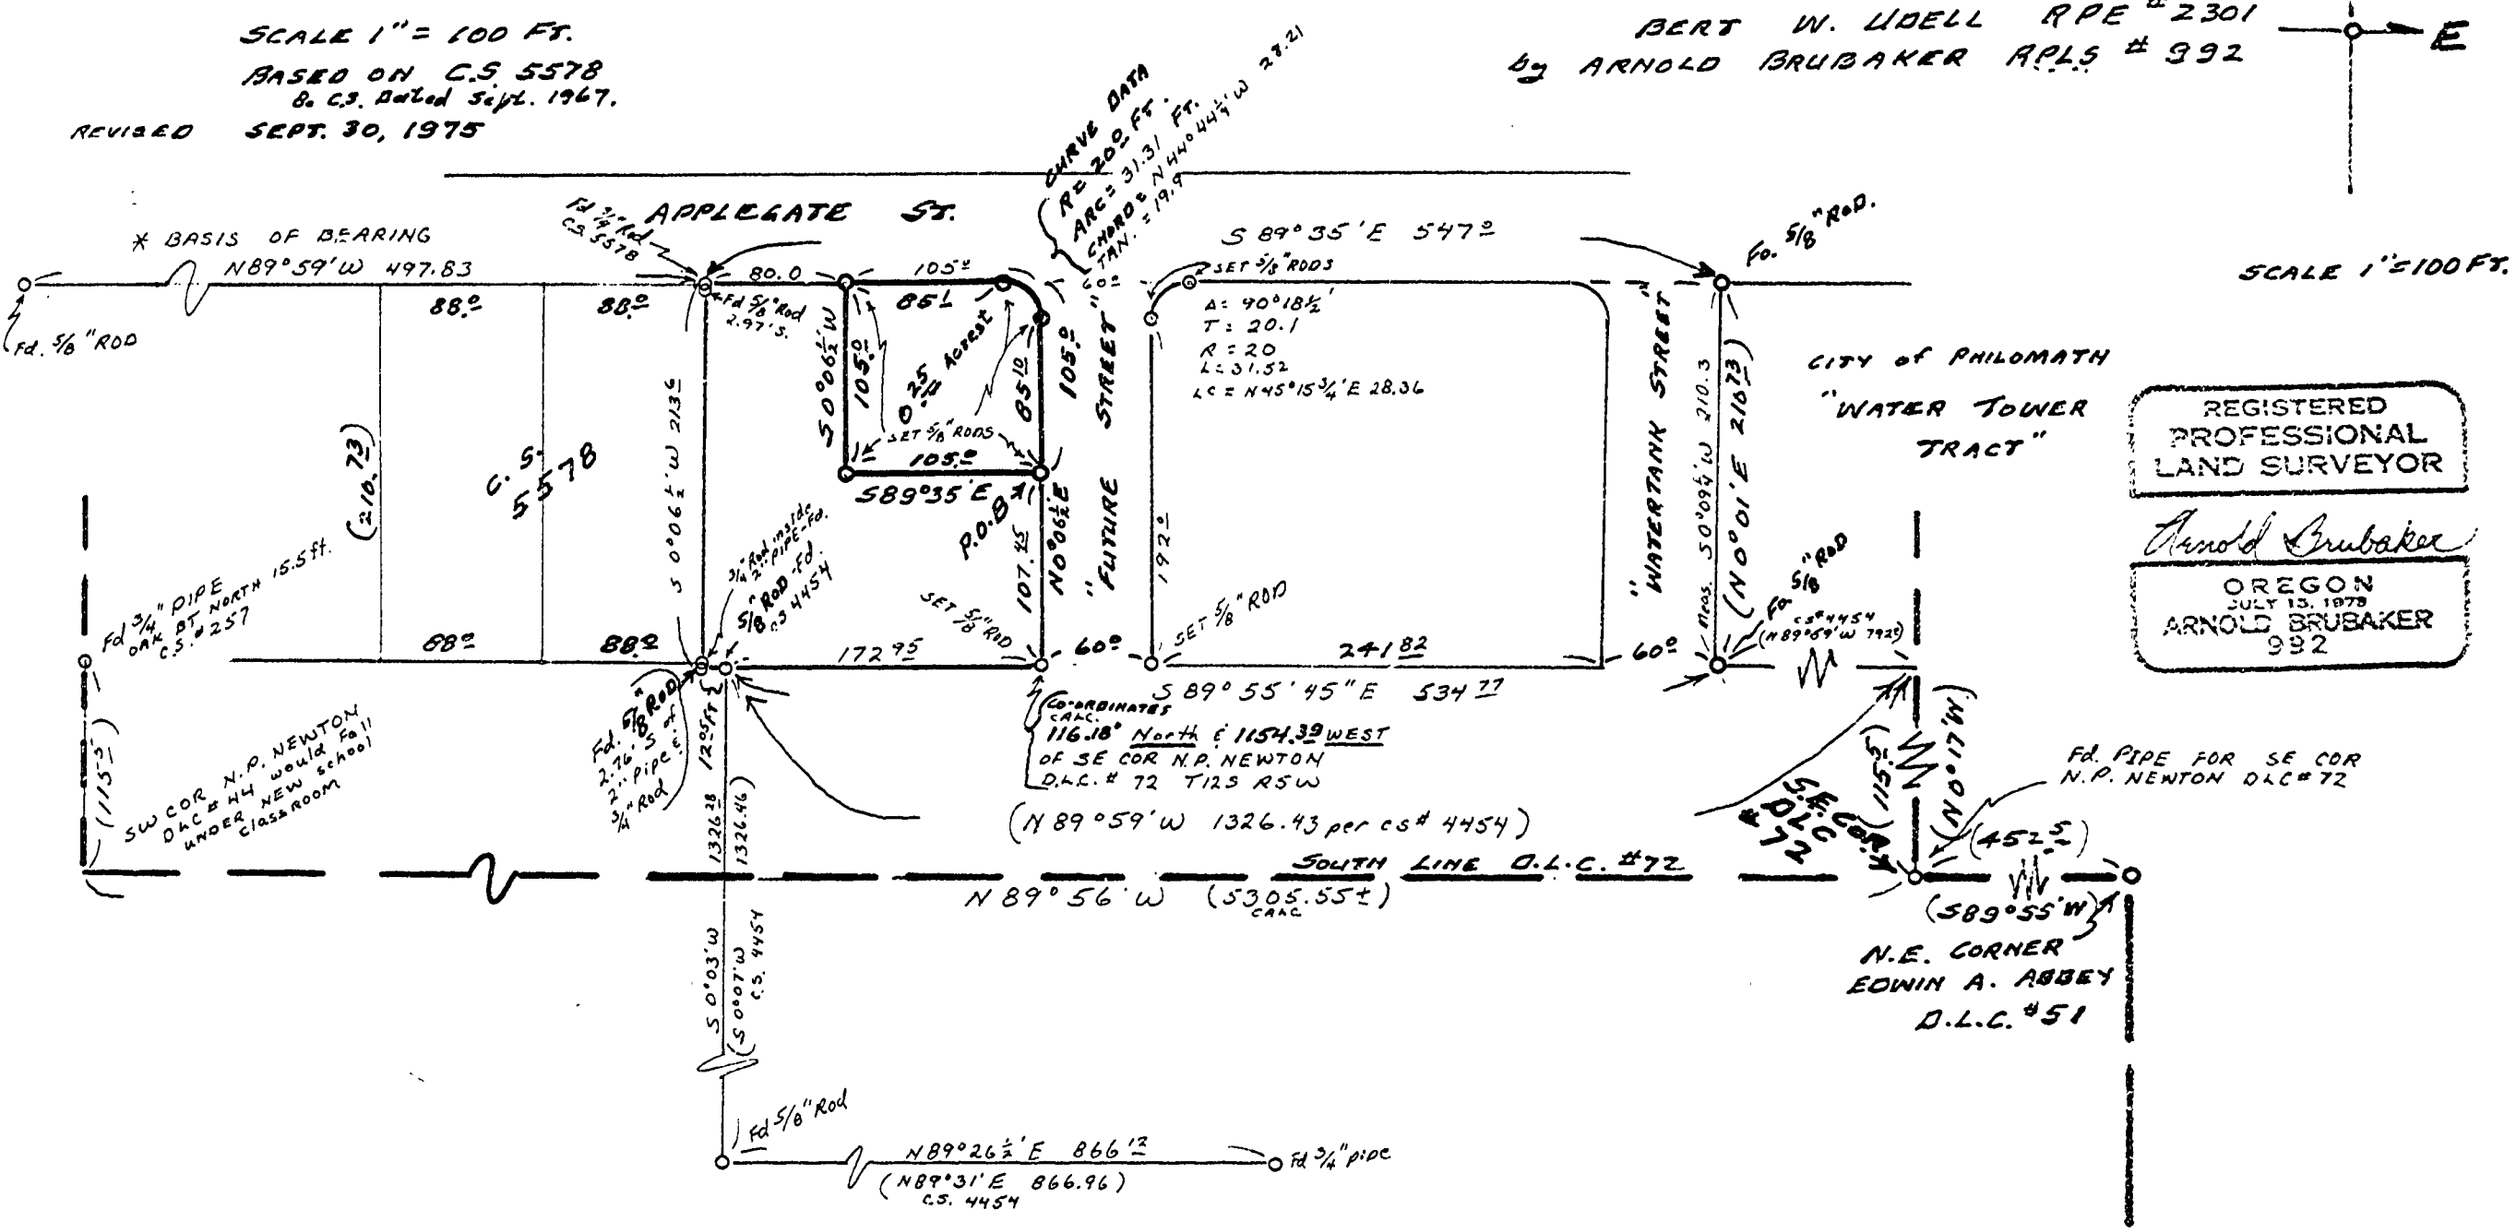
SCALE 1"=100 FT.