05894

# STARKER FORESTS

## S.W. 1/4 SEC. 28, N.W. 1/4 S 33

## T12S., R6W. W.M. IN BENTON COUNTY, ORE.

MAY 29, 1975 SCALE: 1"=400

BERT W. UDELL
R.P.E. 2301
BY W.G.A. P.C.

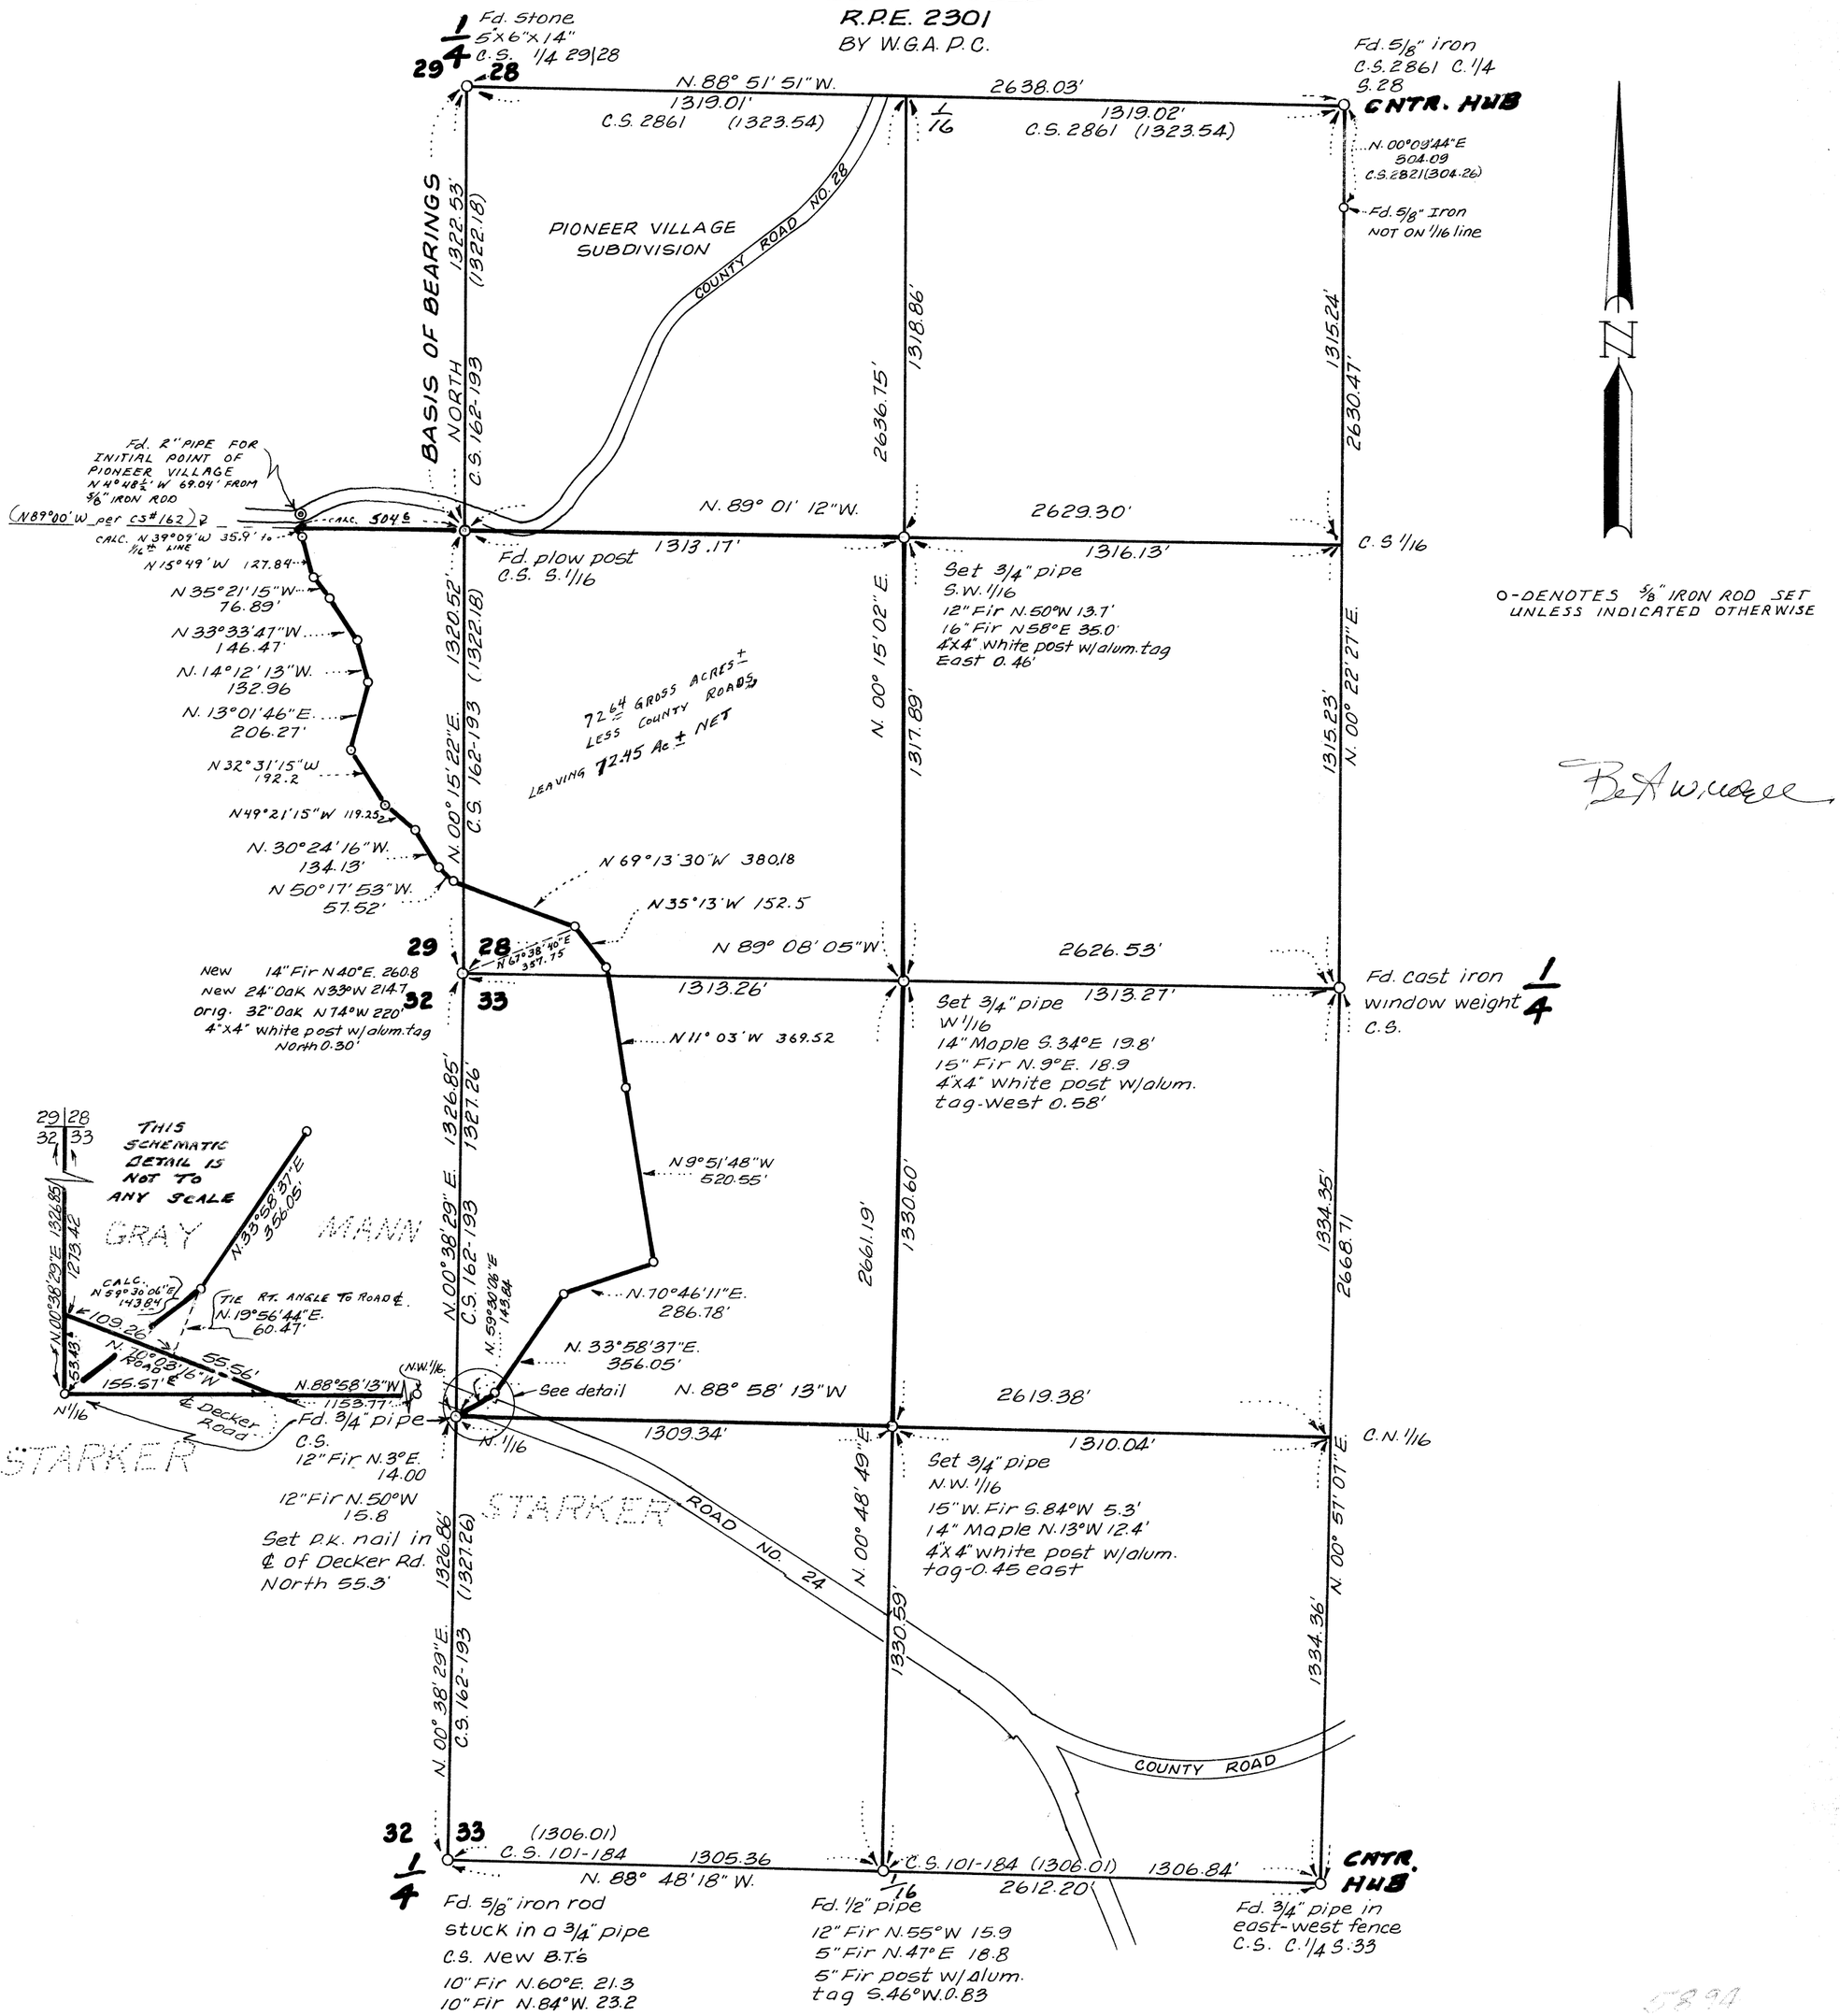


N

○-DENOTES 5/8" IRON ROD SET UNLESS INDICATED OTHERWISE

B. A. W. Udell

05894

05894