06069

RECORD OF SURVEY FOR FRANK DIEU

IN NE¼, SW¼ SEC 19
T. 11 S. R. 5 W., W.M.
BENTON COUNTY, ORE.

SCALE 1" = 100'
MAY 22, 1975

○ = 5/8" rod SET
● = 5/8" rod FOUND
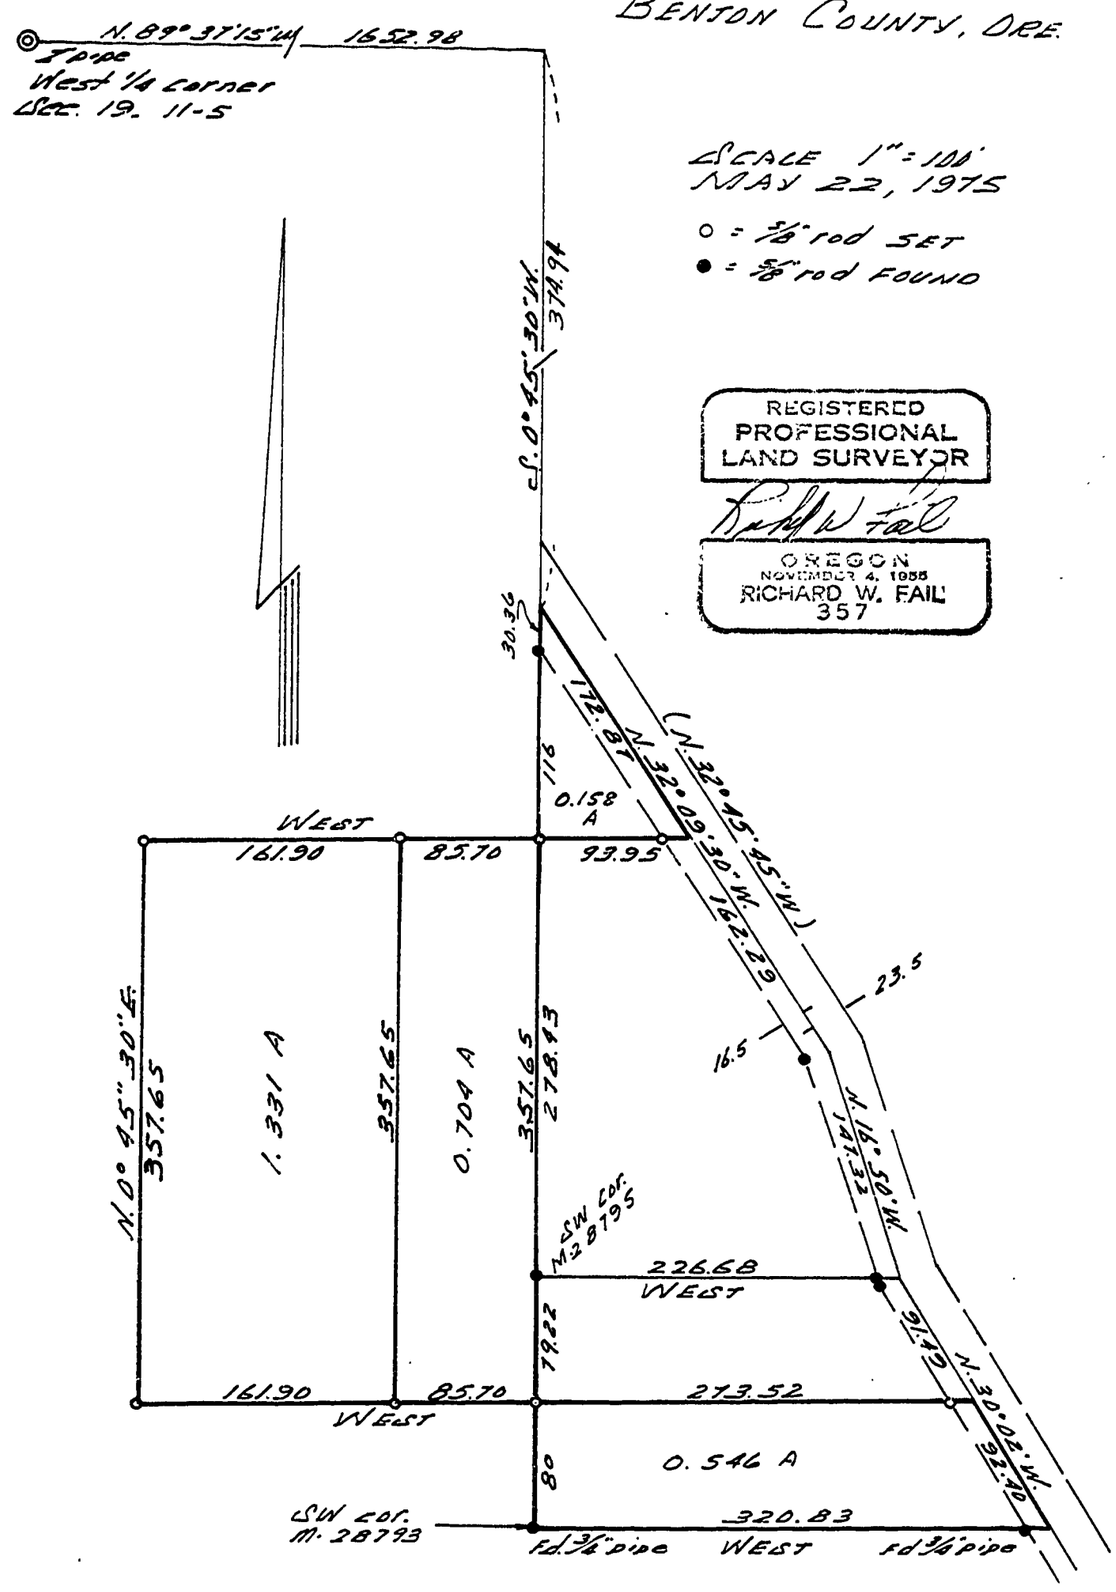
REGISTERED PROFESSIONAL LAND SURVEYOR
Richard W. Fail
OREGON
NOVEMBER 4, 1958
RICHARD W. FAIL
357