06087

RECORD OF SURVEY FOR

TED HOPKINS

in the NW ¼ of Sec. 23, T.12S., R.6W., WM

Benton County Oregon

Scale 1" = 100' March 14, 1976

REGISTERED PROFESSIONAL LAND SURVEYOR

Fred I. Lemke
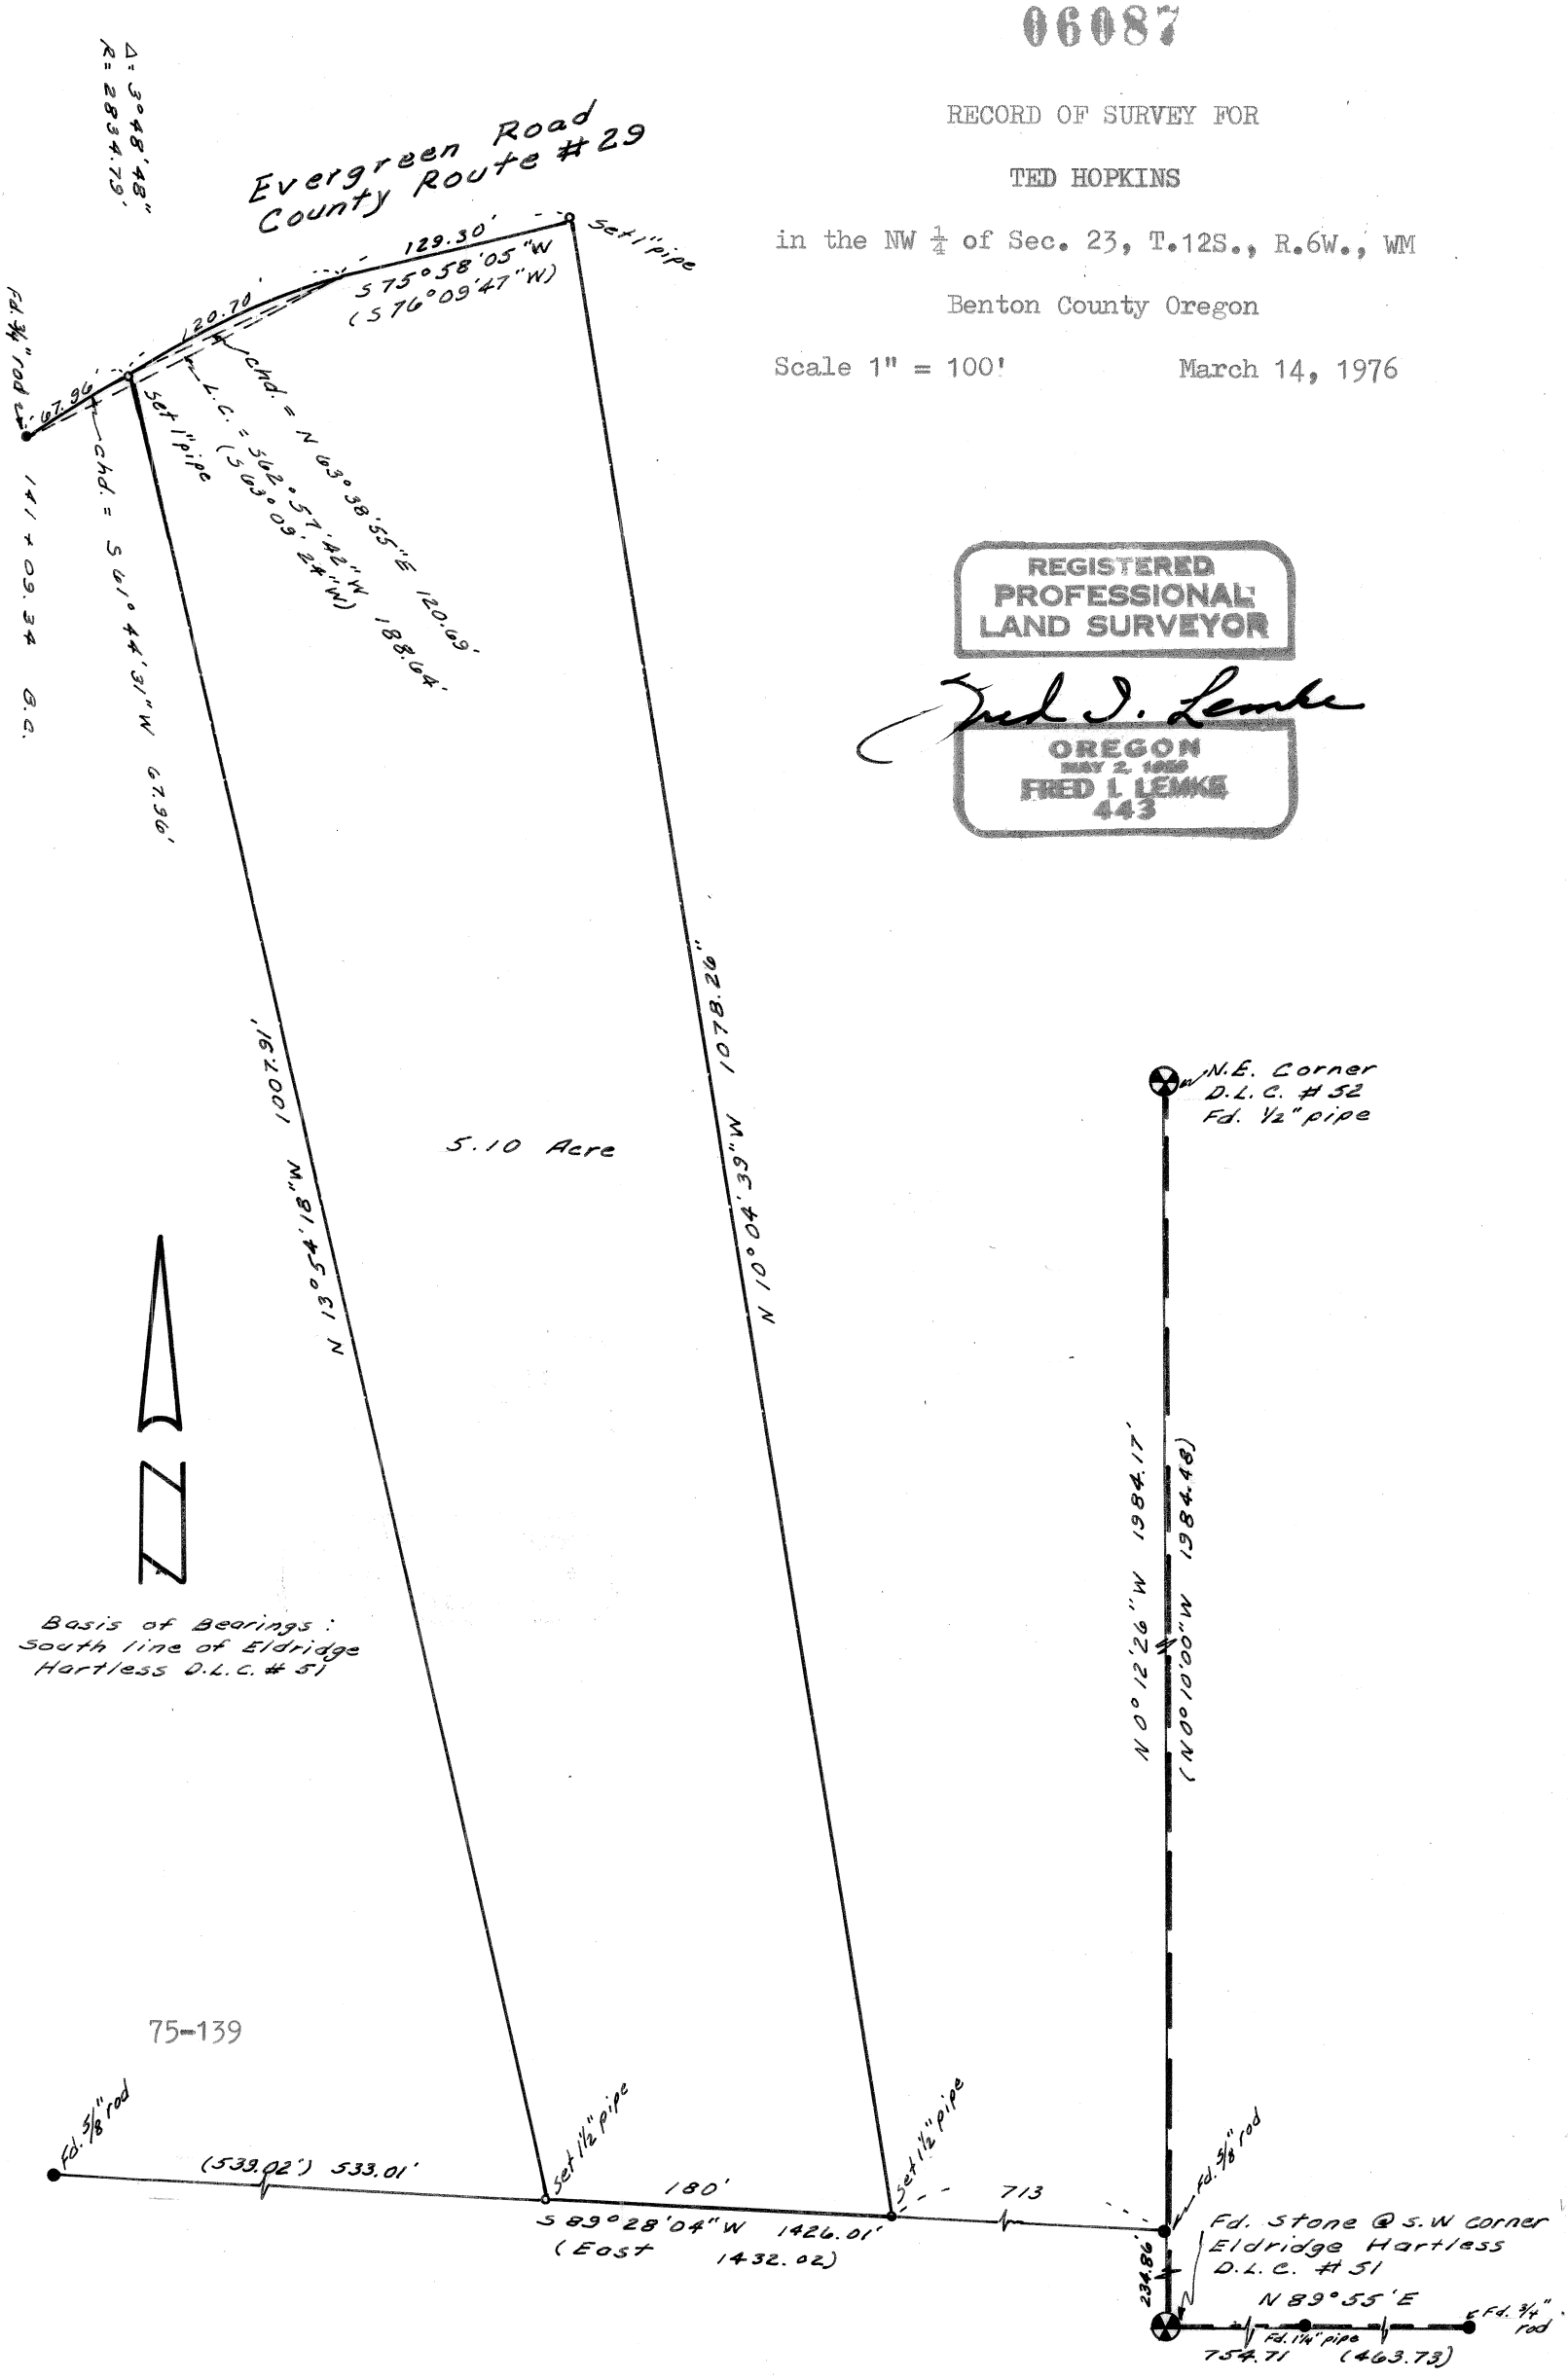
OREGON
MAY 2, 1968
FRED I. LEMKE
443