C.S. 06140

SYMONDS SURVEY

NE 1/4, SE1/4, SEC. 1
T. 11S. R. 4 W. W.M.

BENTON COUNTY, OREGON

Scale: 1" = 60' August 3, 1976

REGISTERED PROFESSIONAL ENGINEER
OREGON
JULY 14, 1967
HOWARD G. KRAUS

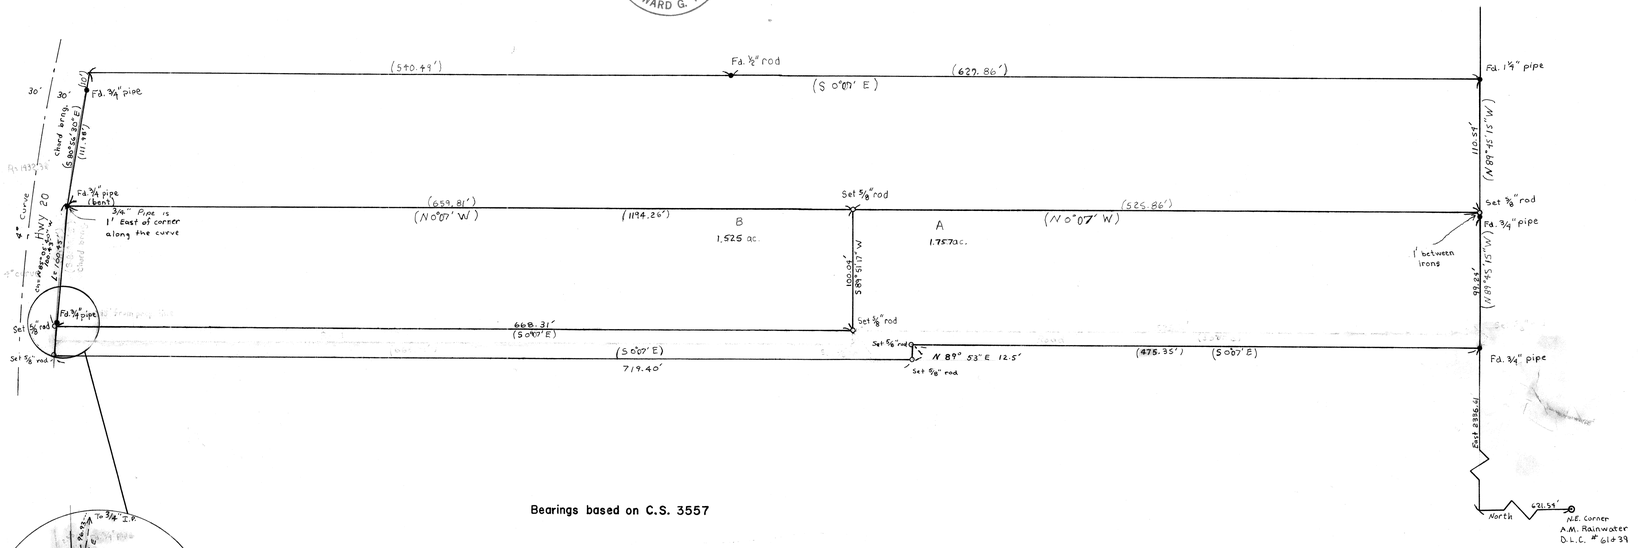

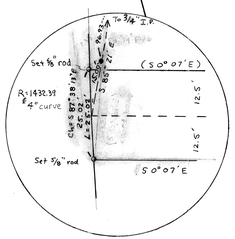

Bearings based on C.S. 3557

06140

CONSULTING ENGINEERS