STARKER FORESTS

NE¼, SEC. 29, T.13S., R. 7 W., W. M.
BENTON COUNTY, ORE.
SCALE: 1" = 200' SEPT. 30, 1976

BERT W. UDELL R.P.E. #2301
BY ARNOLD BRUBAKER R.L.S. #992
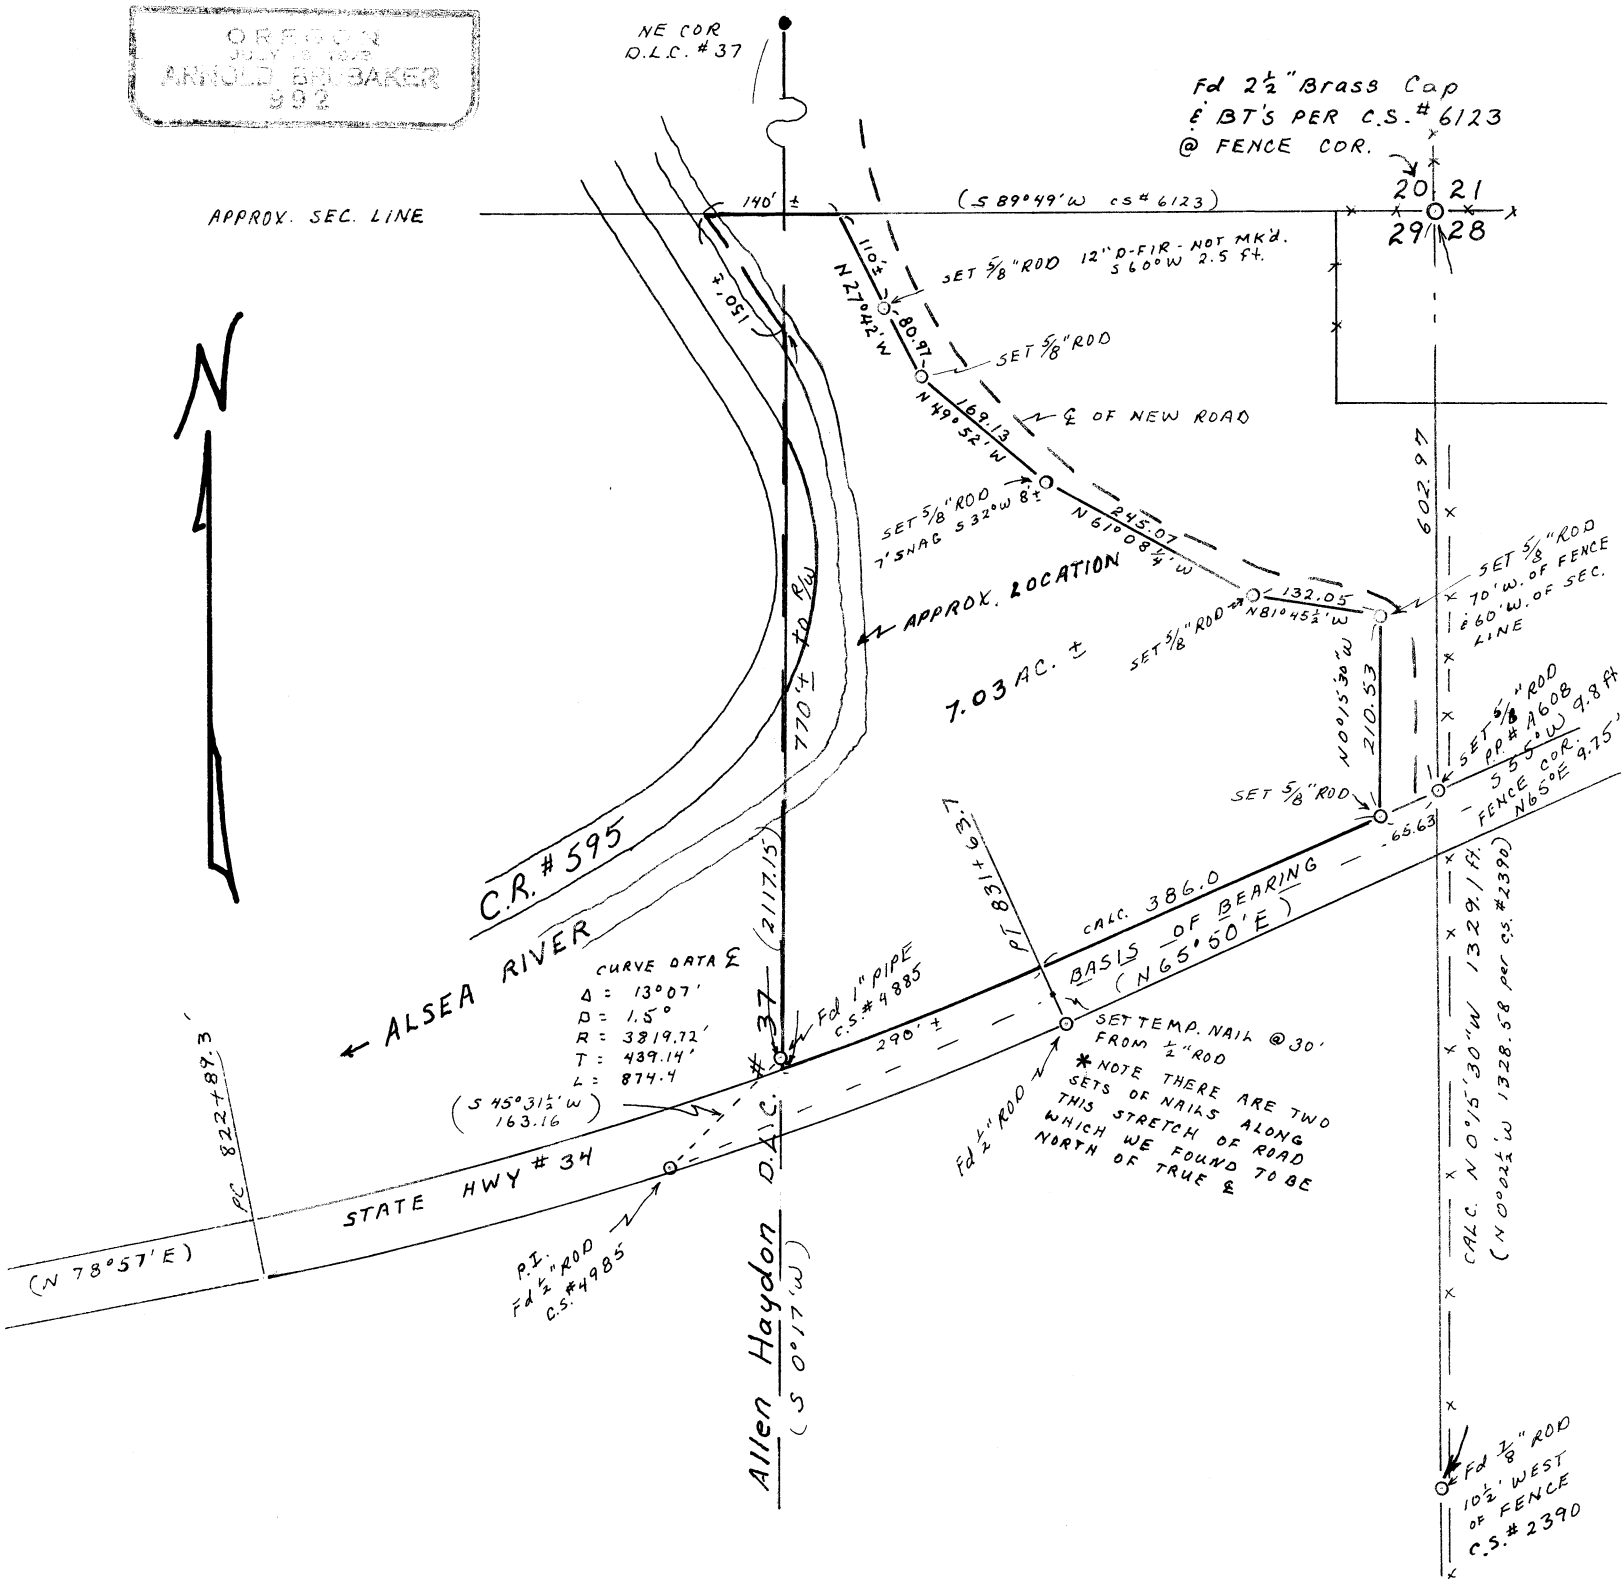
REGISTERED PROFESSIONAL LAND SURVEYOR
Arnold Brubaker
OREGON
JULY 9, 1975
ARNOLD BRUBAKER
992