Benton Co. Surveyors Office
C. S. FILE NO. 06400
FILING DATE 7-19-77
FILE SIZE 8½ x 14

RECORD OF SURVEY
FOR WALT PFLUGHAUPT
OF LOT 7, BLOCK 3, HIGHLAND LAWN ACRES
IN BENTON COUNTY, OREGON
DATE JULY 11, 1977

SEQUOIA STREET

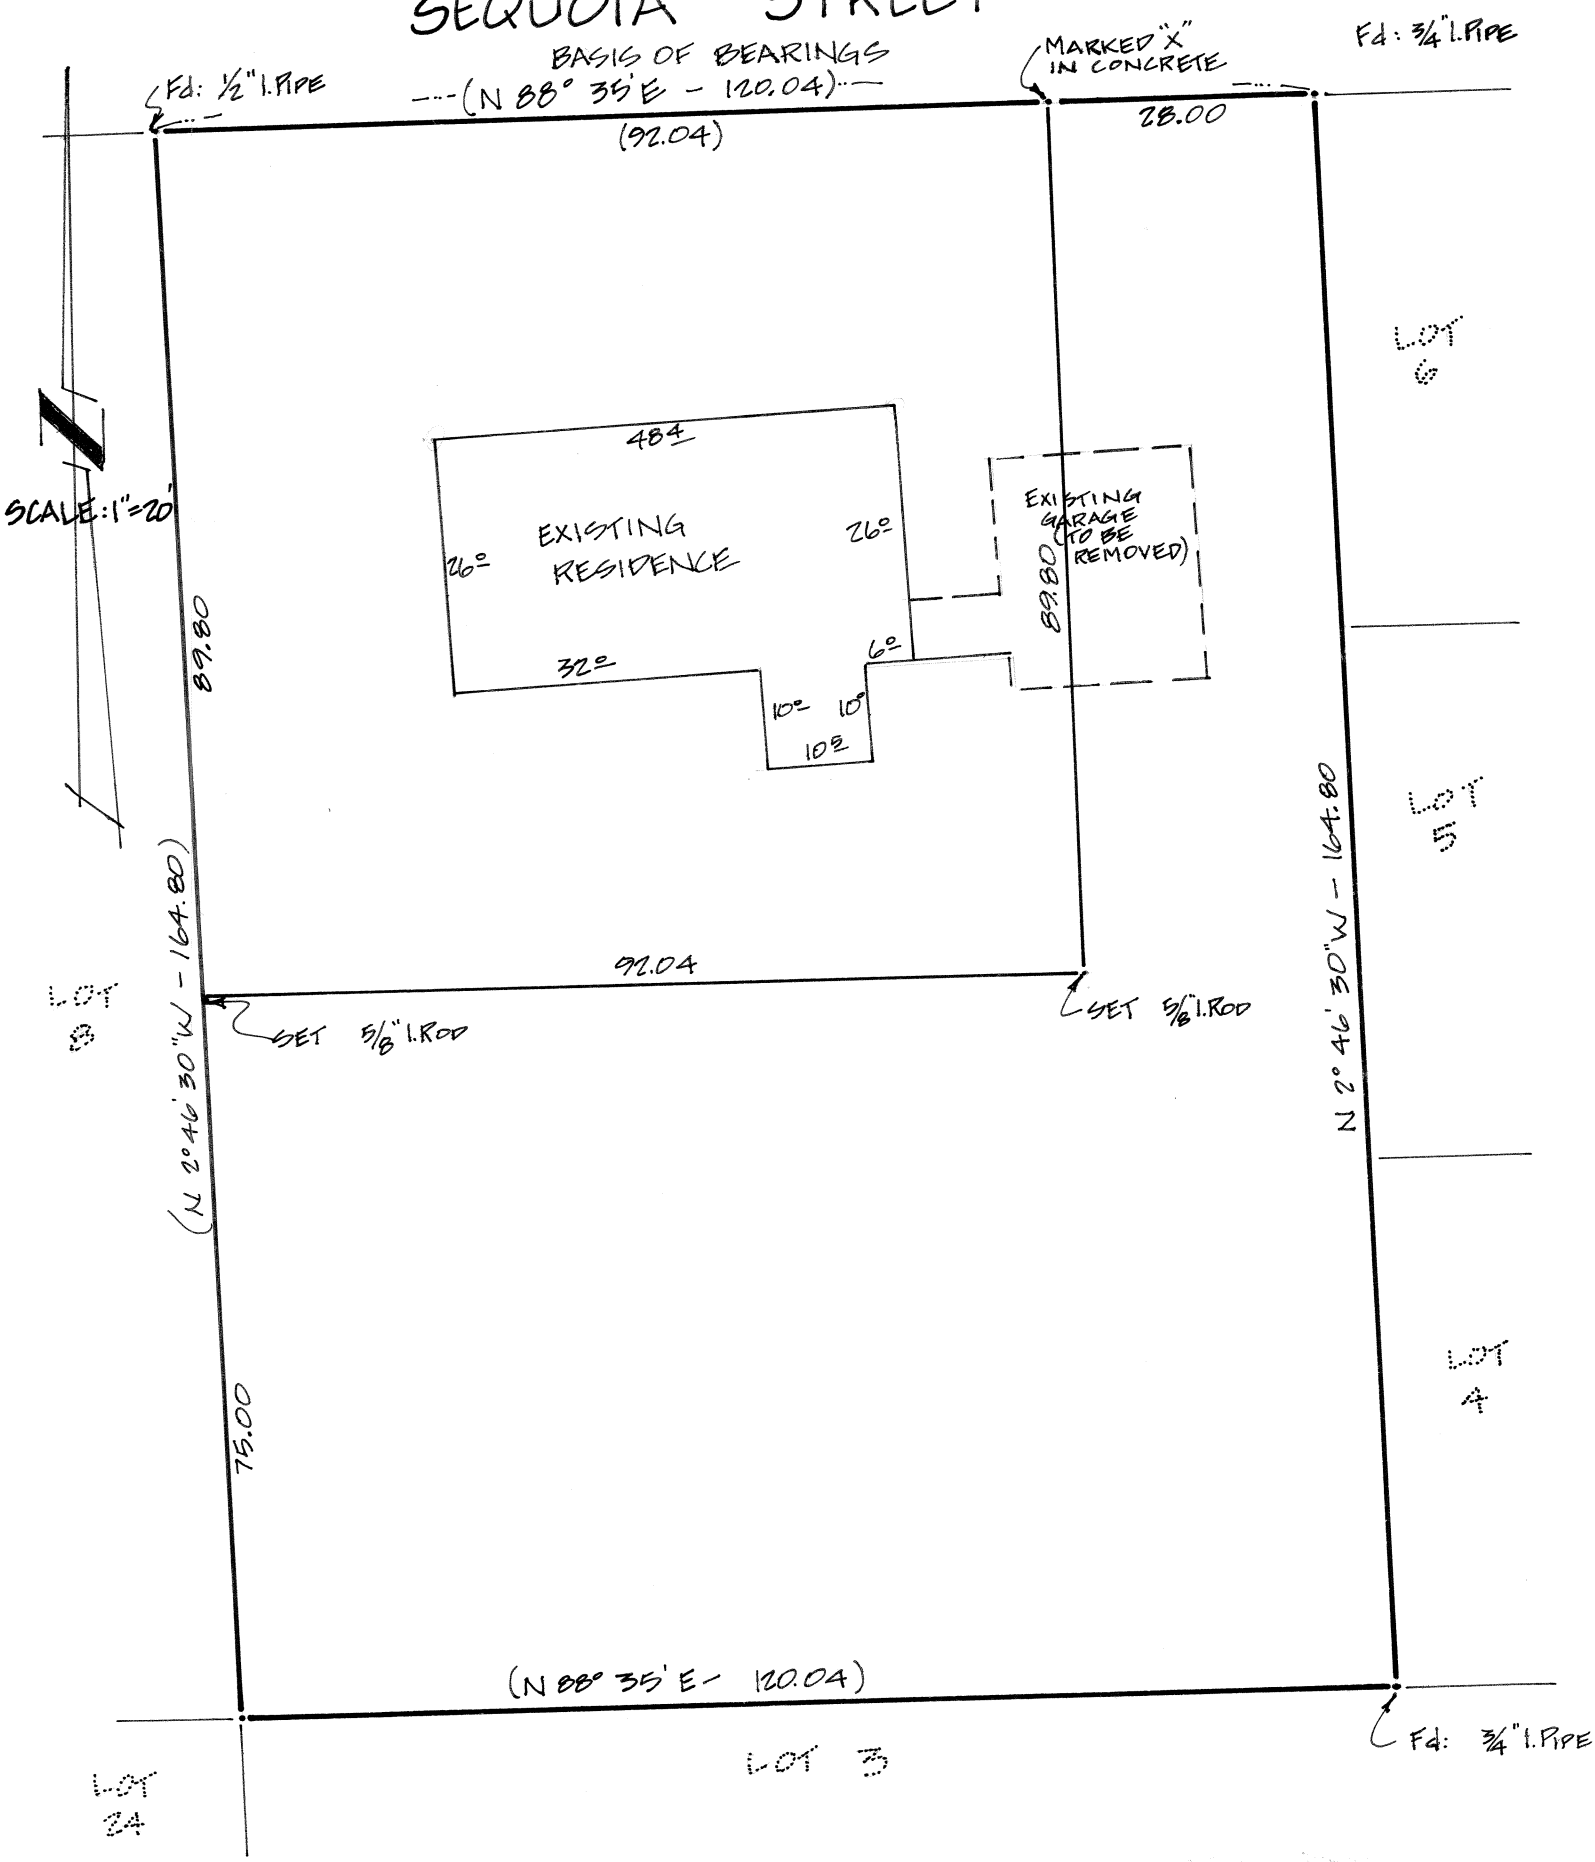

REGISTERED PROFESSIONAL ENGINEER
5198
Glenn A. Ling
OREGON
JULY 10, 1964
GLENN A. LING