Benton Co. Surveyors Office
C. S. FILE NO. [illegible]
FILING DATE [illegible]
FILE SIZE [illegible]

RECORD OF SURVEY

FOR: ANDREW K. HSILING

IN: The S.M. Stouts D.L.C. No. 48
Township 11 South, Range 5 West, W. B. & M.
Benton County, Oregon July, 1977

Scale: 1"=50'

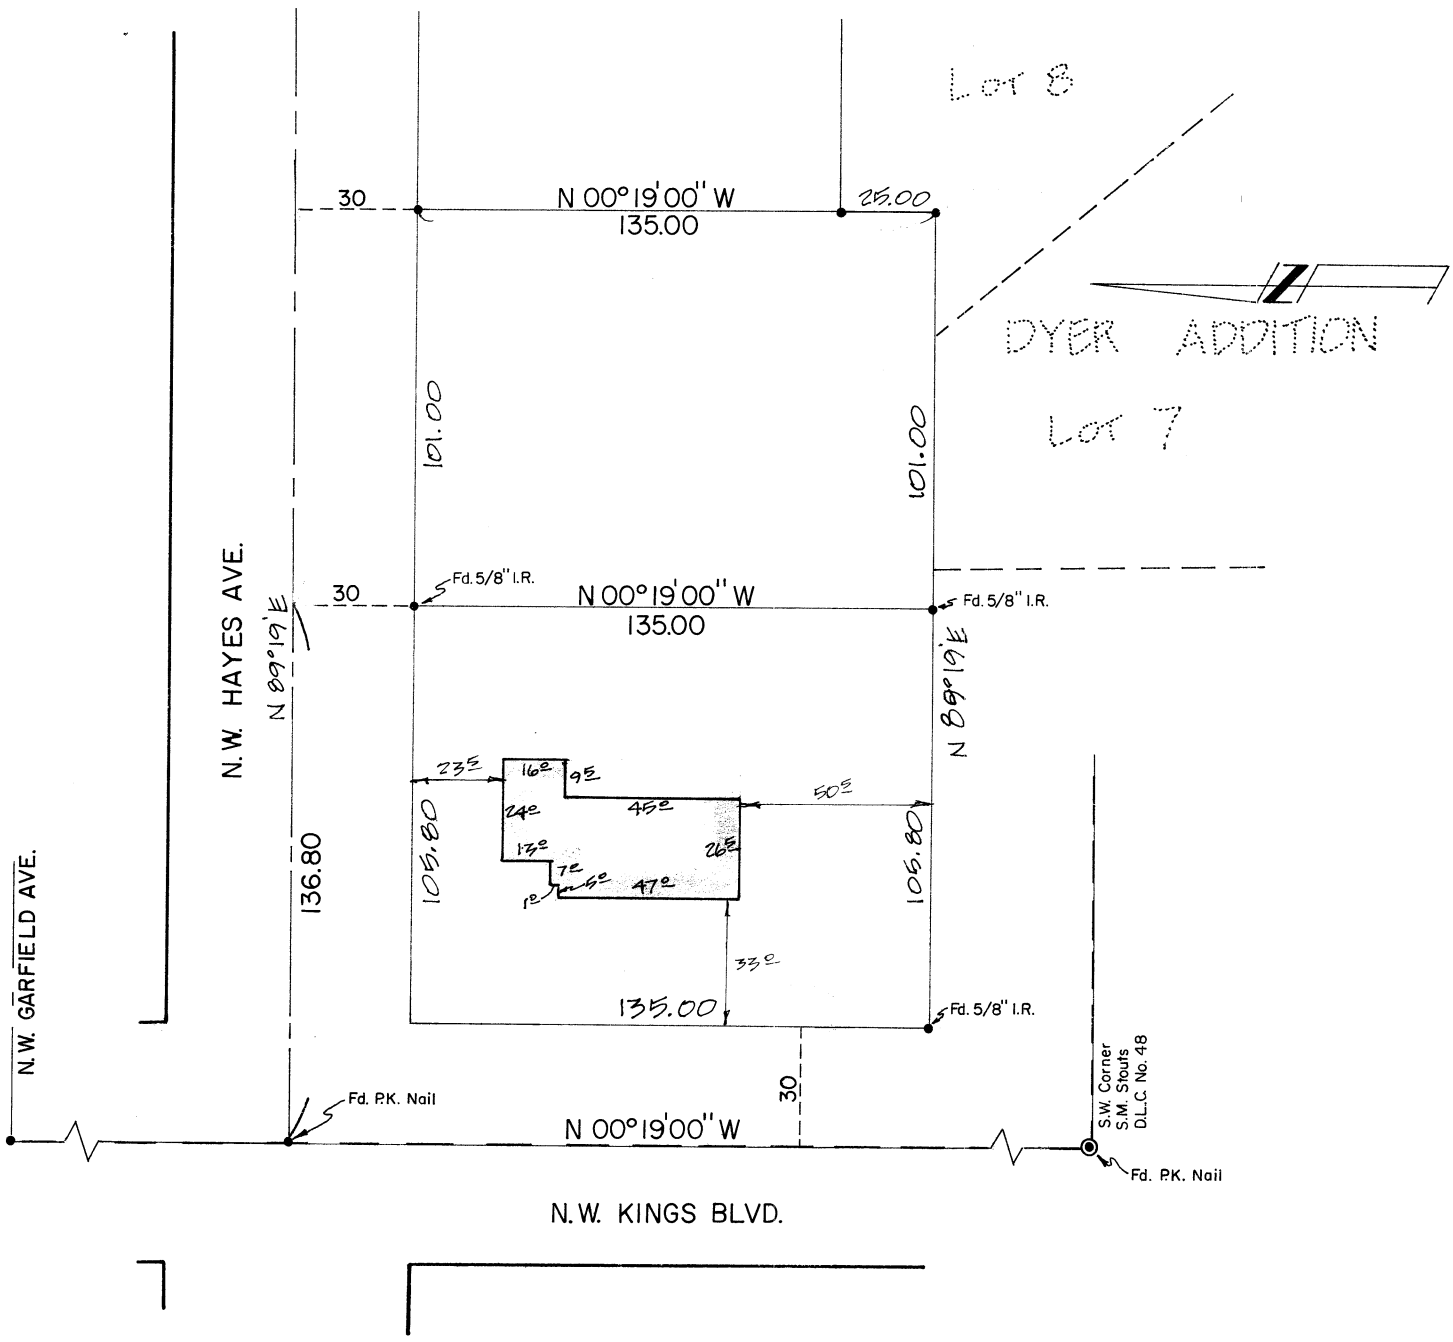

REGISTERED PROFESSIONAL ENGINEER
6172
OREGON
MAY 10, 1963
GLENN A. LING