Benton Co. Surveyors Office
C. S. FILE NO. 06451
FILING DATE 8-26-77
FILE SIZE 8½ x 14

Map of Survey For
Robert Blackledge

in the N.E. 1/4 of S.W. 1/4 of Sect. 27

T. 11 S., R. 5W., of W.M.

City of Corvallis, Benton County Oregon

Scale 1"=50' Date 8/23/77

Job no. 77-247

Drawn by: DLK & MLP

CS 6451

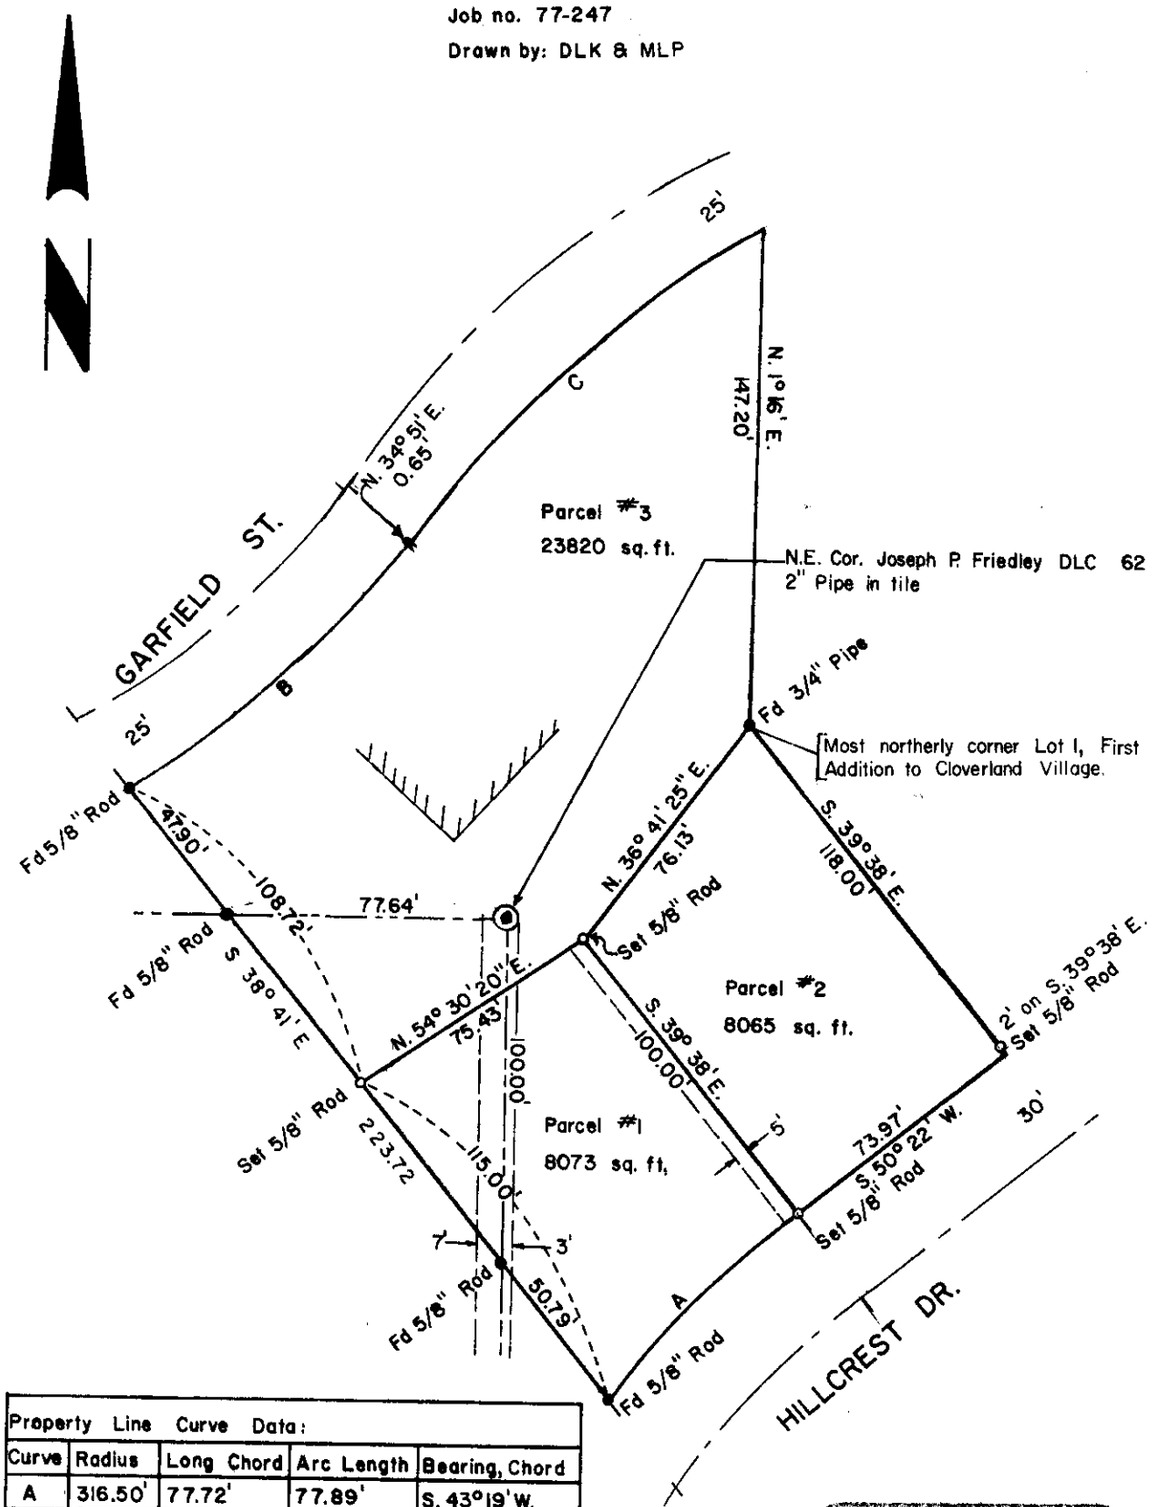

Property Line Curve Data:				
Curve	Radius	Long Chord	Arc Length	Bearing, Chord
A	316.50'	77.72'	77.89'	S. 43°19' W.
B	270.60'	107.05'	107.76'	N. 46°15' 30" E.
C	309.21'	136.86'	138.00'	N. 47°38' 10" E.

REGISTERED
PROFESSIONAL
LAND SURVEYOR

Fred I. Lemke

OREGON
MAY 2, 1959
FRED I. LEMKE
443