RECORD OF SURVEY
for LEIGHTON DAVIS
in THE JACOB MARTIN DLC No.66
Sec. 31, T.12S., R.5W., W.M.
BENTON COUNTY, OREGON

November 1977

Benton Co. Surveyors Office
C. S. FILE NO. 06502
FILING DATE 12-1-77
FILE SIZE 8½ x 14
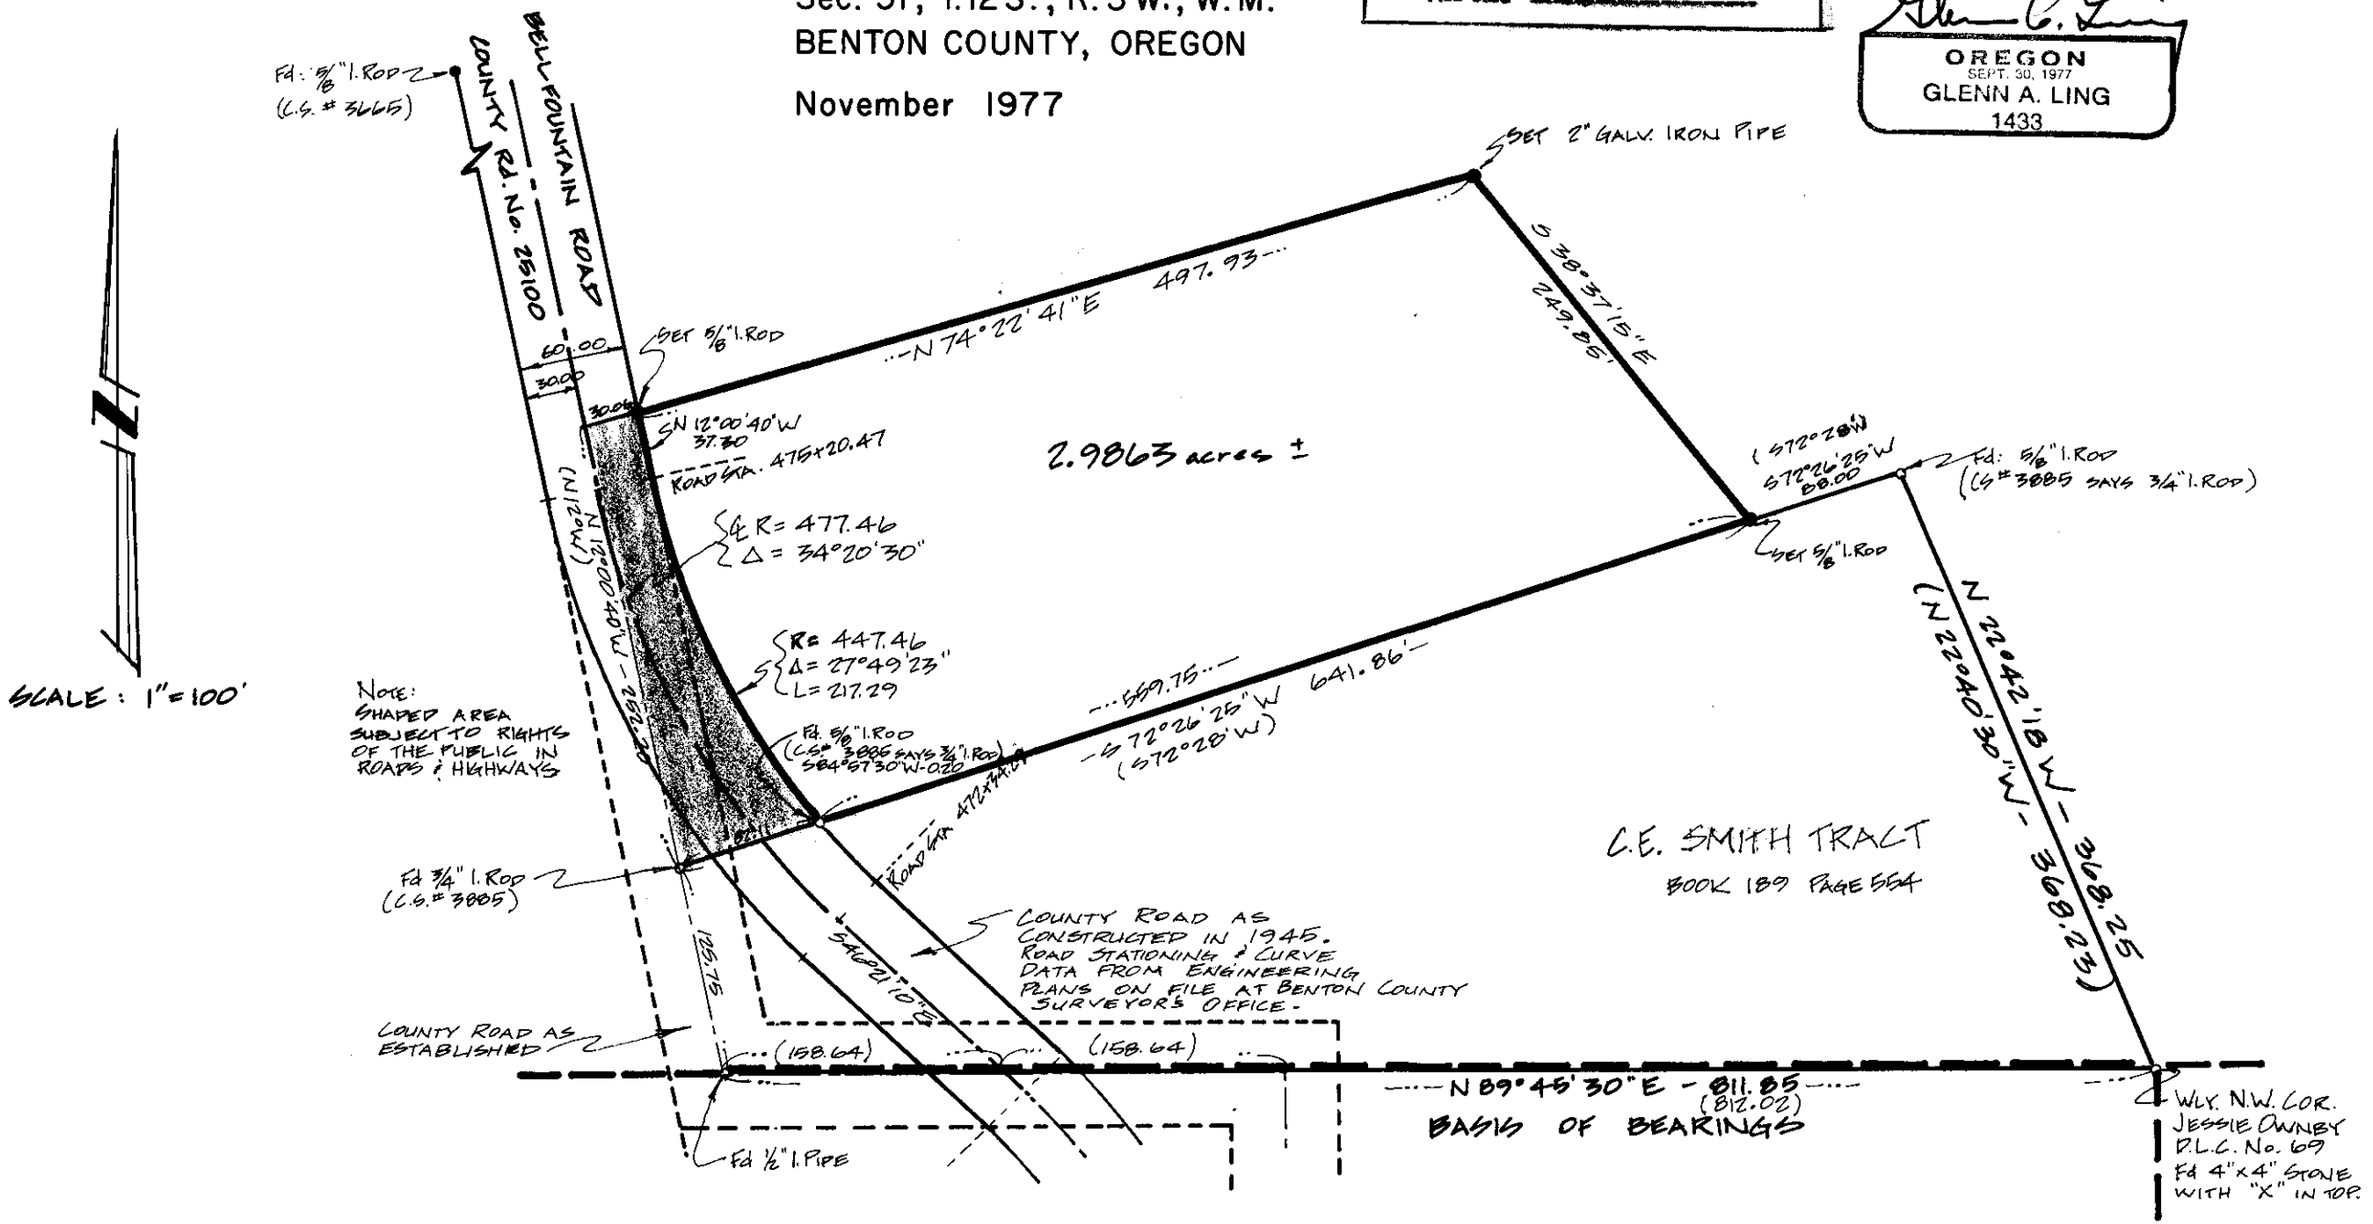
REGISTERED PROFESSIONAL LAND SURVEYOR
Glenn A. Ling
OREGON
SEPT. 30, 1977
GLENN A. LING
1433