Benton Co. Surveyors Office
C. S. FILE NO.
FILING DATE
FILE SIZE

Record of Survey

JEAN B. WYCKOFF

In Section 5, Township 12, Range 5 West of W.M.
Benton County, Oregon

Scale: 1" = 100'
Job No.: 78-03
Drawn by: V.M.V.

January 6, 1978

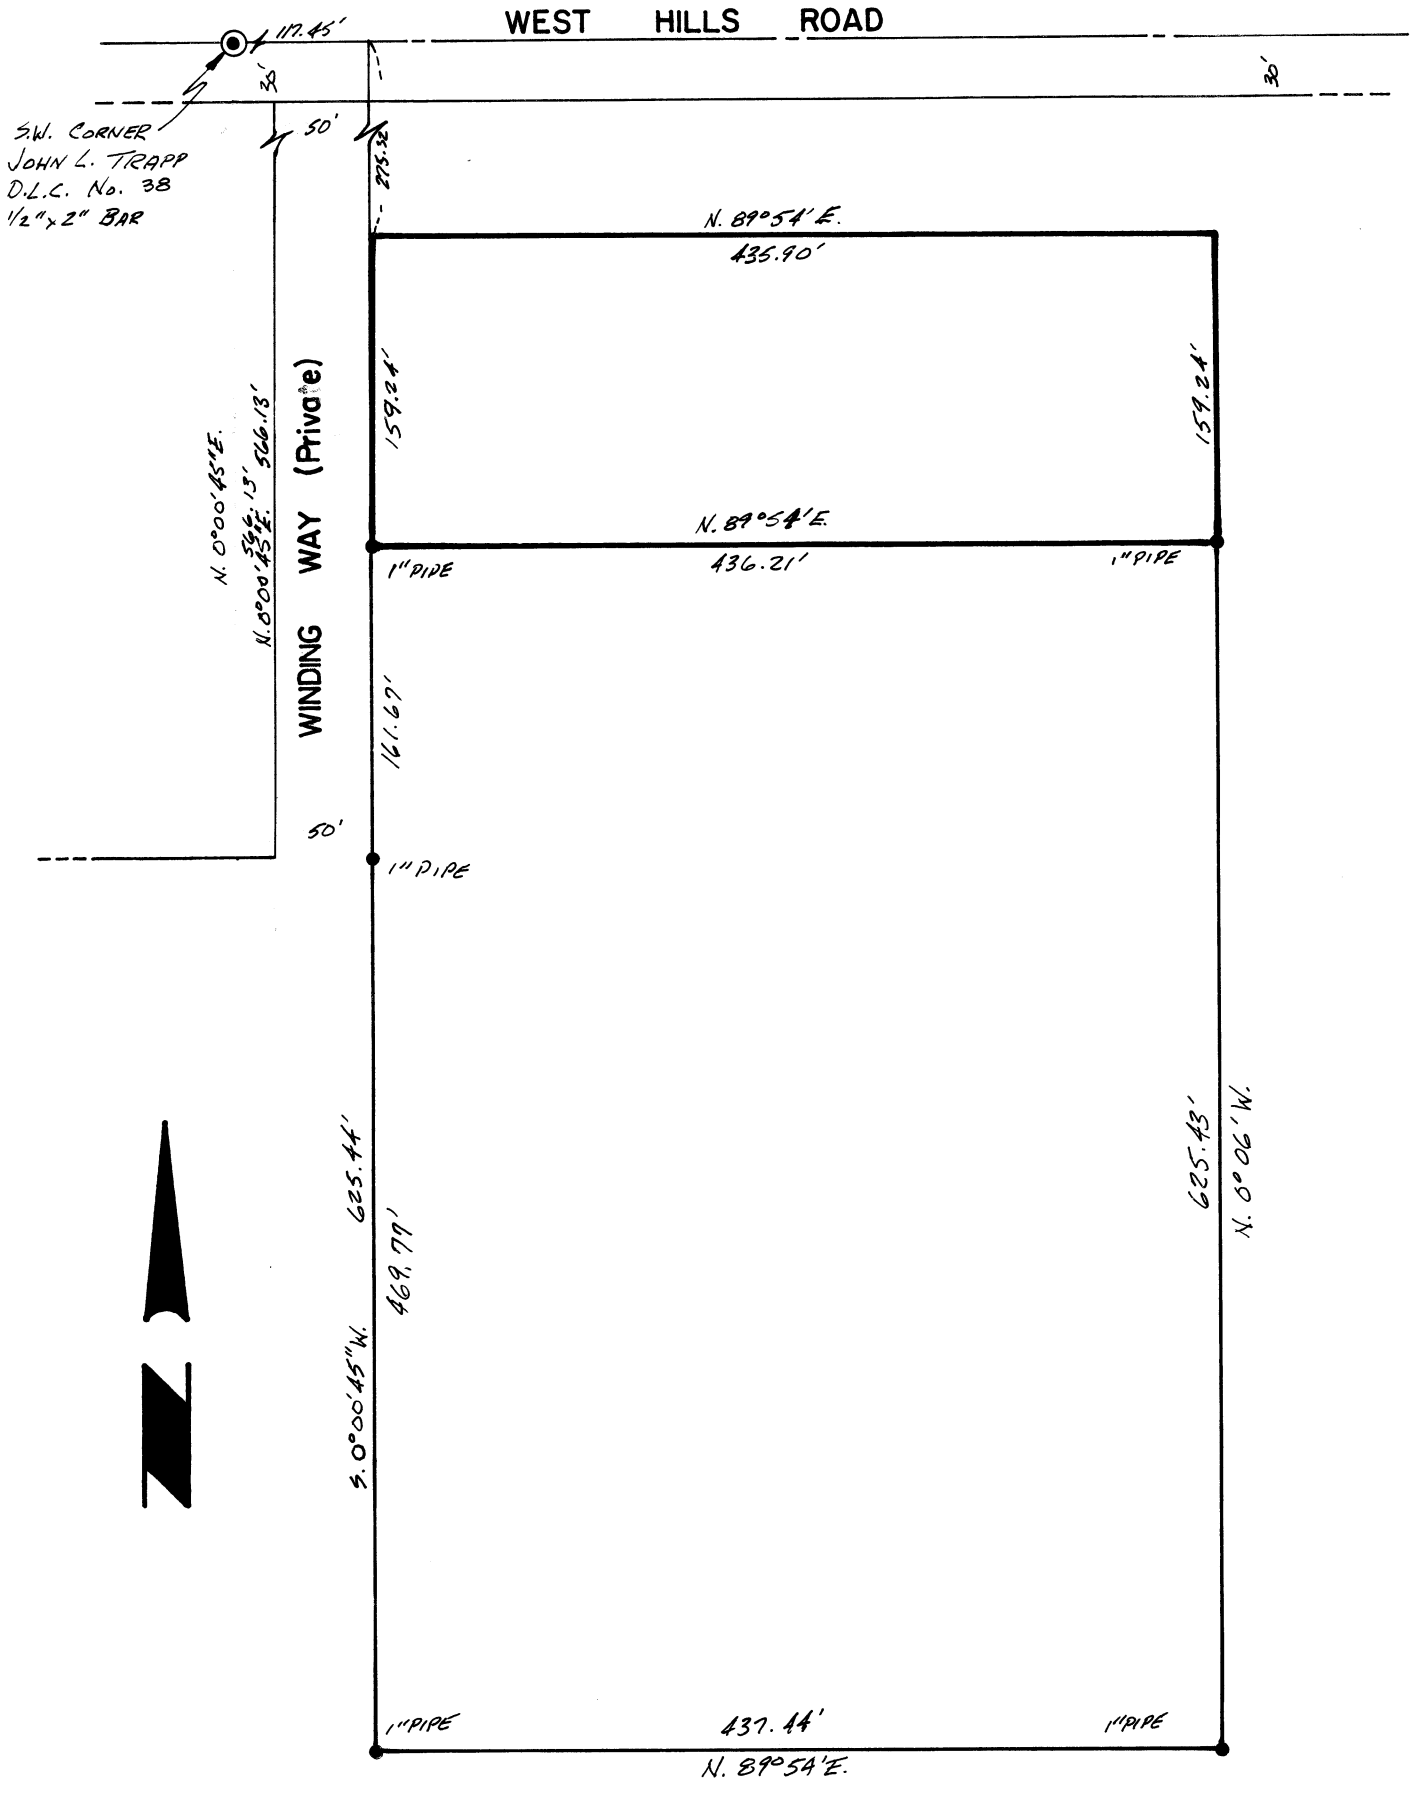

REGISTERED
PROFESSIONAL
LAND SURVEYOR

OREGON
MAY 8, 1968
FRED I. LENKE
443