661.7

661.7

Benton Co. Surveyors Office
C. S. FILE NO. _____
FILING DATE 5-17-78
FILE SIZE 16"

C.S. 134

DAVID R. SCHMIDT

E. 1/2 Sec. 11 & W. 1/2 Sec. 12
T. 10 S., R. 5 W., W.M.
Benton County, Oregon

Scale: 1" = 400' May 15, 1978

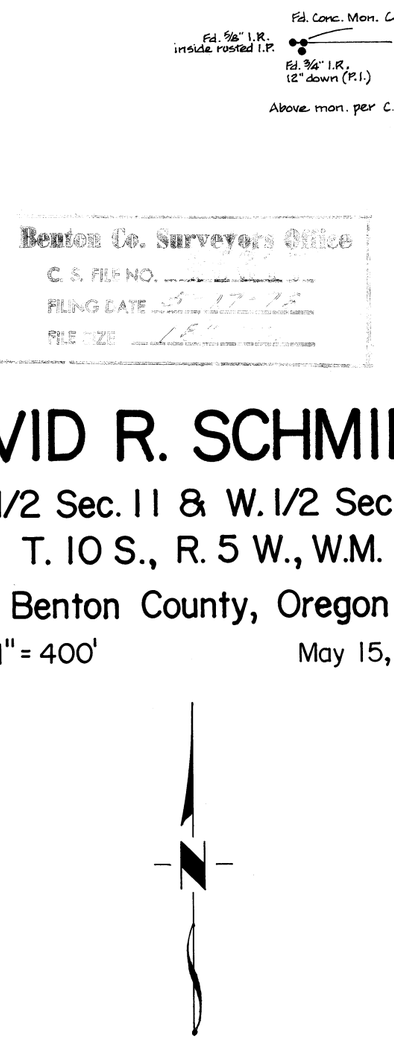

BASED ON BENTON/POLK COUNTY LINE SURVEY
(CIRCA 1930)

o Set 5/8" Iron Rod
• Found Monument as Indicated

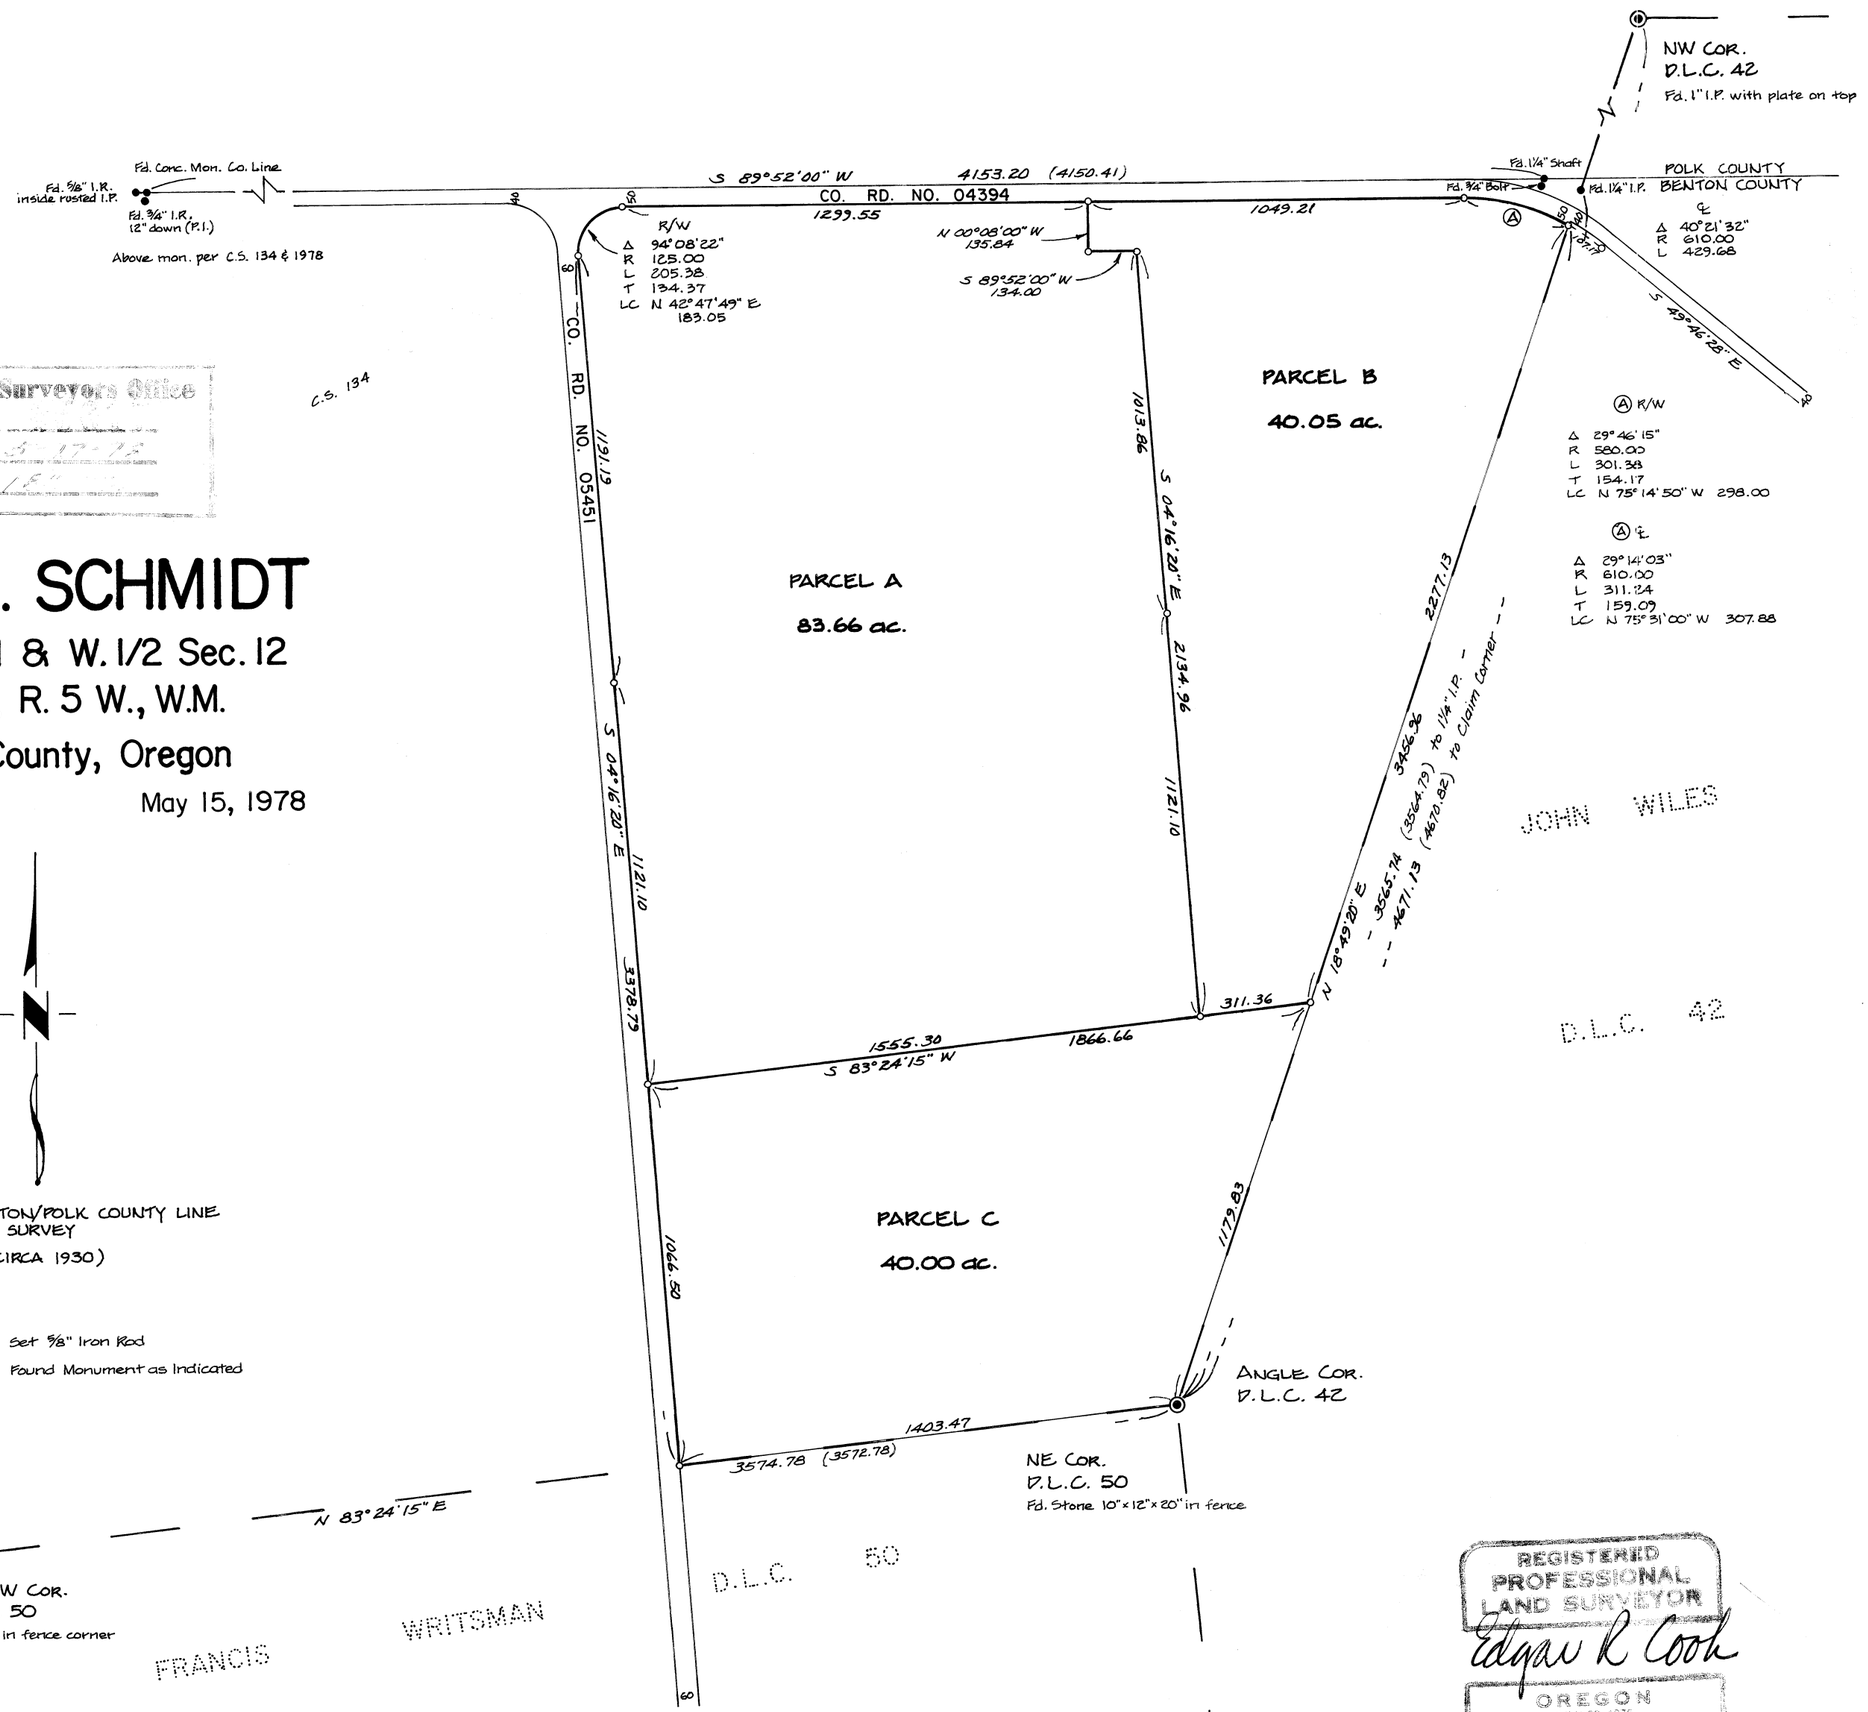

REGISTERED PROFESSIONAL LAND SURVEYOR
Edgar R Cook
OREGON
JULY 30, 1976
EDGAR R. COOK
1073

TIMBERLAND SERVICES, INC.
1600 Airport Road S. W., Suite 208
Albany, Oregon 97321
Telephone (503) 926-4281
LAND SURVEYING
LAND USE PLANNING
FORESTRY CONSULTING