RECORD OF SURVEY FOR WILLIAM BROWN IN NW¼, SE¼ SEC. 4 T. 12 S., R. 5 W., W. M., BENTON CO., ORE.

Benton Co. Surveyor's Office
C. S. FILE NO. 06641
FILING DATE 5-17-78
FILE SIZE 8½ x 14
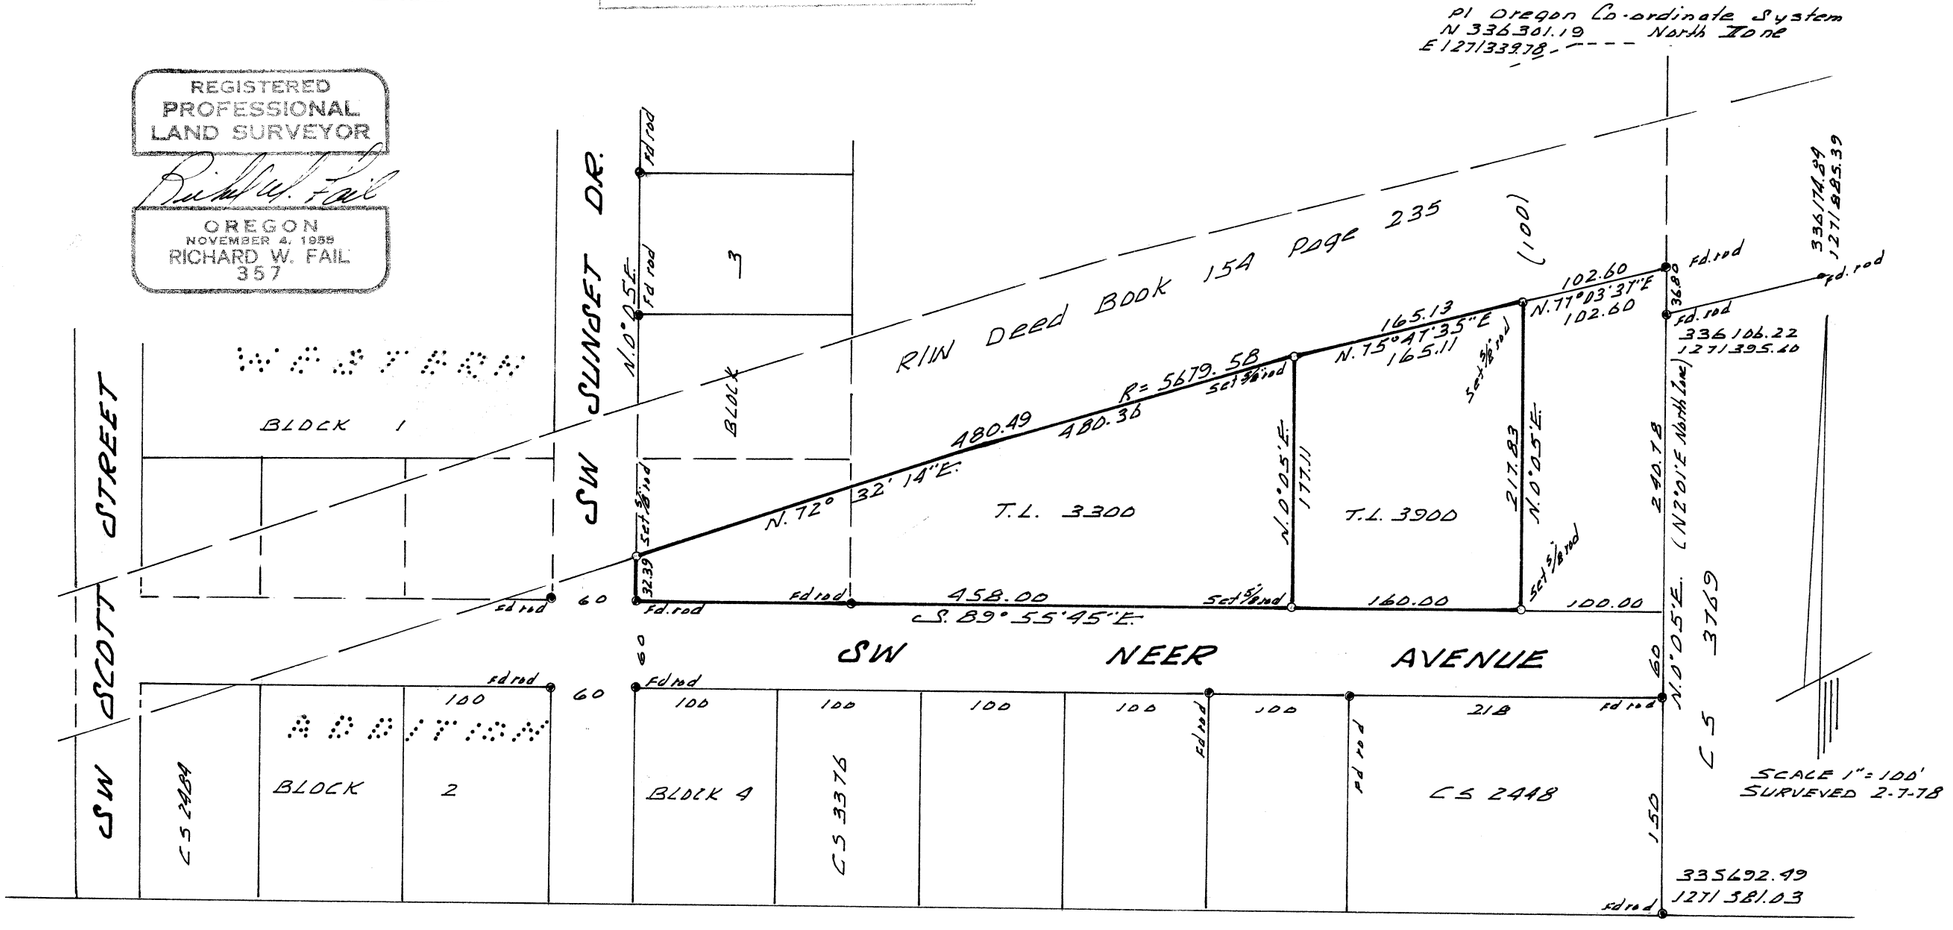
REGISTERED PROFESSIONAL LAND SURVEYOR
Richard W. Fail
OREGON
NOVEMBER 4, 1959
RICHARD W. FAIL
357