667 WILKINS ADDITION

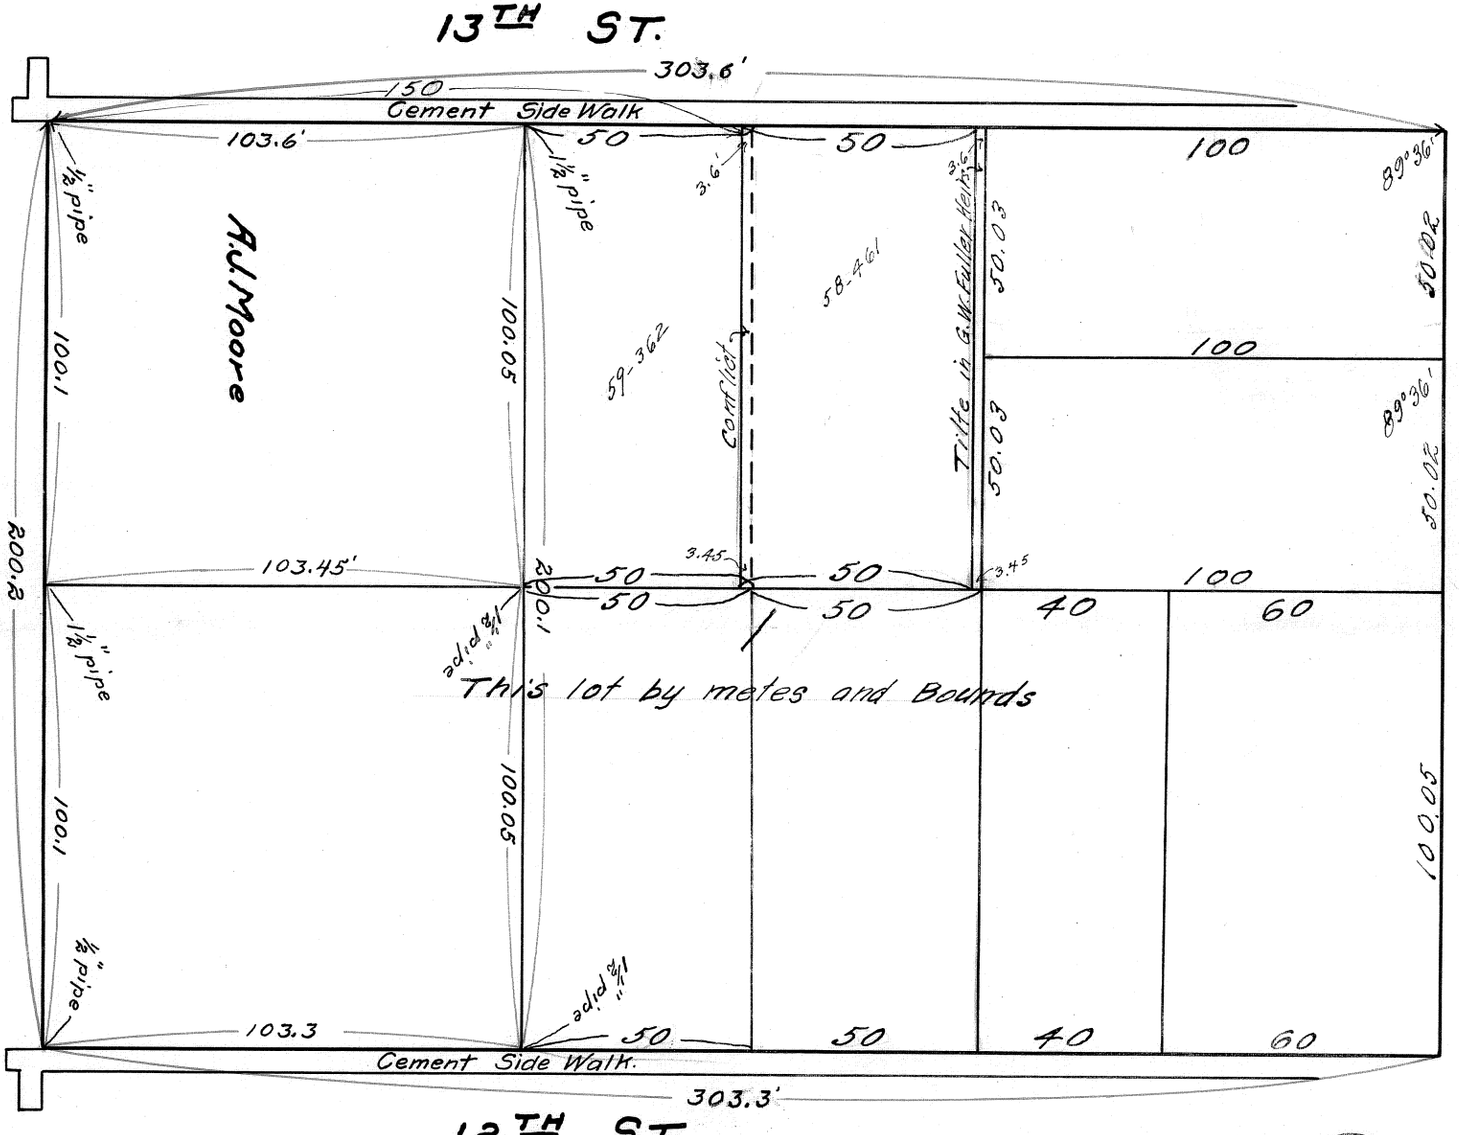

Sept. 24, 1919