Benton Co. Surveyors Office
C. S. FILE NO. 06720
FILING DATE 9-8-78
FILE SIZE 18"

# STARKER FORESTS

## SE 1/4 Sec. 4, T. 12 S., R. 6 W., W.M.
## Benton County, Oregon

Scale: 1" = 400'  August 23, 1978

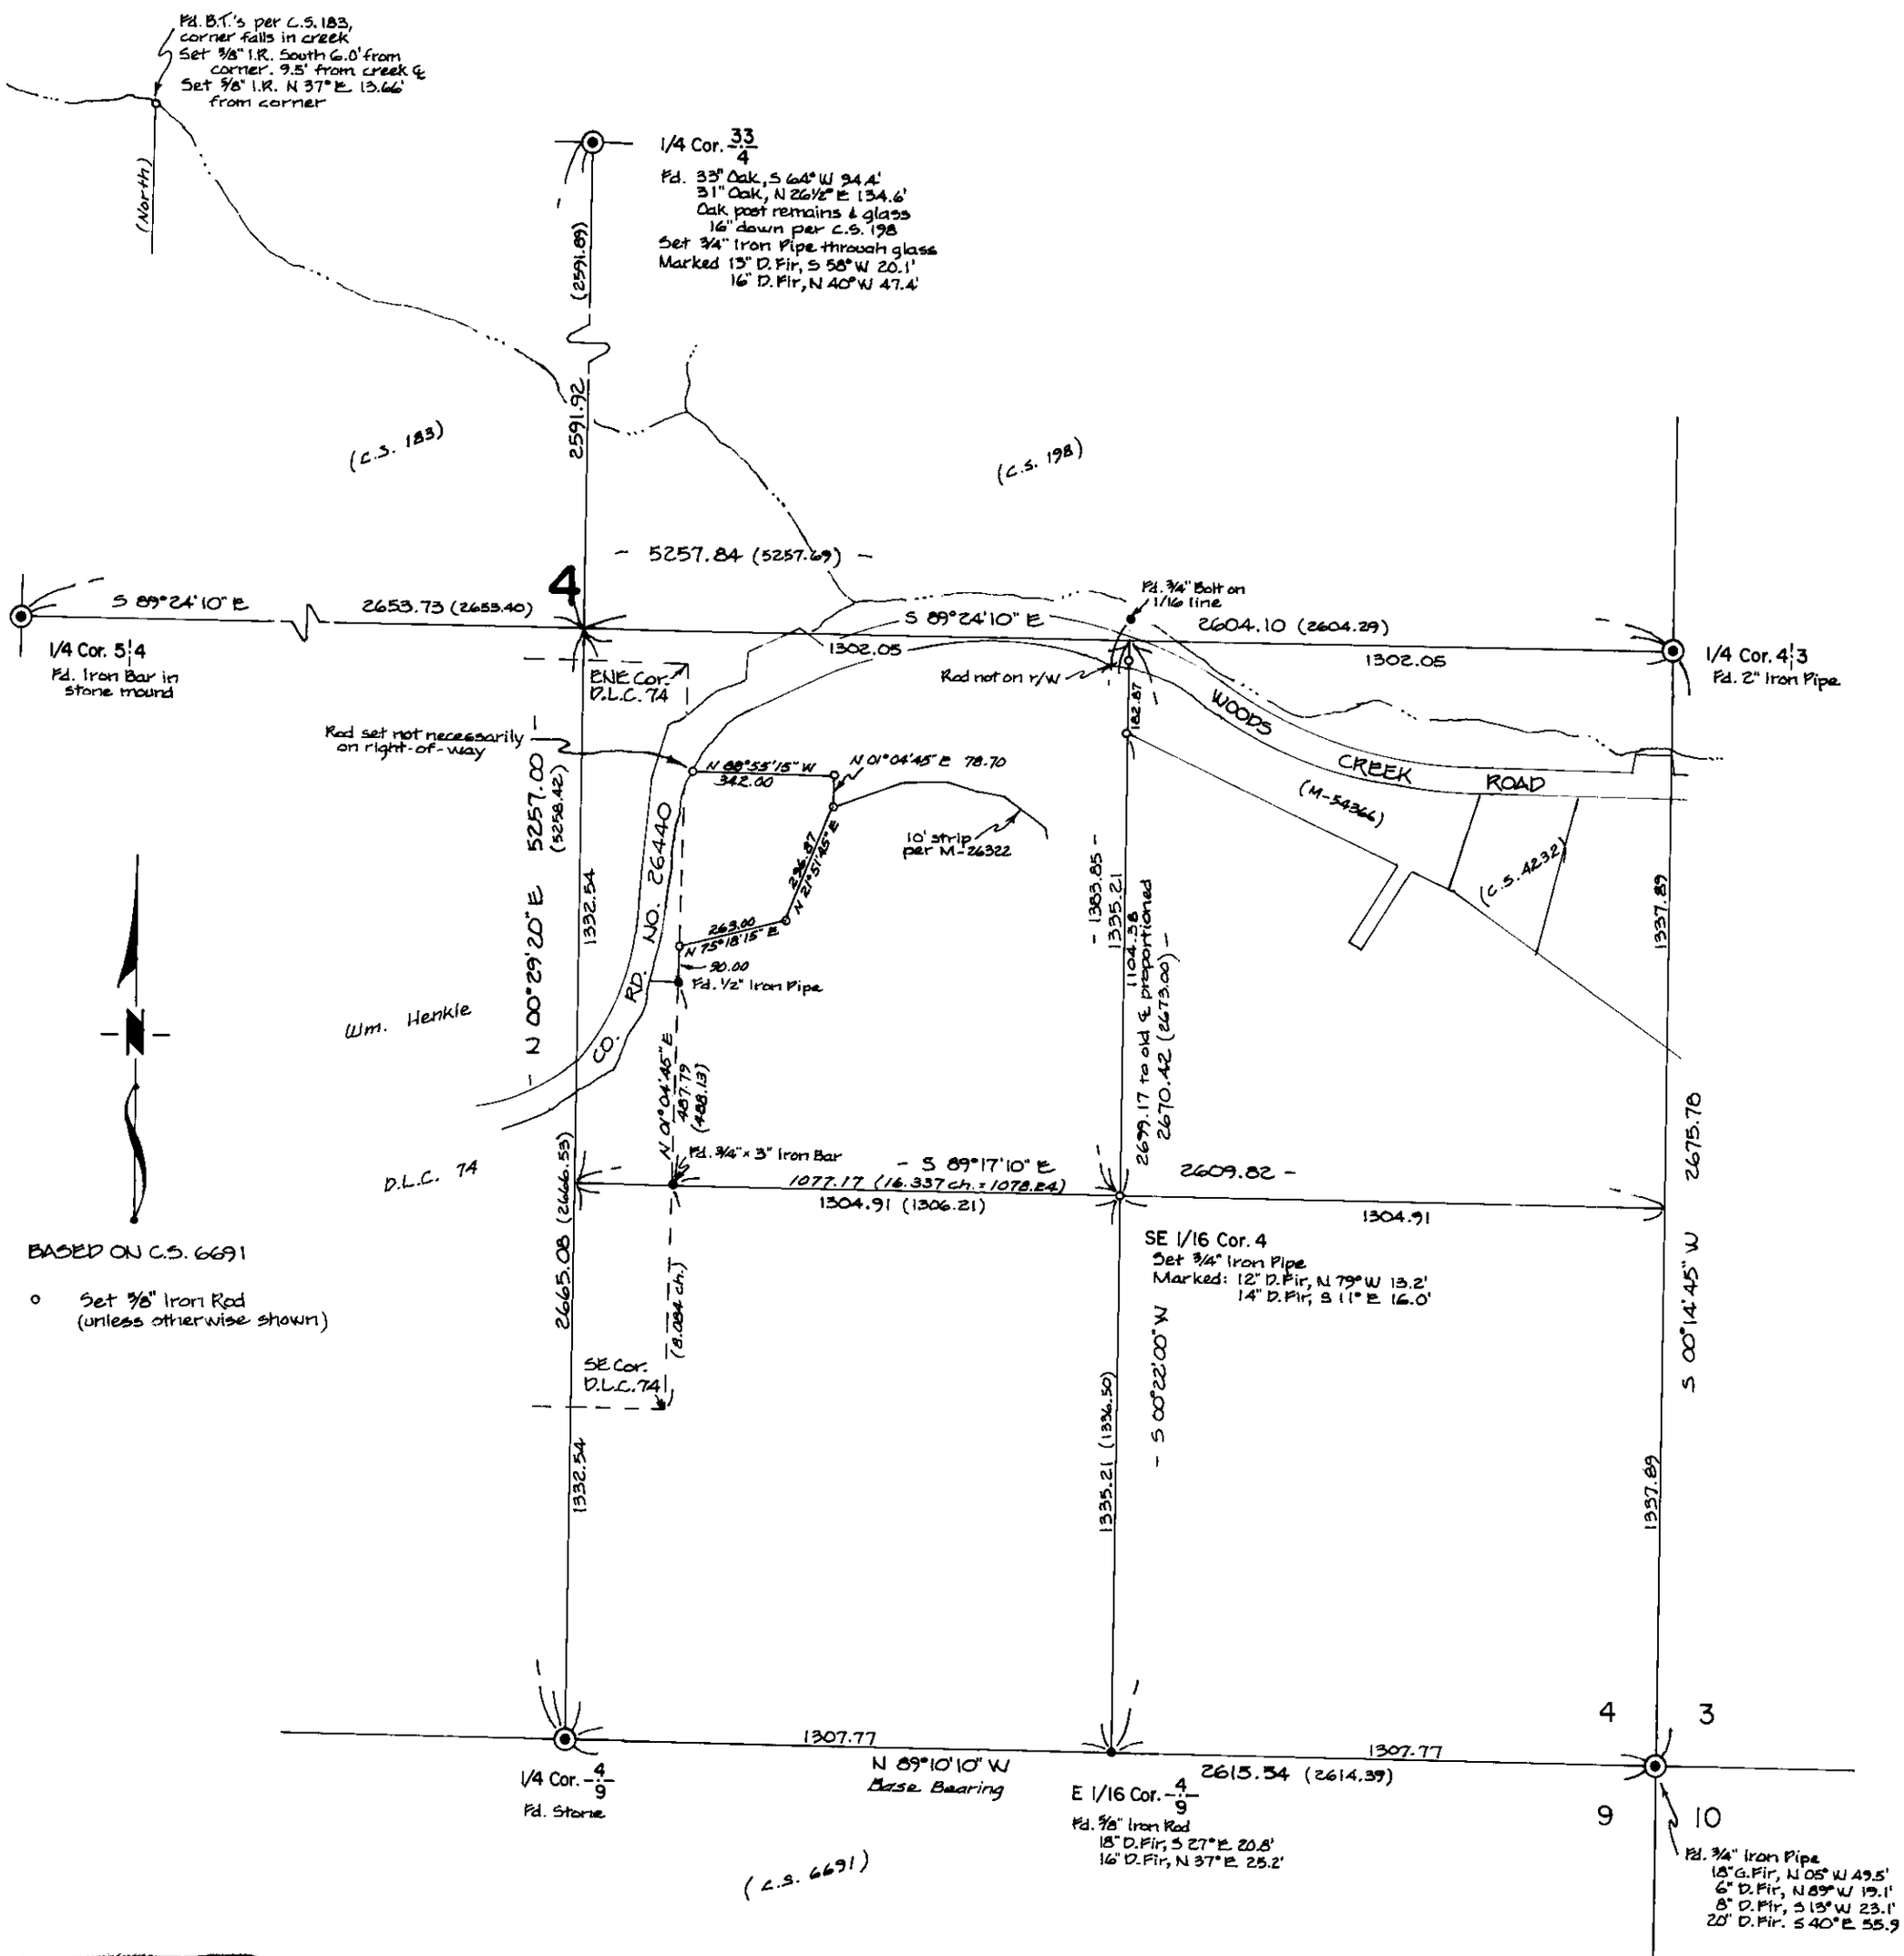


BASED ON C.S. 6691

○ Set 5/8" Iron Rod (unless otherwise shown)

REGISTERED PROFESSIONAL LAND SURVEYOR
Edgar R. Cook
OREGON
JULY 30, 1976
EDGAR R. COOK
1073

TIMBERLAND SERVICES, INC
1010 Airport Road P.O. Box 668
Albany Ore. 97321
Ph. (503) 926-9404
SURVEYING - ENGINEERING
LAND USE PLANNING
FORESTRY CONSULTING

06720