RECORD OF SURVEY

for DYER PROPERTIES

in S.W. ¼, S.E. ¼, SEC. 15,
T. 11S., R. 6W., W. M.
BENTON COUNTY, OREGON

NOVEMBER 15, 1978
SCALE: 1" = 100'

Benton Co. Surveyor's Office
C. S. FILE NO. 6794
FILING DATE 11-27-78
FILE SIZE 8½ x 14
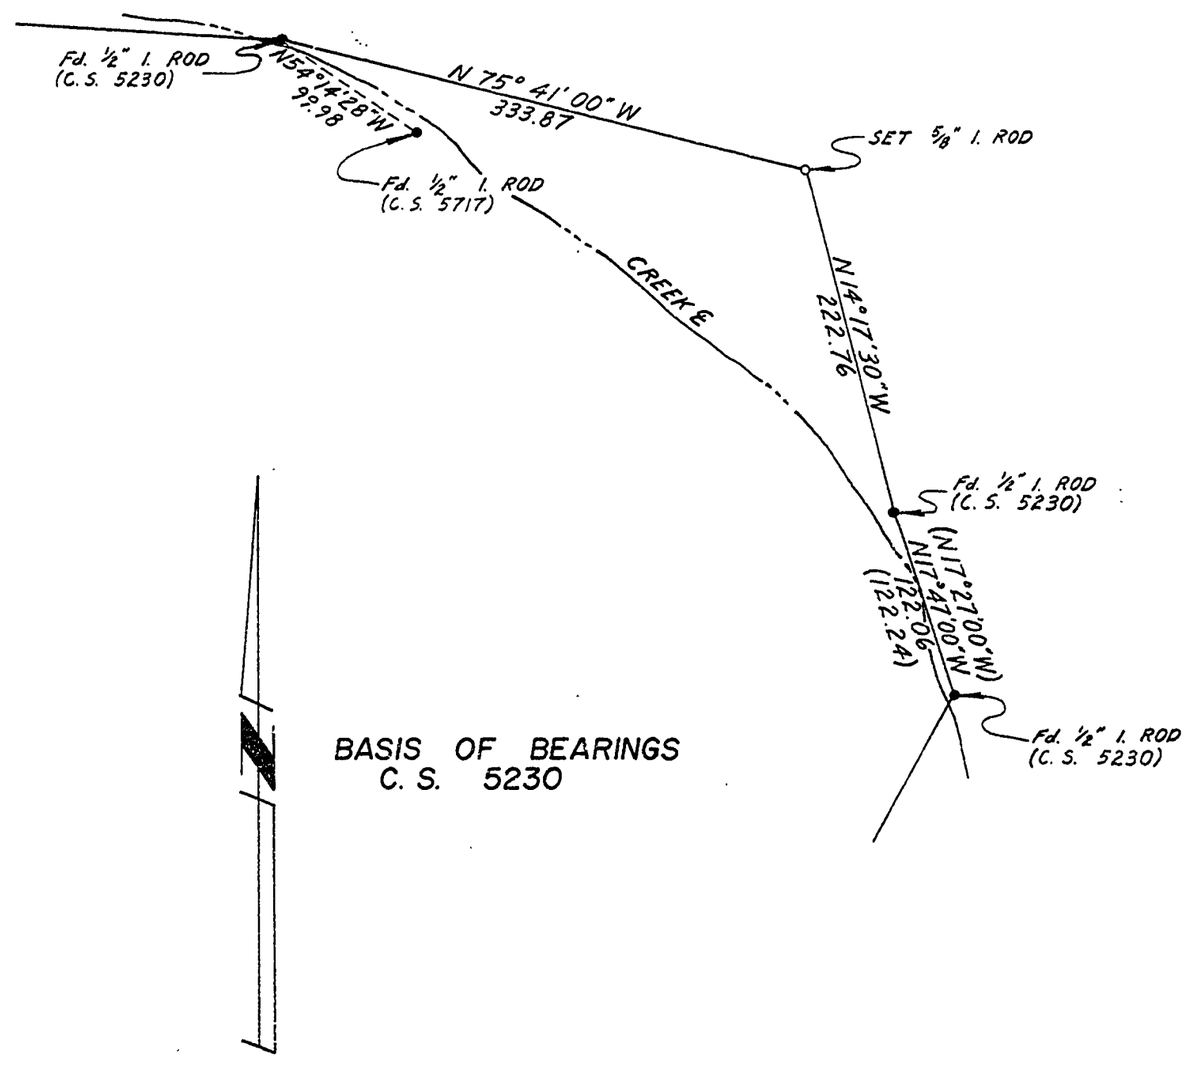
REGISTERED PROFESSIONAL LAND SURVEYOR
Norman D. Springer
OREGON
NORMAN D. SPRINGER