


1
2
1" = 6 CHAINS

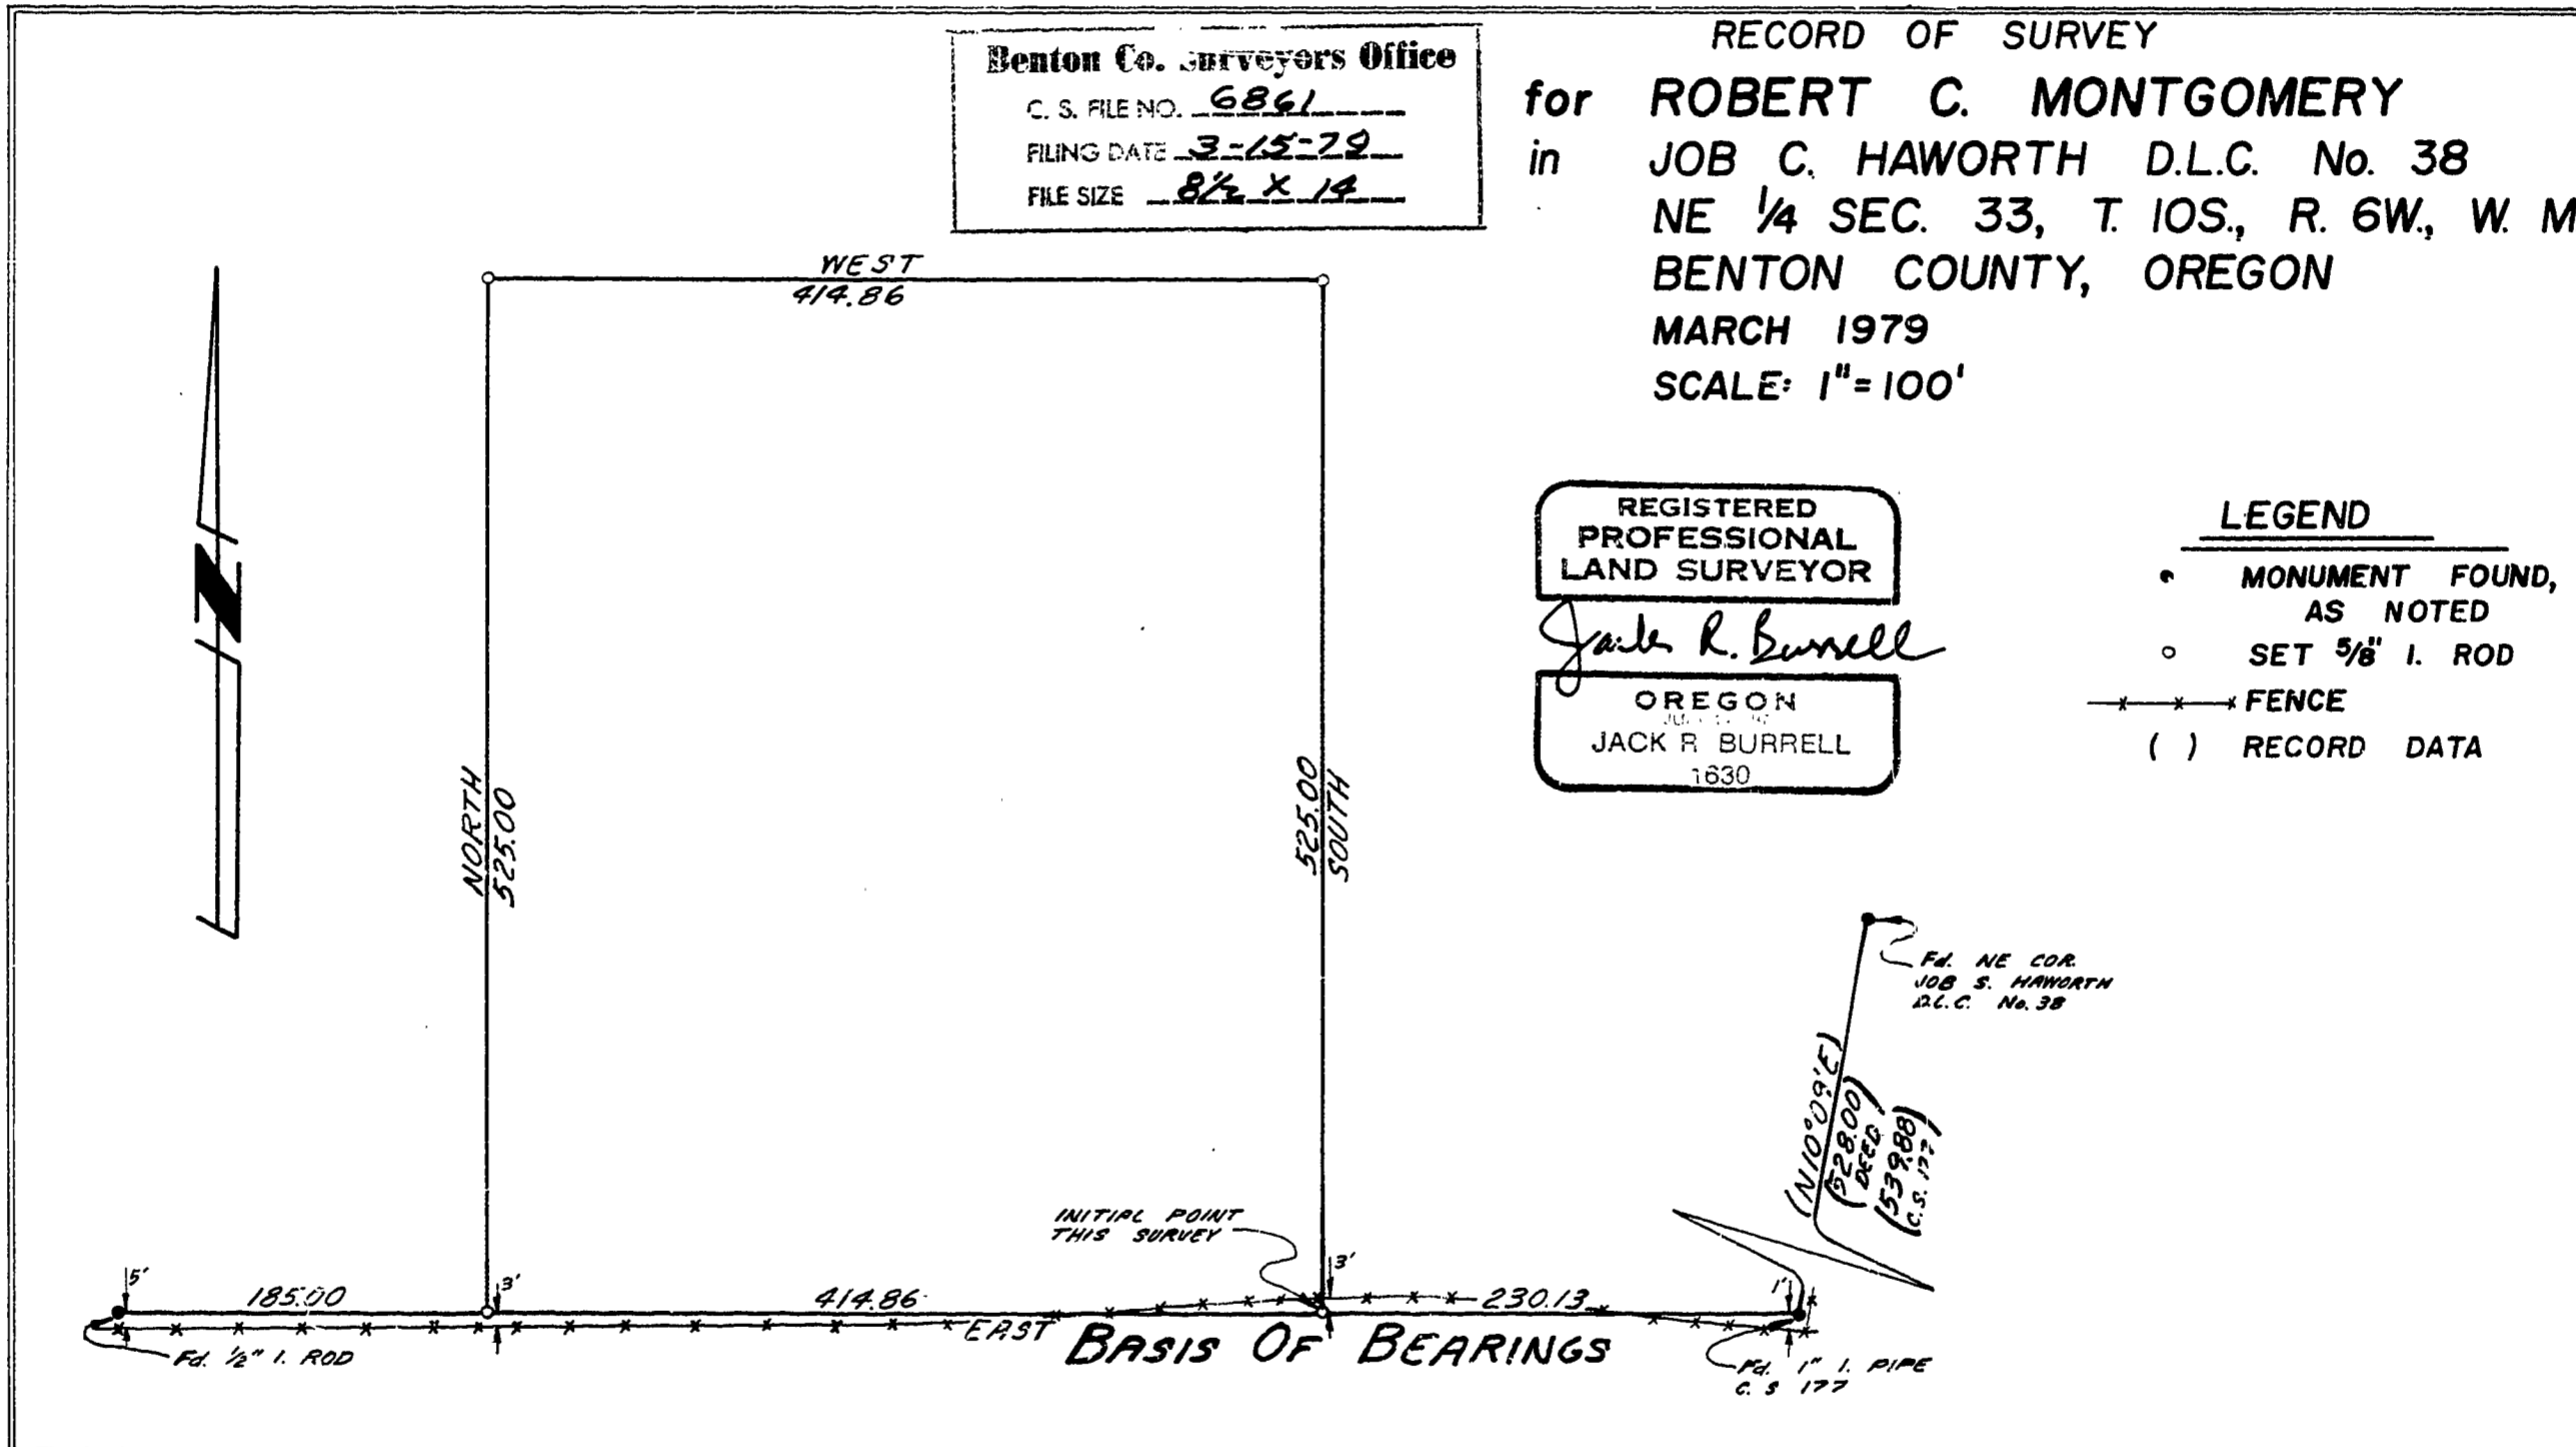

REF 3 FRAME 89