7187

JOHN DILLARD

N.E 1/4 SEC. 33, T. 14S, R. 5 W.W.M.
MONROE, BENTON CO, OREGON
NOV 21, 1980 SCALE 1"= 50'

Benton County
Surveyor's Office
C. S. FILE NO. 7187
FILING DATE 12-22-1980
FILE SIZE 14"x18"

RECEIVED
LAND DEV.
R. S. CASTLEBERRY
P.O. BOX 384 HARRISBURG, OR.
ORIG.
RESURV.
ADD.

— LEGEND —

- ○ 1/2" IRON ROD SET (24" LONG)
- ● MONUMENT SHOWN ON CS 4138 & FOUND IN PLACE.
- OLD FENCE LINE

NARRATIVE: THE EXTERIOR BOUNDRY OF THIS SURVEY IS BASED ON CS 4138 (SEE LEGEND). ALL OTHER NARRATIVE DATA IS ON THIS MAP.

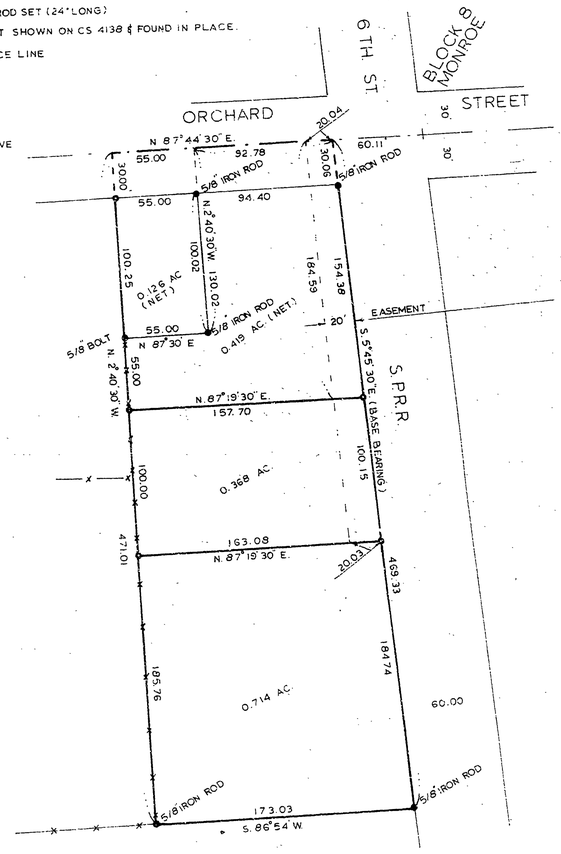

7187