Map of Survey for

# Clifford Gee

in the Norris P. Newton Donation Land Claim No. 44 ~~& 72~~
SE¼, Sec. 12, Township 12 South, Range 6 West and
~~SW¼, Sec. 7, Township 12 South, Range 5 West~~
of the Willamette Meridian,
Philomath, Benton County, Oregon
Scale 1" = 30' September 20, 1981

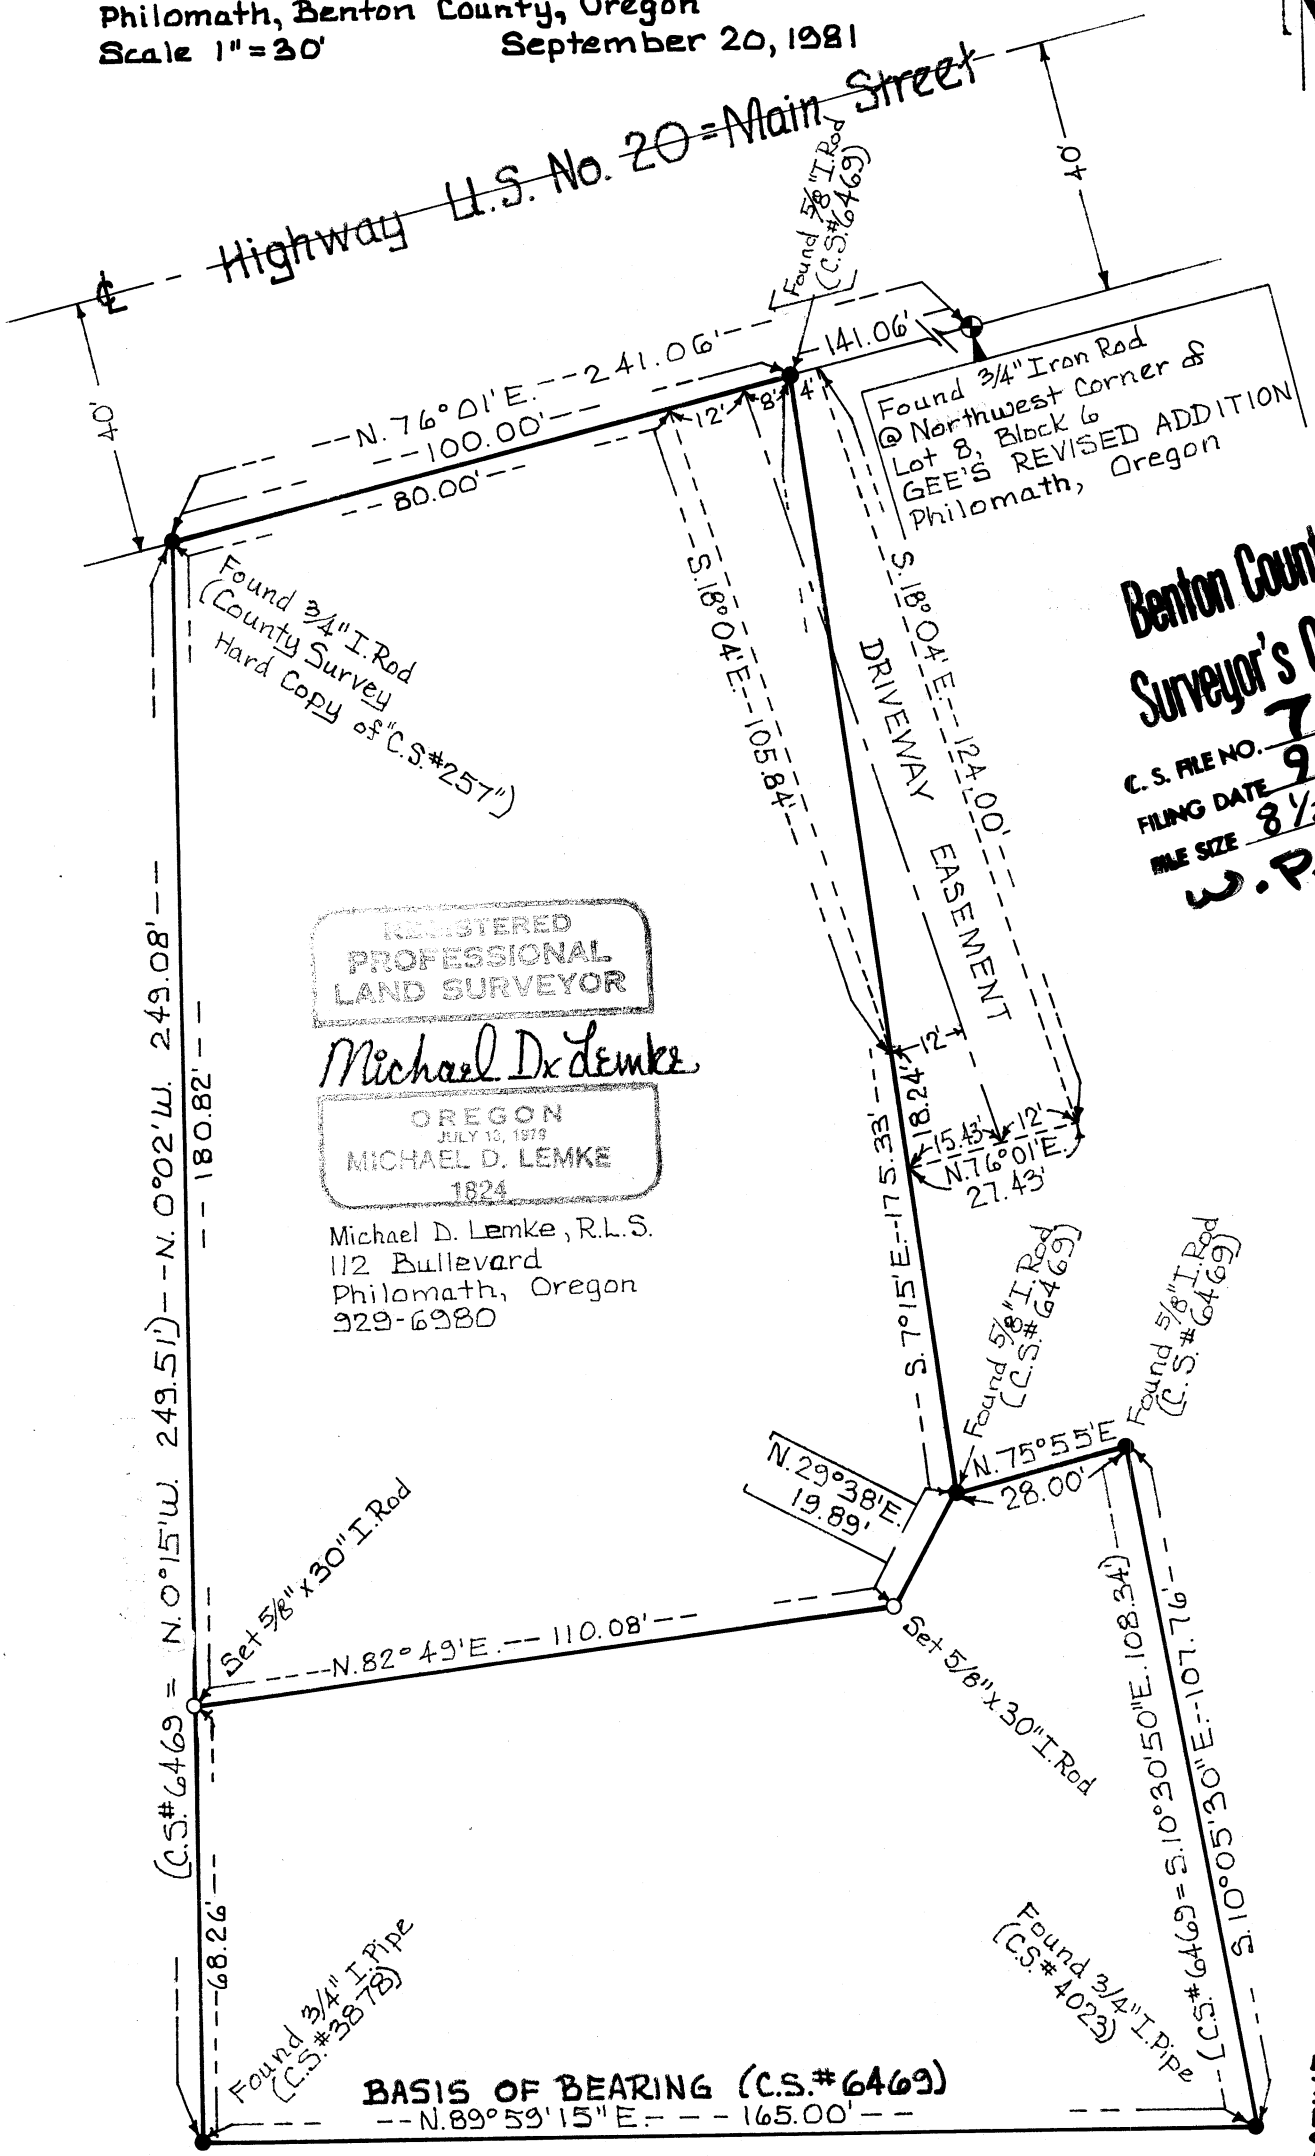


REGISTERED PROFESSIONAL LAND SURVEYOR
Michael D. Lemke
OREGON JULY 13, 1979 MICHAEL D. LEMKE 1824


Michael D. Lemke, R.L.S.
112 Bullevard
Philomath, Oregon
929-6980



Benton County
Surveyor's Office
C. S. FILE NO. 7323
FILING DATE 9-21-1981
FILE SIZE 8½ x 14
W.P.


**NARRATIVE:**

The Purpose of this Survey was to Set New Monuments As Shown To Allow the Hereon Shown Division Line To Be Documented For City of Philomath Minor Land Partition Purposes. All Control (Found) Monuments Were Tied Into And All New (Set) Monuments Were Set From A Closed Random Traverse. County Survey No. 6469 Was Used As Reference.