7333

DRAWING NUMBER 7333

PLAN HOLD CORPORATION • IRVINE, CALIFORNIA
REORDER BY NUMBER 075AR

SURVEY FOR FRANCIS WONDERLY

S.W. 1/4 SEC. 19, & N.W. 1/4 SEC. 30, T.12 S.R. 5W. W.M.

ALEXANDER LIGGETT D.L.C. NO. 63

TAX LOT 501, BENTON COUNTY, OREGON

SEPTEMBER 14, 1981

Scale : 1 inch = 100 feet
1 chain = 66 feet
Corners found ●
Corners set o 5/8"x30" I.R.
Basis – C.S. #288 – Galloway 1934
Party chief - Chuck Gibbs
Drawn By - Chuck Gibbs

JAMES F. UDELL
ENGINEERING & SURVEYING
32388 BERLIN ROAD
LEBANON, OREGON 97355
PH. (503) 451-5125

Narrative:

Iron rod was set by intersection of distances from irons found to east and south. Per C.S. #288 (Galloway Survey in 1934) and Deed number M-26788 (August 26, 1971.) Corner was established to determine line for fence between property owners. Basis of bearing was C.S. #288 (Galloway 1934, in T12S,R6W) J.U. 12/7/81
A Jena 1 minute theodolite and Mac HE E.D.M. were used for equipment.

REGISTERED PROFESSIONAL LAND SURVEYOR
Jim Udell
OREGON
SEPT. 23, 1977
JIM UDELL
1366

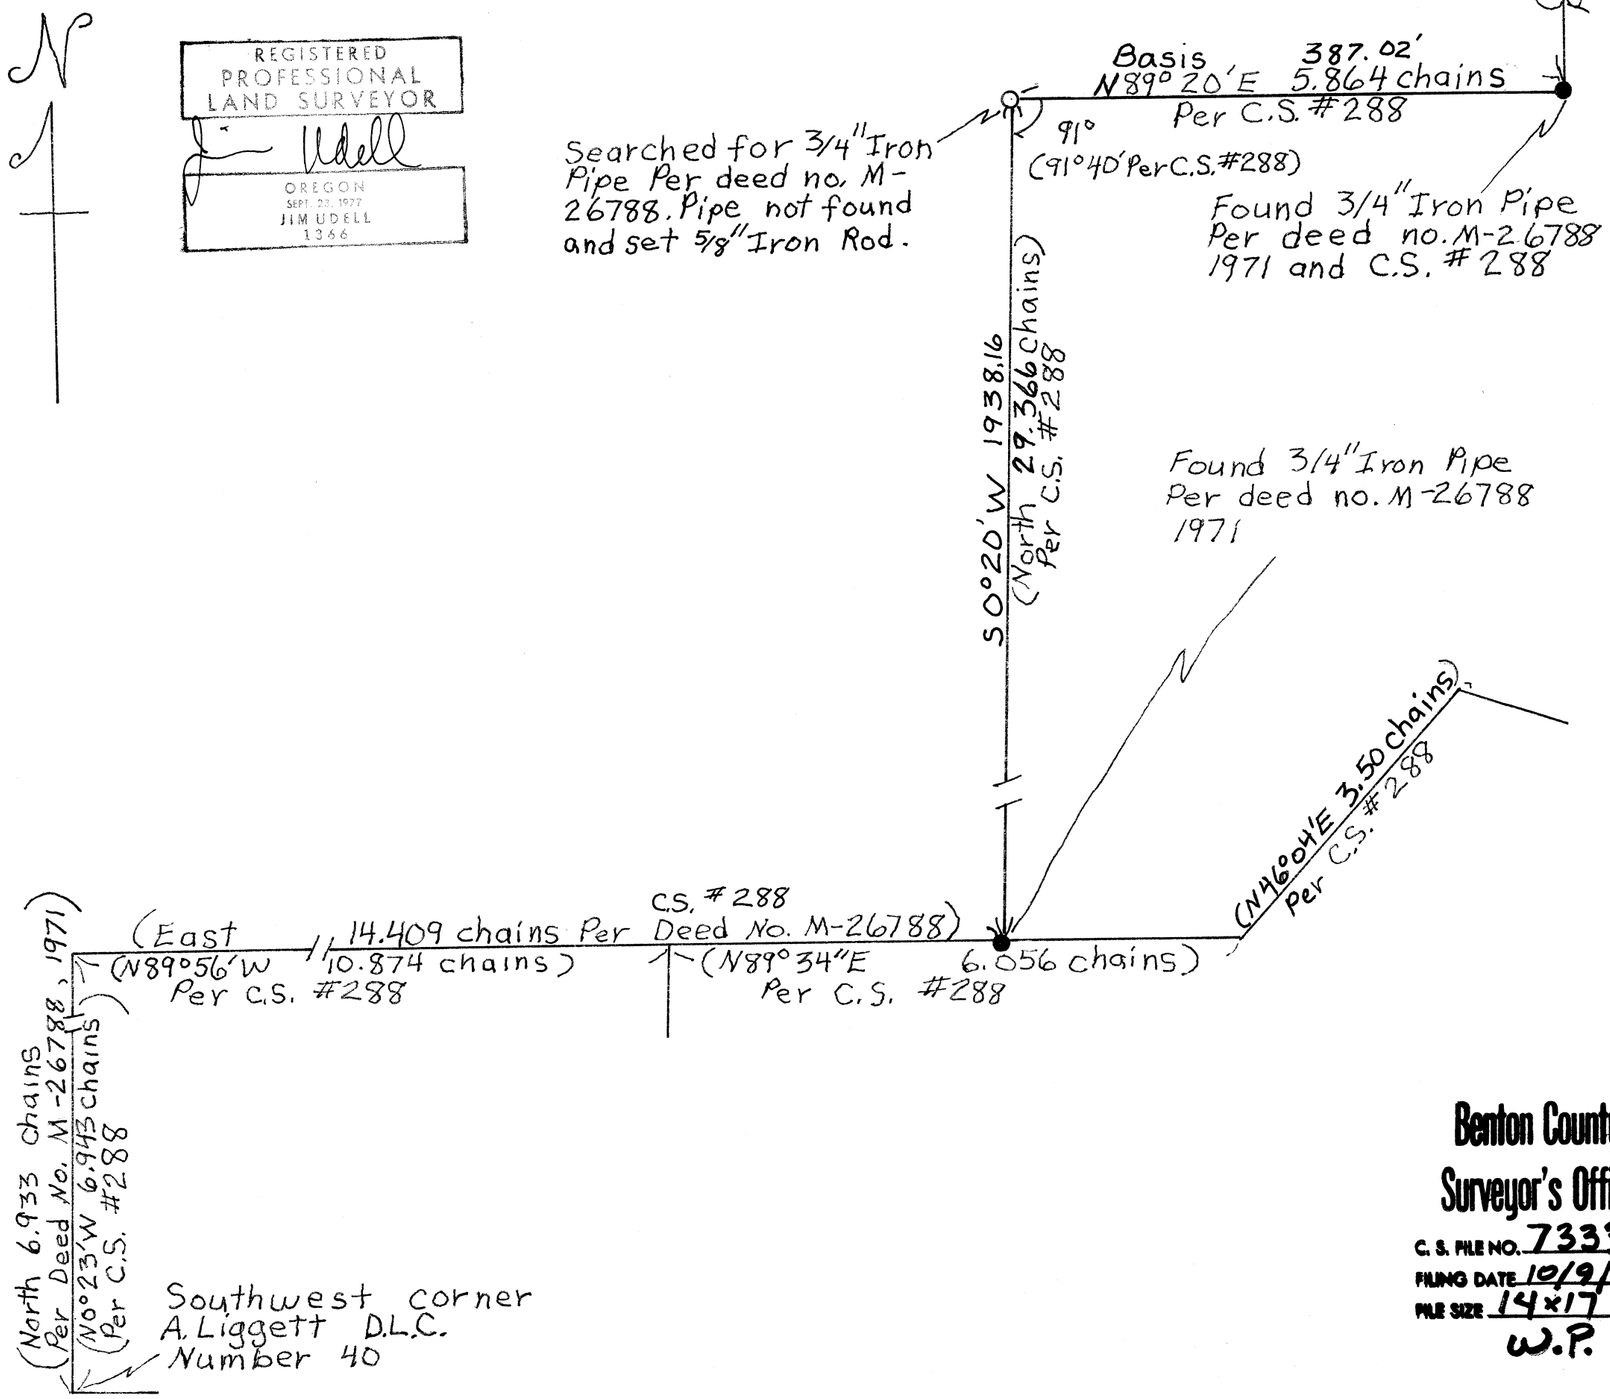

Benton County Surveyor's Office
C. S. FILE NO. 7333
FILING DATE 10/9/81
FILE SIZE 14x17
W.P.

7333

DRAWING NUMBER 7333

PLAN HOLD CORPORATION • IRVINE, CALIFORNIA
REORDER BY NUMBER 075AR

7333