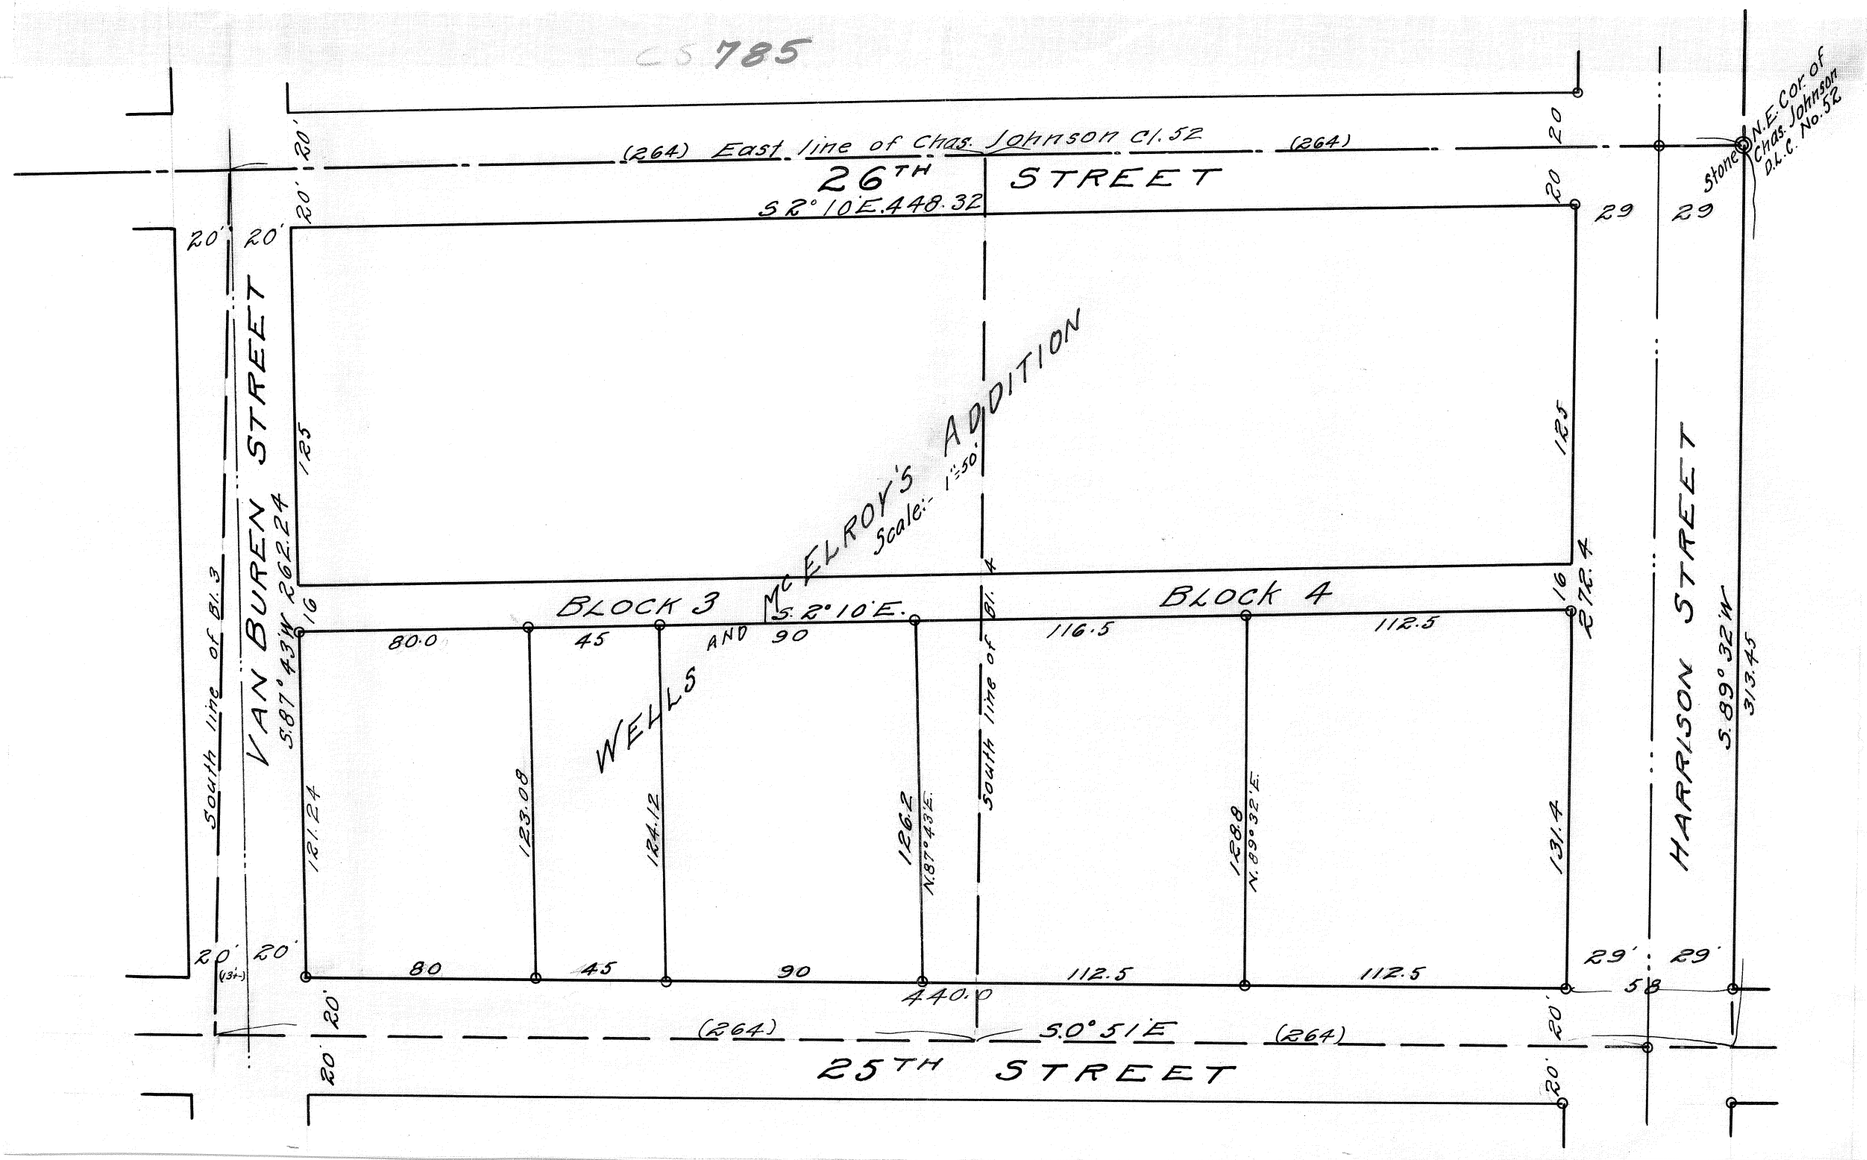
CS 785
(264) East line of Chas. Johnson Cl. 52 (264)
26TH STREET
S 2° 10' E. 448.32
Stone N.E. Cor. of Chas. Johnson D.L.C. No. 52
VAN BUREN STREET
South line of Bl. 3
S. 87° 43' W 262.24
McELROY'S ADDITION
Scale:- 1"=50'
BLOCK 3
BLOCK 4
S. 2° 10' E.
WELLS AND
South line of Bl. 4
HARRISON STREET
S. 89° 32' W 313.45
272.4
80.0
45
90
116.5
112.5
121.24
123.08
124.12
126.2
N. 87° 43' E.
128.8
N. 89° 32' E.
131.4
80
45
90
112.5
112.5
440.0
(264) S. 0° 51' E (264)
25TH STREET