B - 91

A. H. JONES

THIS SURVEY RECEIVED OCT. 1986
FROM LINN CO. SURVEYORS OFFICE

Lot 2, Bl. 1, Orchard Park Subdivision
Sec. 31, T.10 S., R.3 W., W.M., Benton County, Oregon
Scale: 1" = 30' September 17, 1962

Orris A. Carnegie
Reg. Oregon Land Surveyor

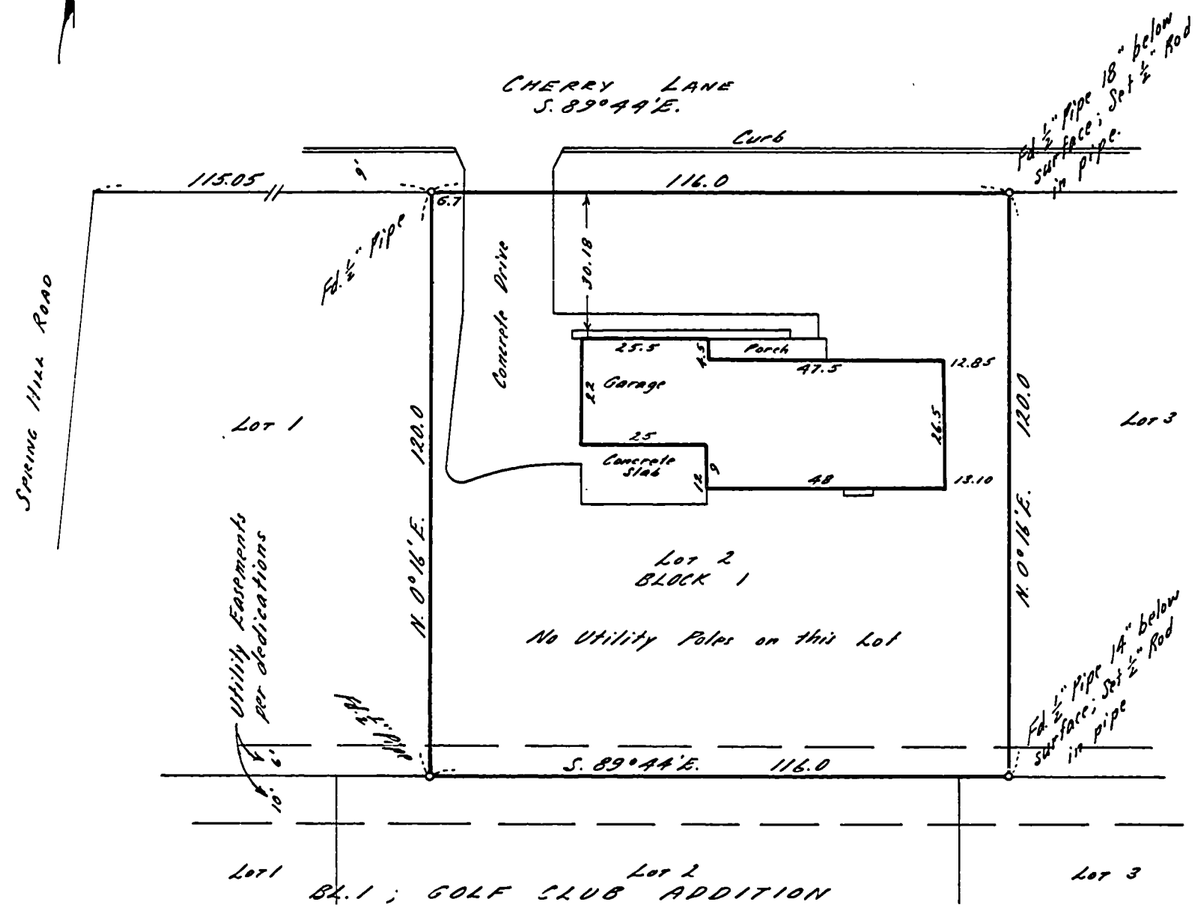

Description: Lot 2, Block 1, ORCHARD PARK SUBDIVISION in Section 31, T.10 S., R.3 W., W.M., Benton County, Oregon.

Certificate: I hereby certify that I have surveyed the herein described property and that I find the improvements set thereon to be on the premises in question and that they do not overlap or encroach on the property adjacent thereto.

REGISTERED
OREGON
LAND SURVEYOR
Orris A. Carnegie
MAY 9, 1947
ORRIS A. CARNEGIE
213

Benton County
Surveyor's Office
C. S. FILE NO. 7866
FILING DATE 7-14-86
FILE SIZE 8½ x 14

REEL 10 FRAME 026