B - 116

THIS SURVEY RECEIVED OCT. 1985
FROM LINN CO. SURVEYORS OFFICE

DARREL D. CLEVELAND

Lot 3, Bl. 1, Terra Lynda Subdivision
Benton County, Oregon
Scale: 1" = 30'

January 26, 1970
Orris A. Carnegie, Reg. Ore. Land Surveyor
By: G. W. Strandt

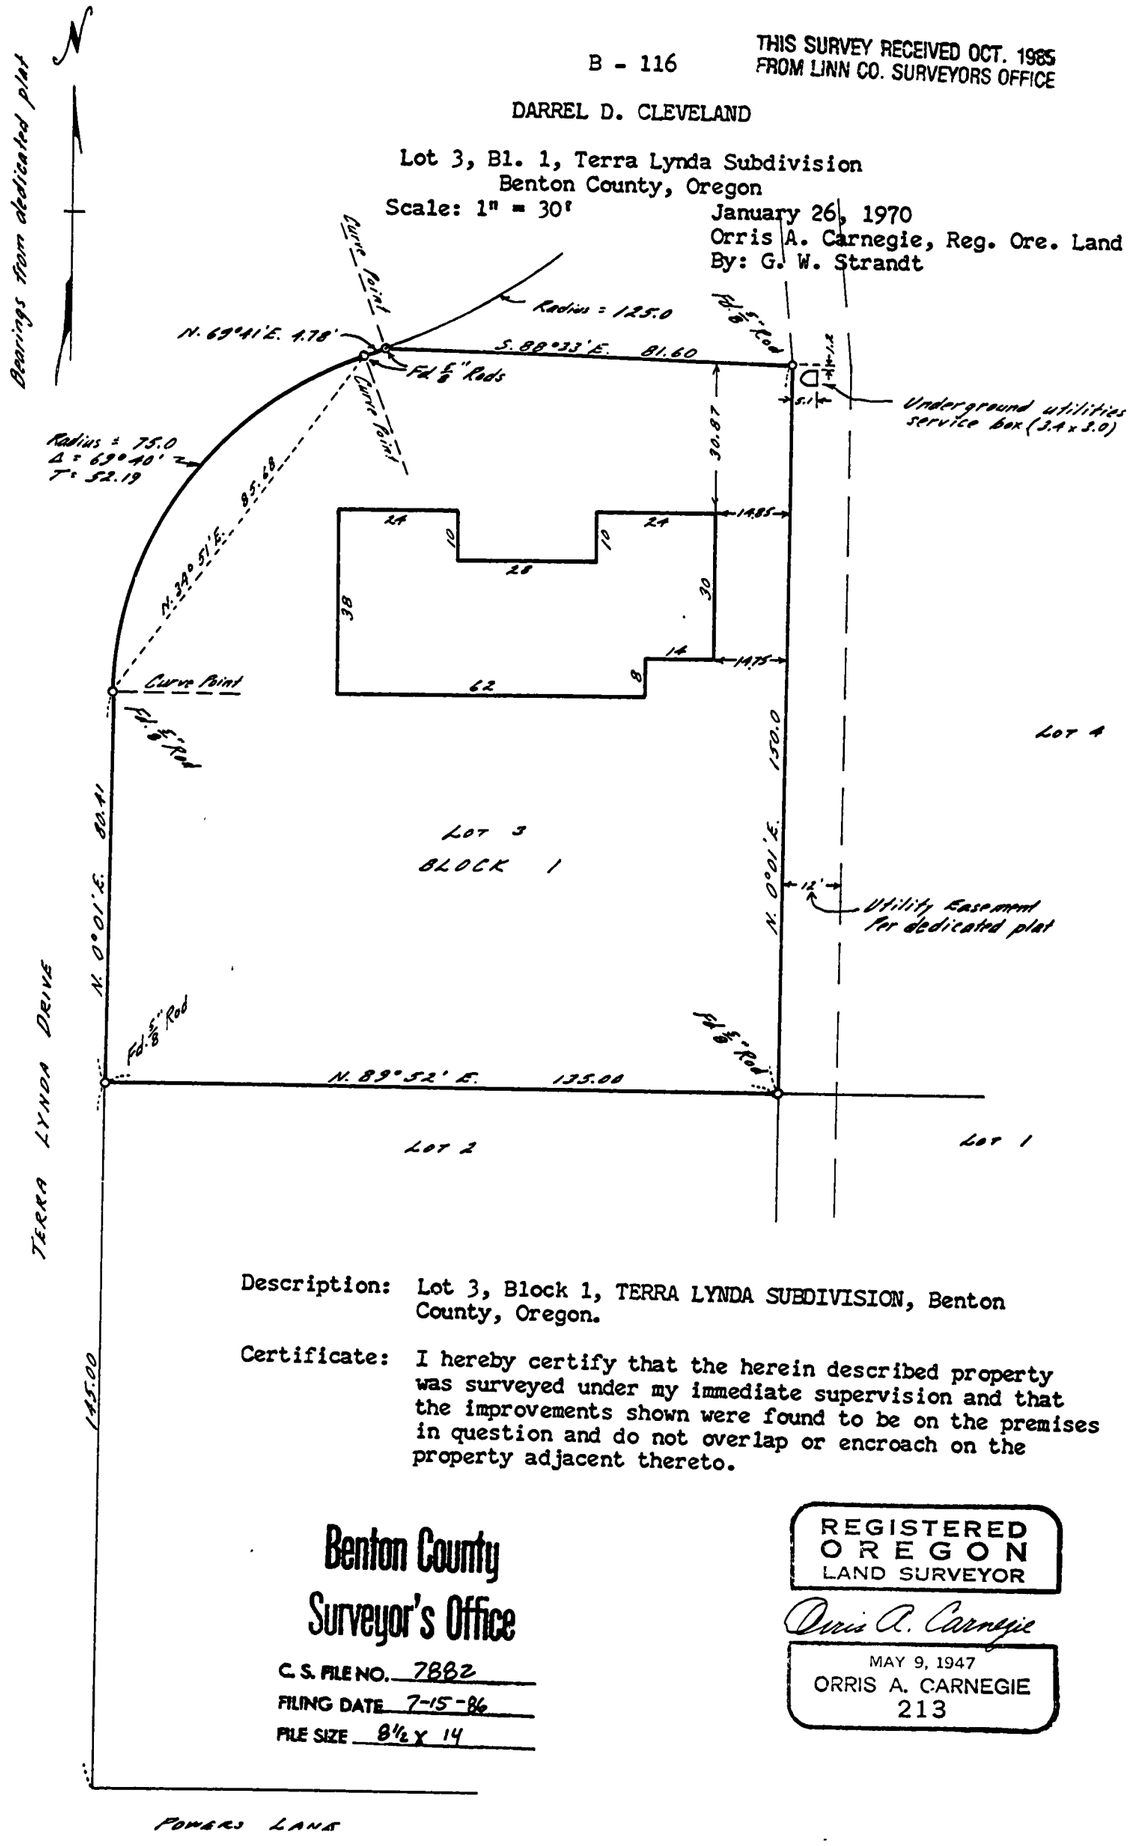

Description: Lot 3, Block 1, TERRA LYNDA SUBDIVISION, Benton County, Oregon.

Certificate: I hereby certify that the herein described property was surveyed under my immediate supervision and that the improvements shown were found to be on the premises in question and do not overlap or encroach on the property adjacent thereto.

Benton County Surveyor's Office

C. S. FILE NO. 7882
FILING DATE 7-15-86
FILE SIZE 8½ x 14

REGISTERED
OREGON
LAND SURVEYOR

Orris A. Carnegie

MAY 9, 1947
ORRIS A. CARNEGIE
213

REEL 10 FRAME